



#2256

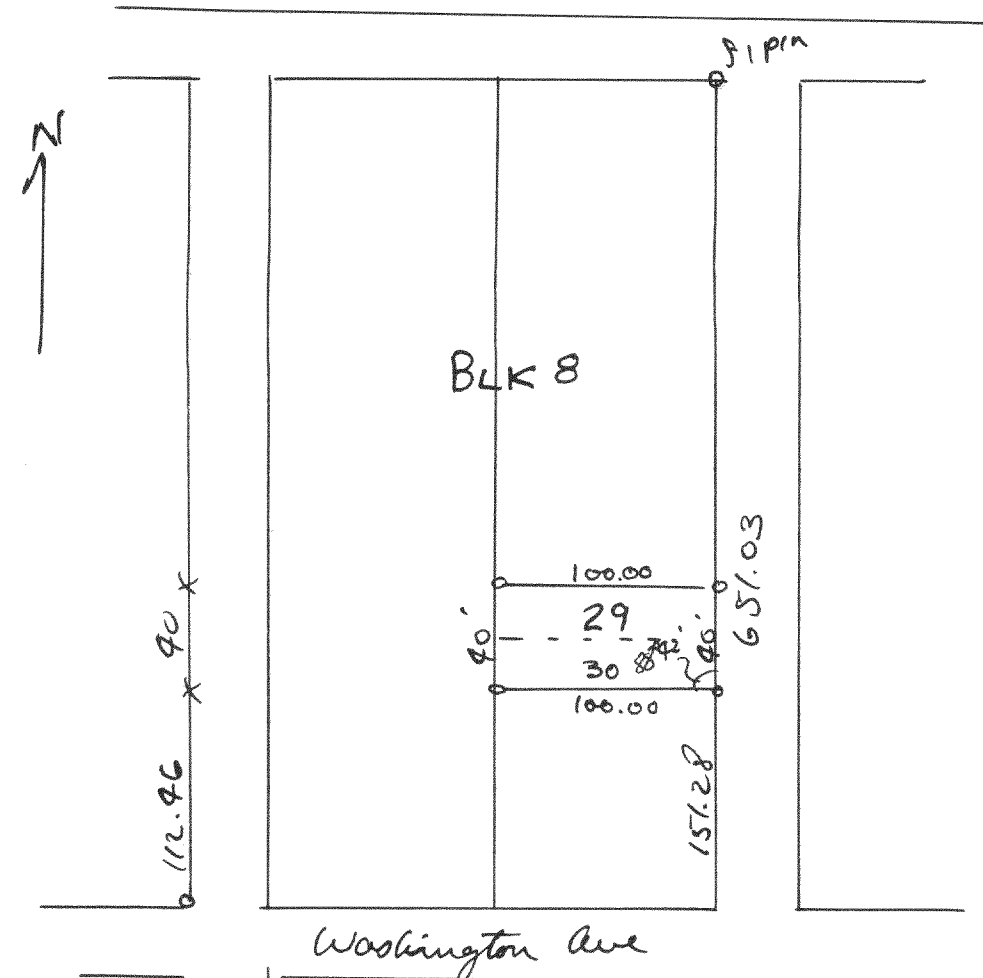


Plat of survey of lots 29, 30 Blk 8 of Lake Ivanhoe Resort located in Sec 2, T1N R18E of Walworth County, Wis., July 1950
 Floyd S. Jensen
 County Surveyor

#2258

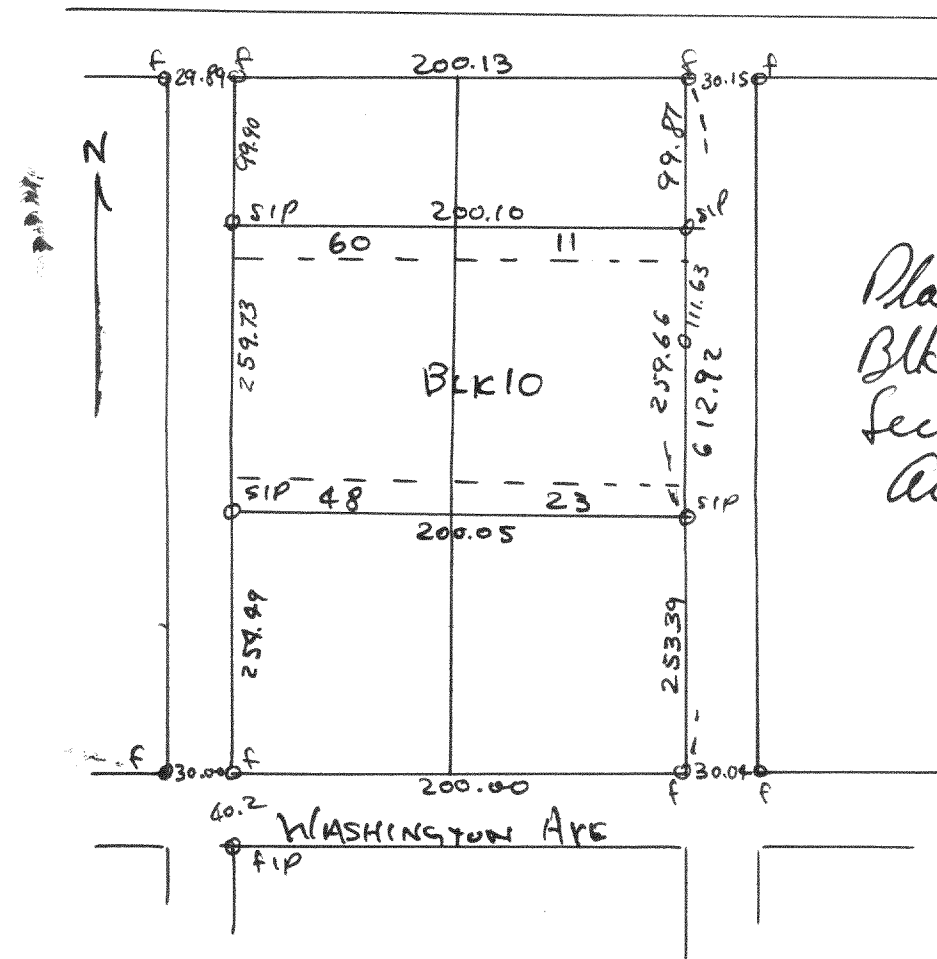


Plat of survey of lots 11-23, 48-60 Blk 10, Lake Ivanhoe Resort located in Sec 2, T1N R18E, Walworth Cty, Wis.
 Aug 2, 1950
 Floyd S. Jensen
 County Surveyor

#2257

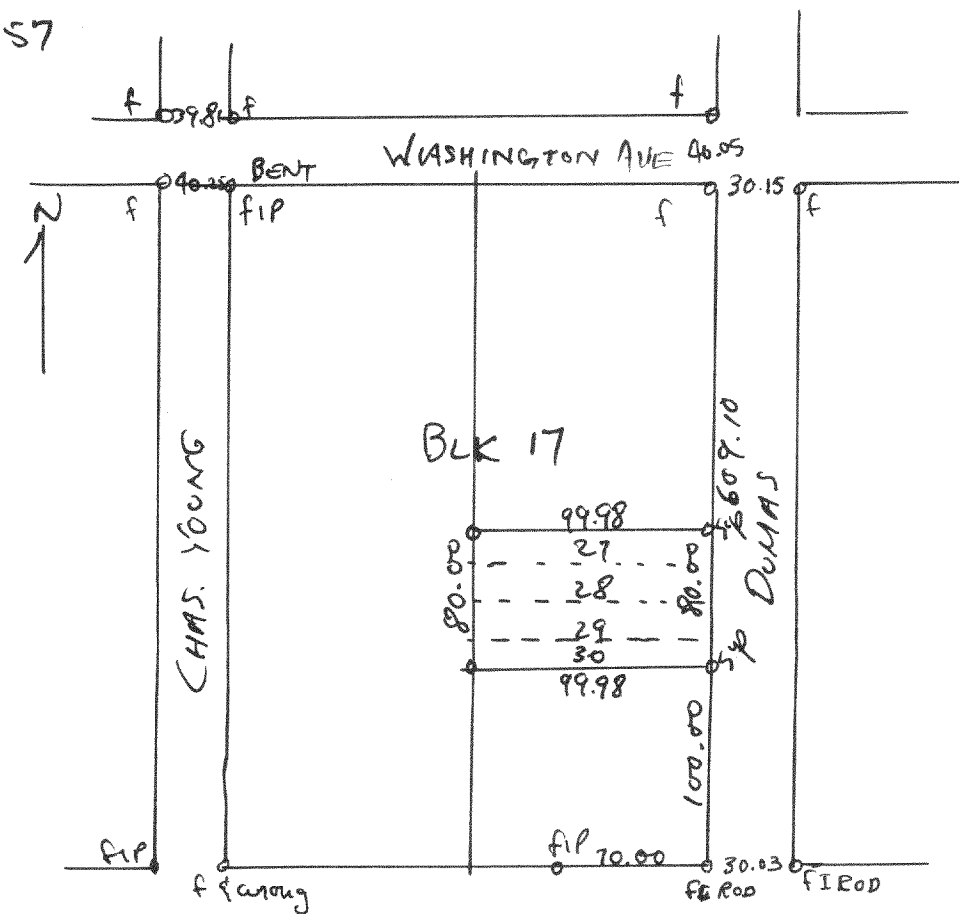

Plat of survey of lots 27-30 Blk 17 of Lake Ivanhoe Resort located in Sec 2, T1N R18E of Walworth County, Wis.
 Aug 2, 1950
 Floyd S. Jensen
 County Surveyor

#2259

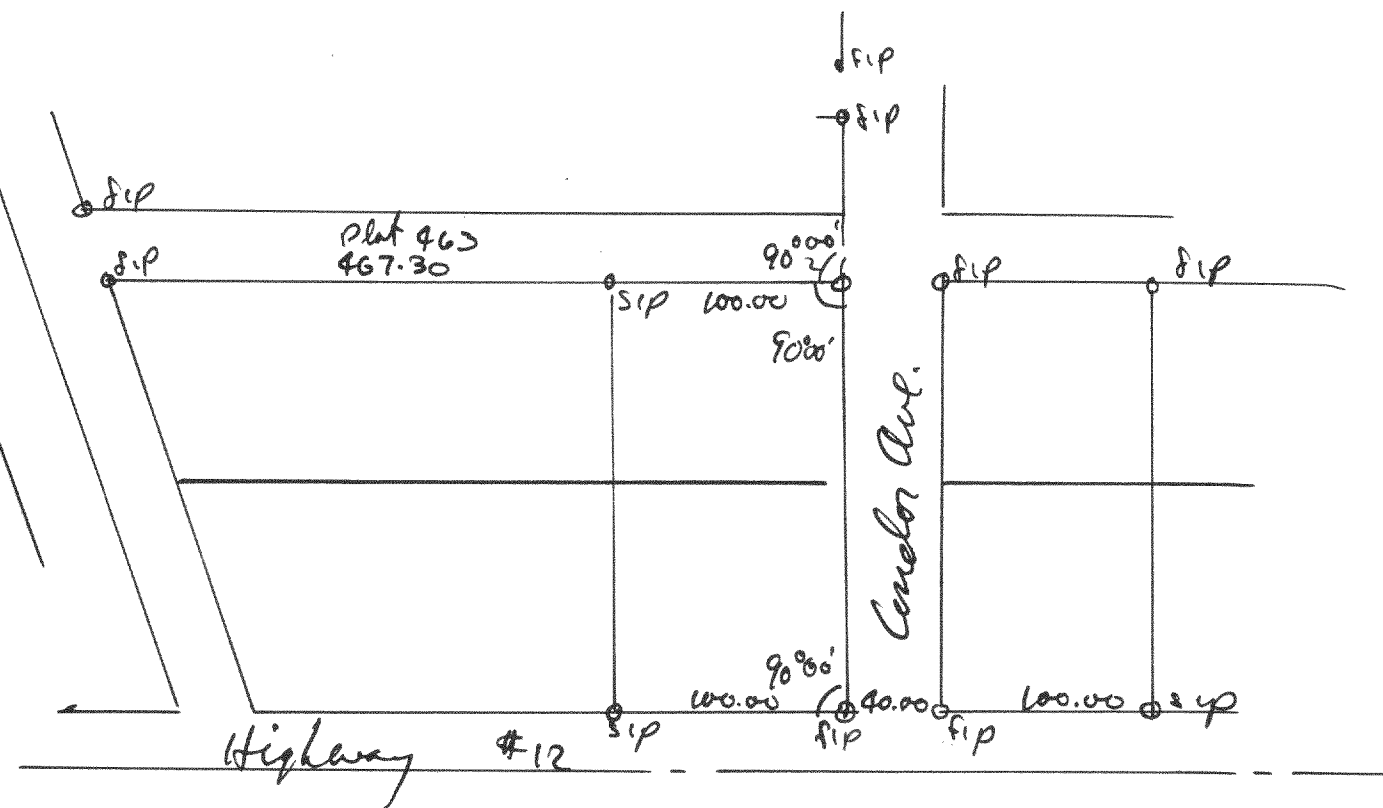

Plat of survey of lots 8232-8251 Incl., of Bell Lake Subd located in Sec 27, T1N R18E, Walworth County, Wis.
 Aug 17, 1950
 Floyd S. Jensen
 County Surveyor