



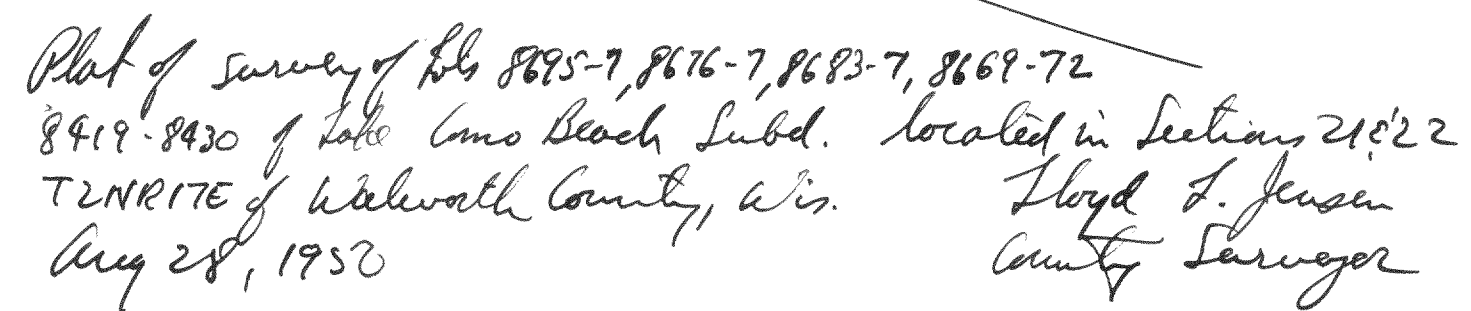

2282

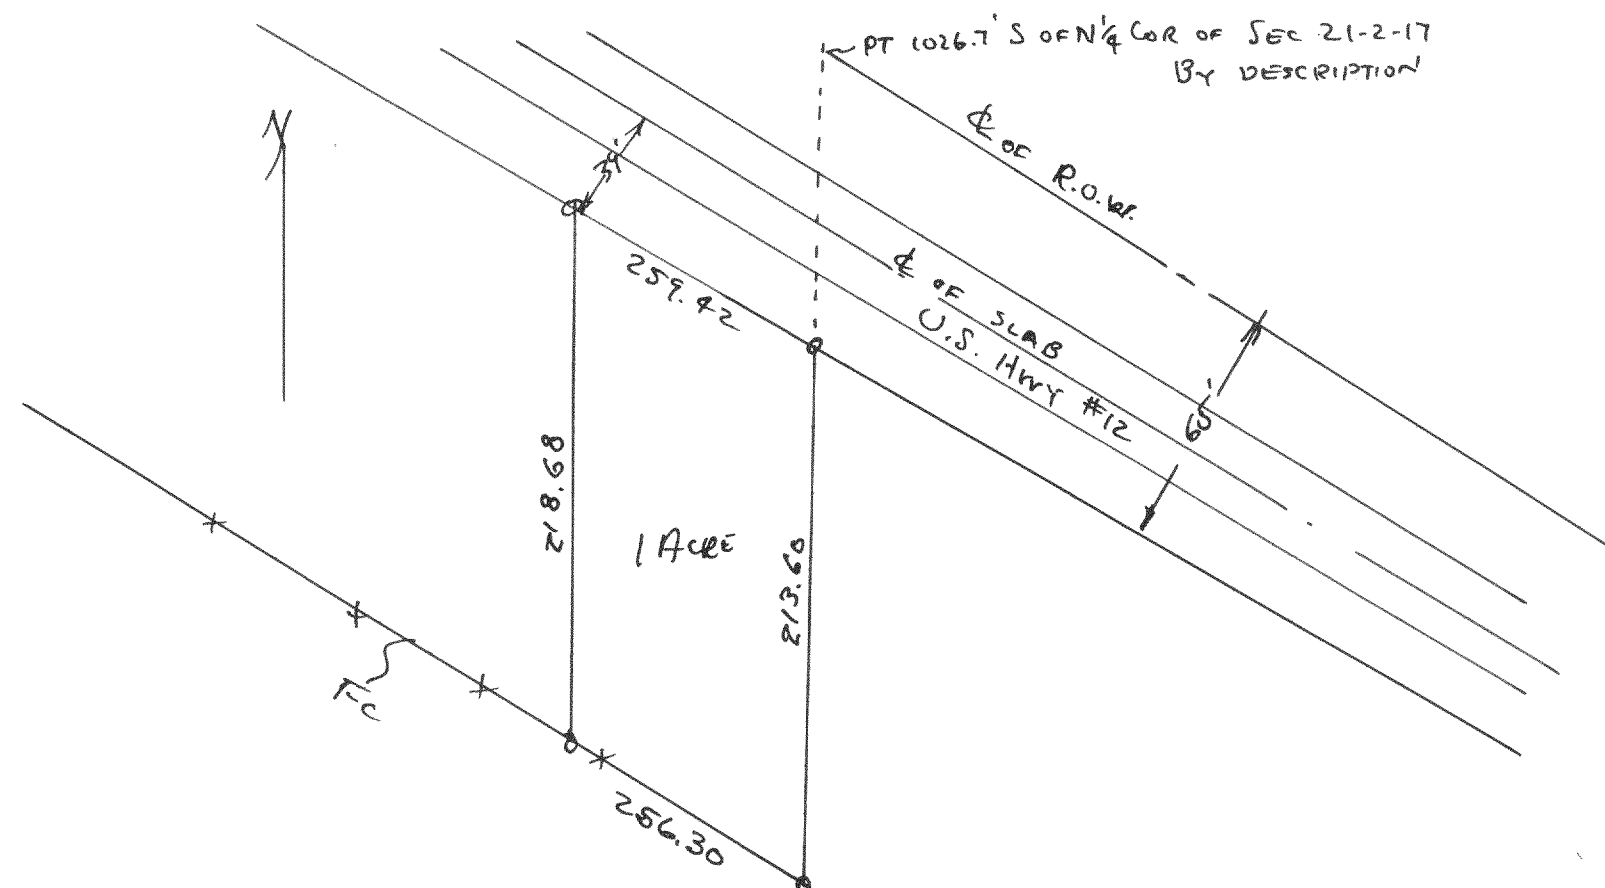

Plot of survey of a 1 acre parcel of land located in 160 NW 1/4 of
Sec 21, T22N R17E, Walworth County, Wis.
Aug 3, 1950
Lloyd S. Jensen
County Surveyor