



SURVEY 1279

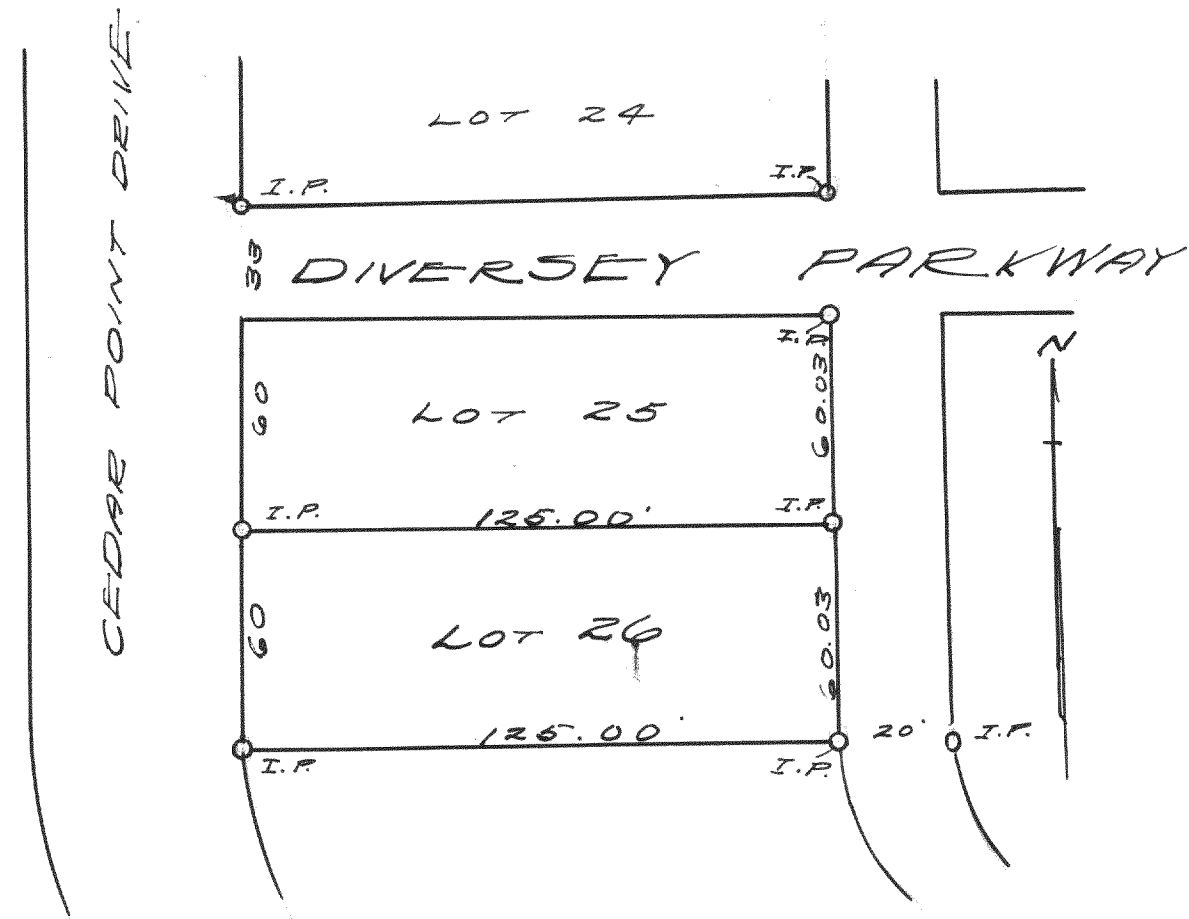

PLAT OF SURVEY OF LOT 26 OF
CEDAR POINT PARK SUBDIVISION,
IN THE VILLAGE OF WINS. BAY, WALWORTH
COUNTY, WISCONSIN
MARCH 8, 1941

Lloyd L. Jensen
R.E.C.

SURVEY NO. 1280

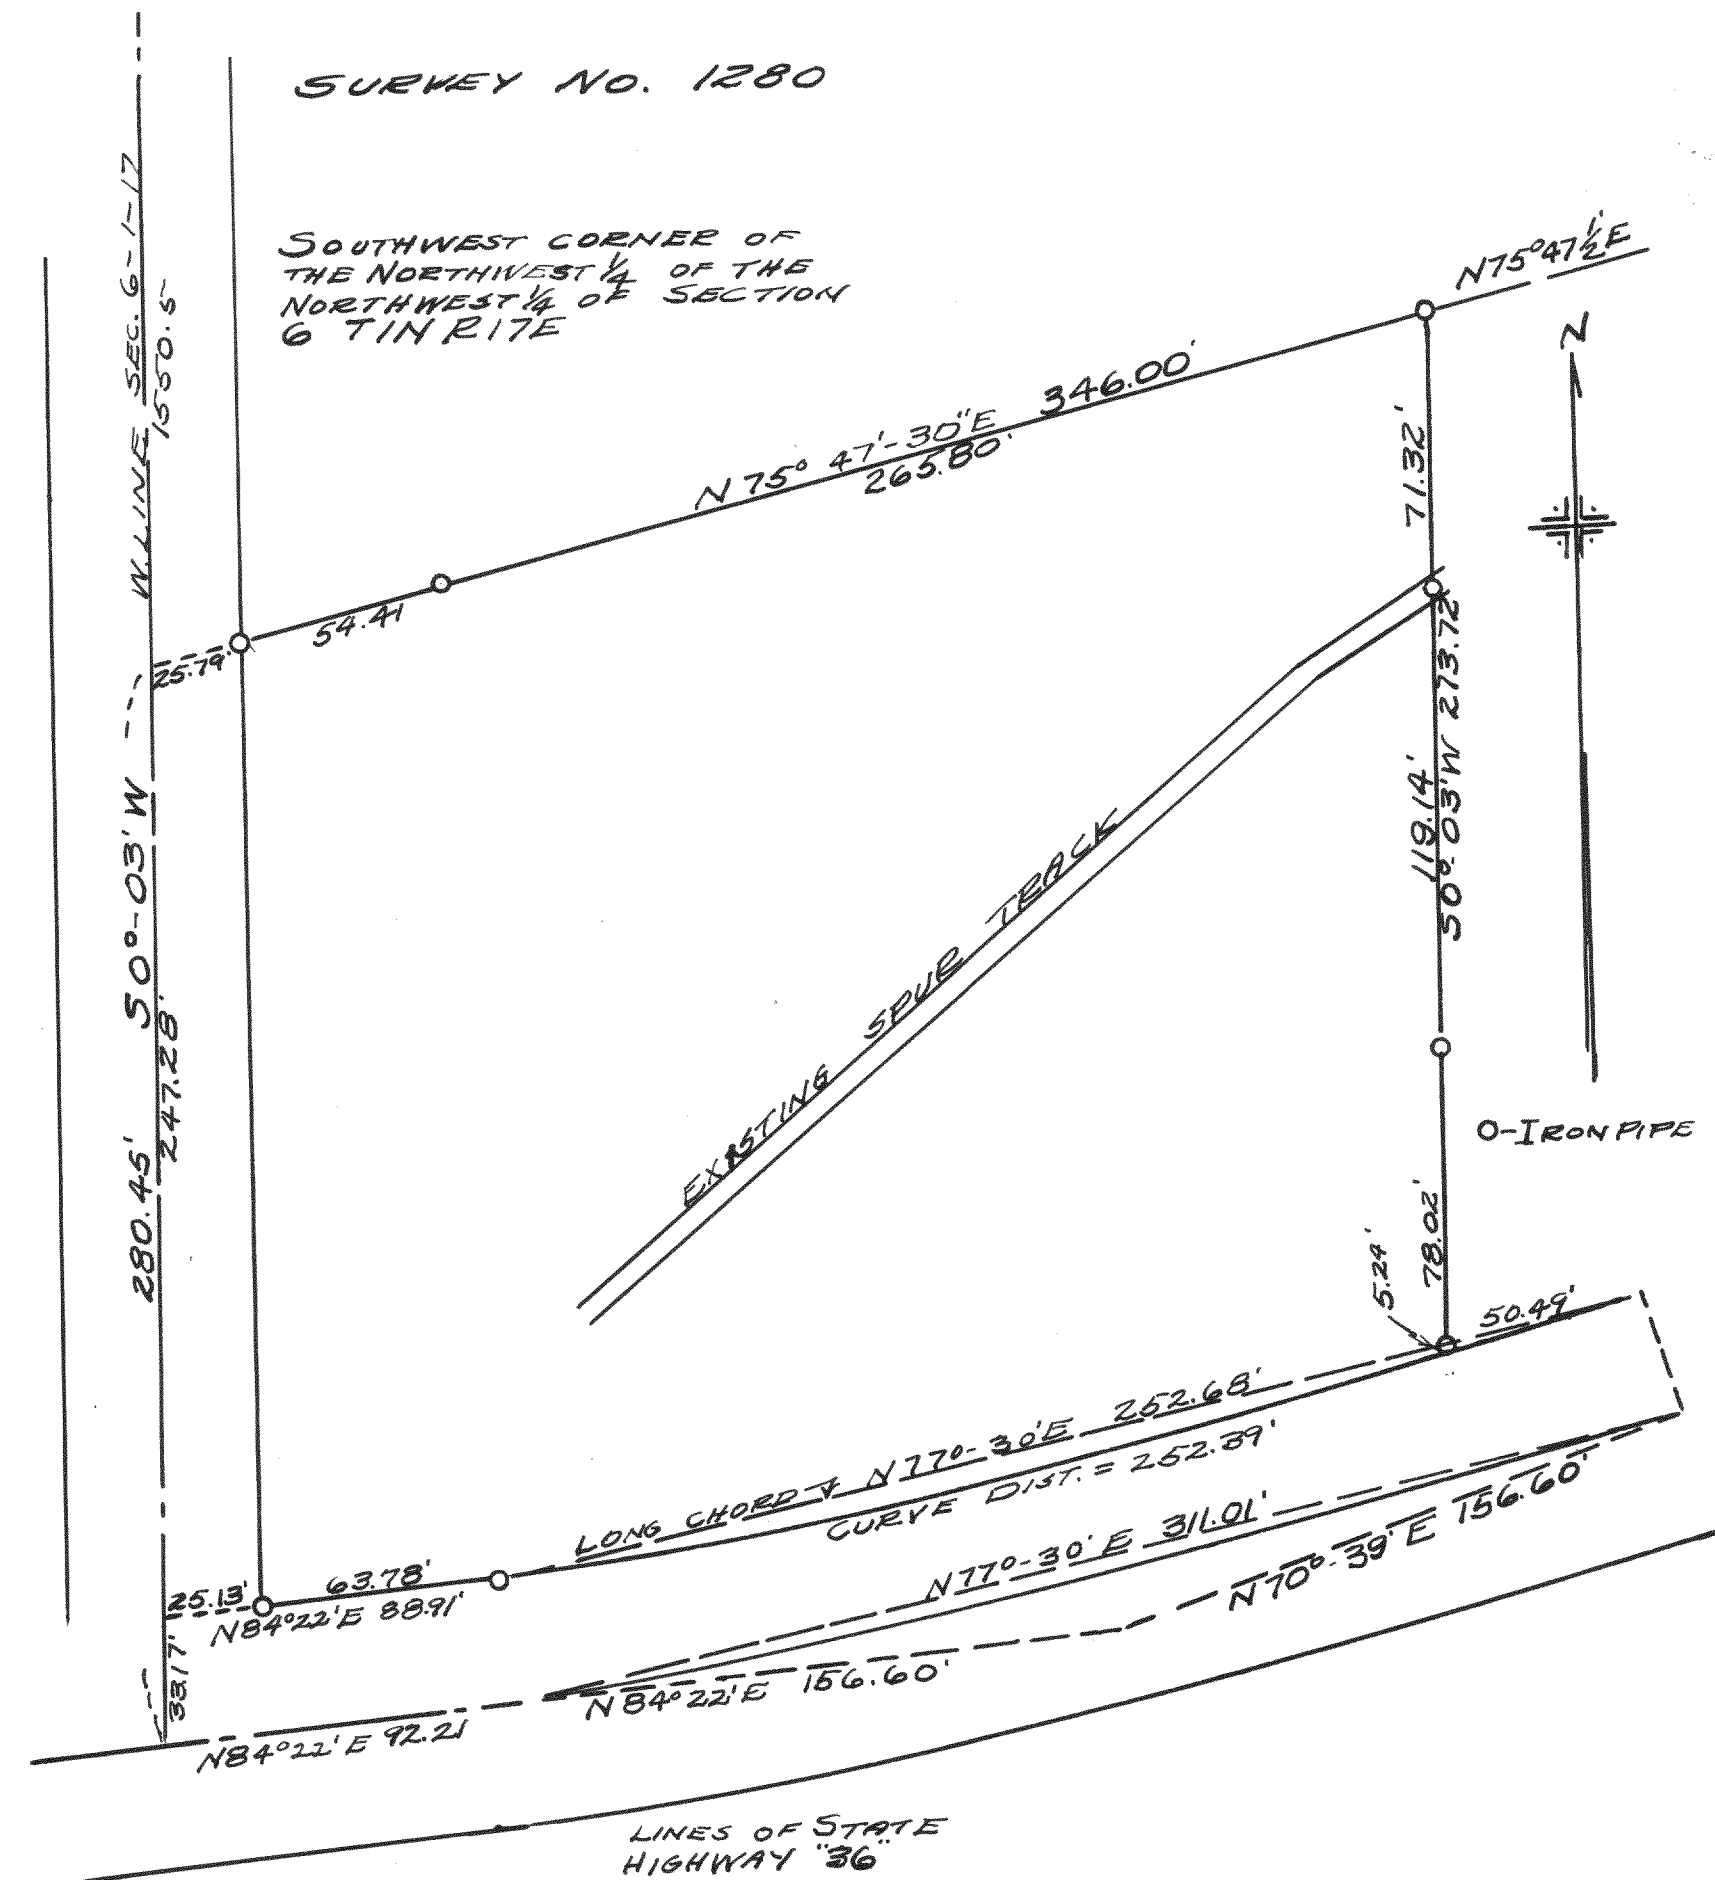

PLAT OF SURVEY OF LAND LOCATED IN THE
NORTHWEST 1/4 OF SECTION 6 T1N R17E OF
WALWORTH COUNTY, WISCONSIN
MARCH 24, 1941

Lloyd L. Jensen
R.E.C.