



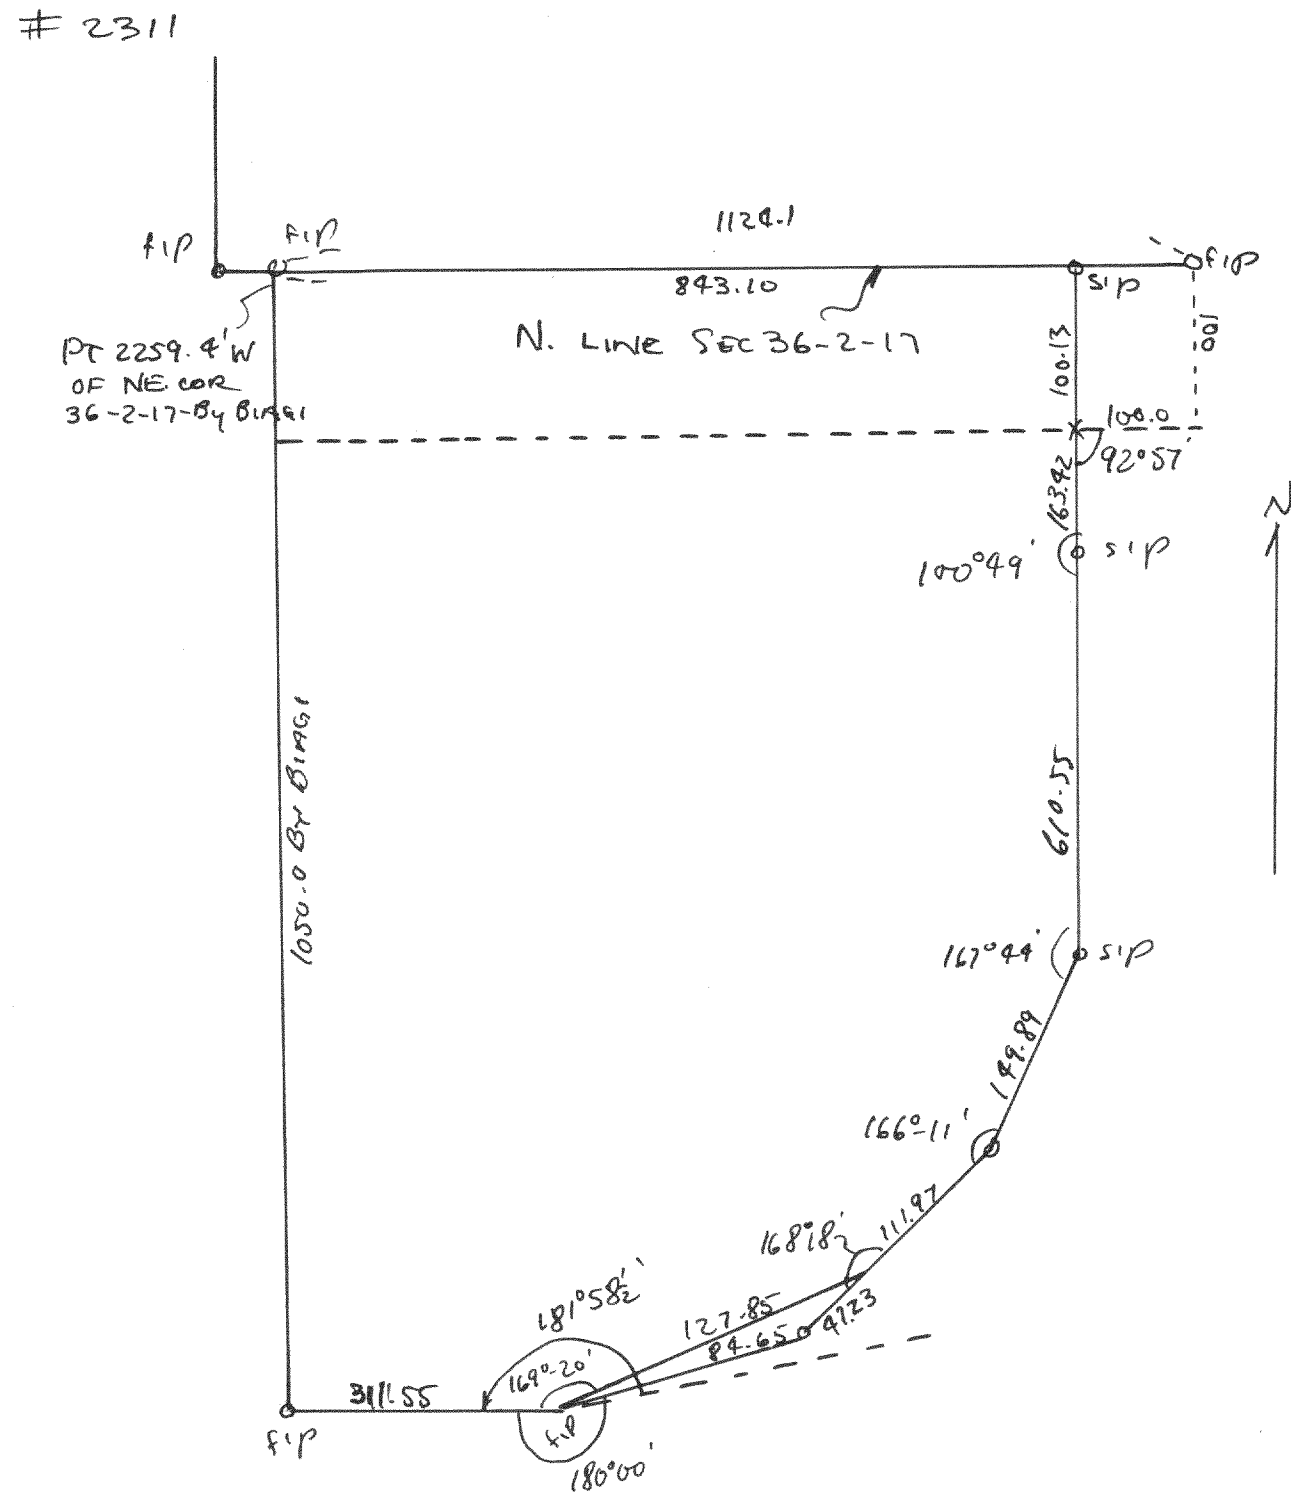

Plat of survey of the Lake Geneva School including athletic Field located in Sec 36, T4N R17E of Walworth Co., Wis.
November 29, 1950
Lloyd L. Jensen
County Surveyor

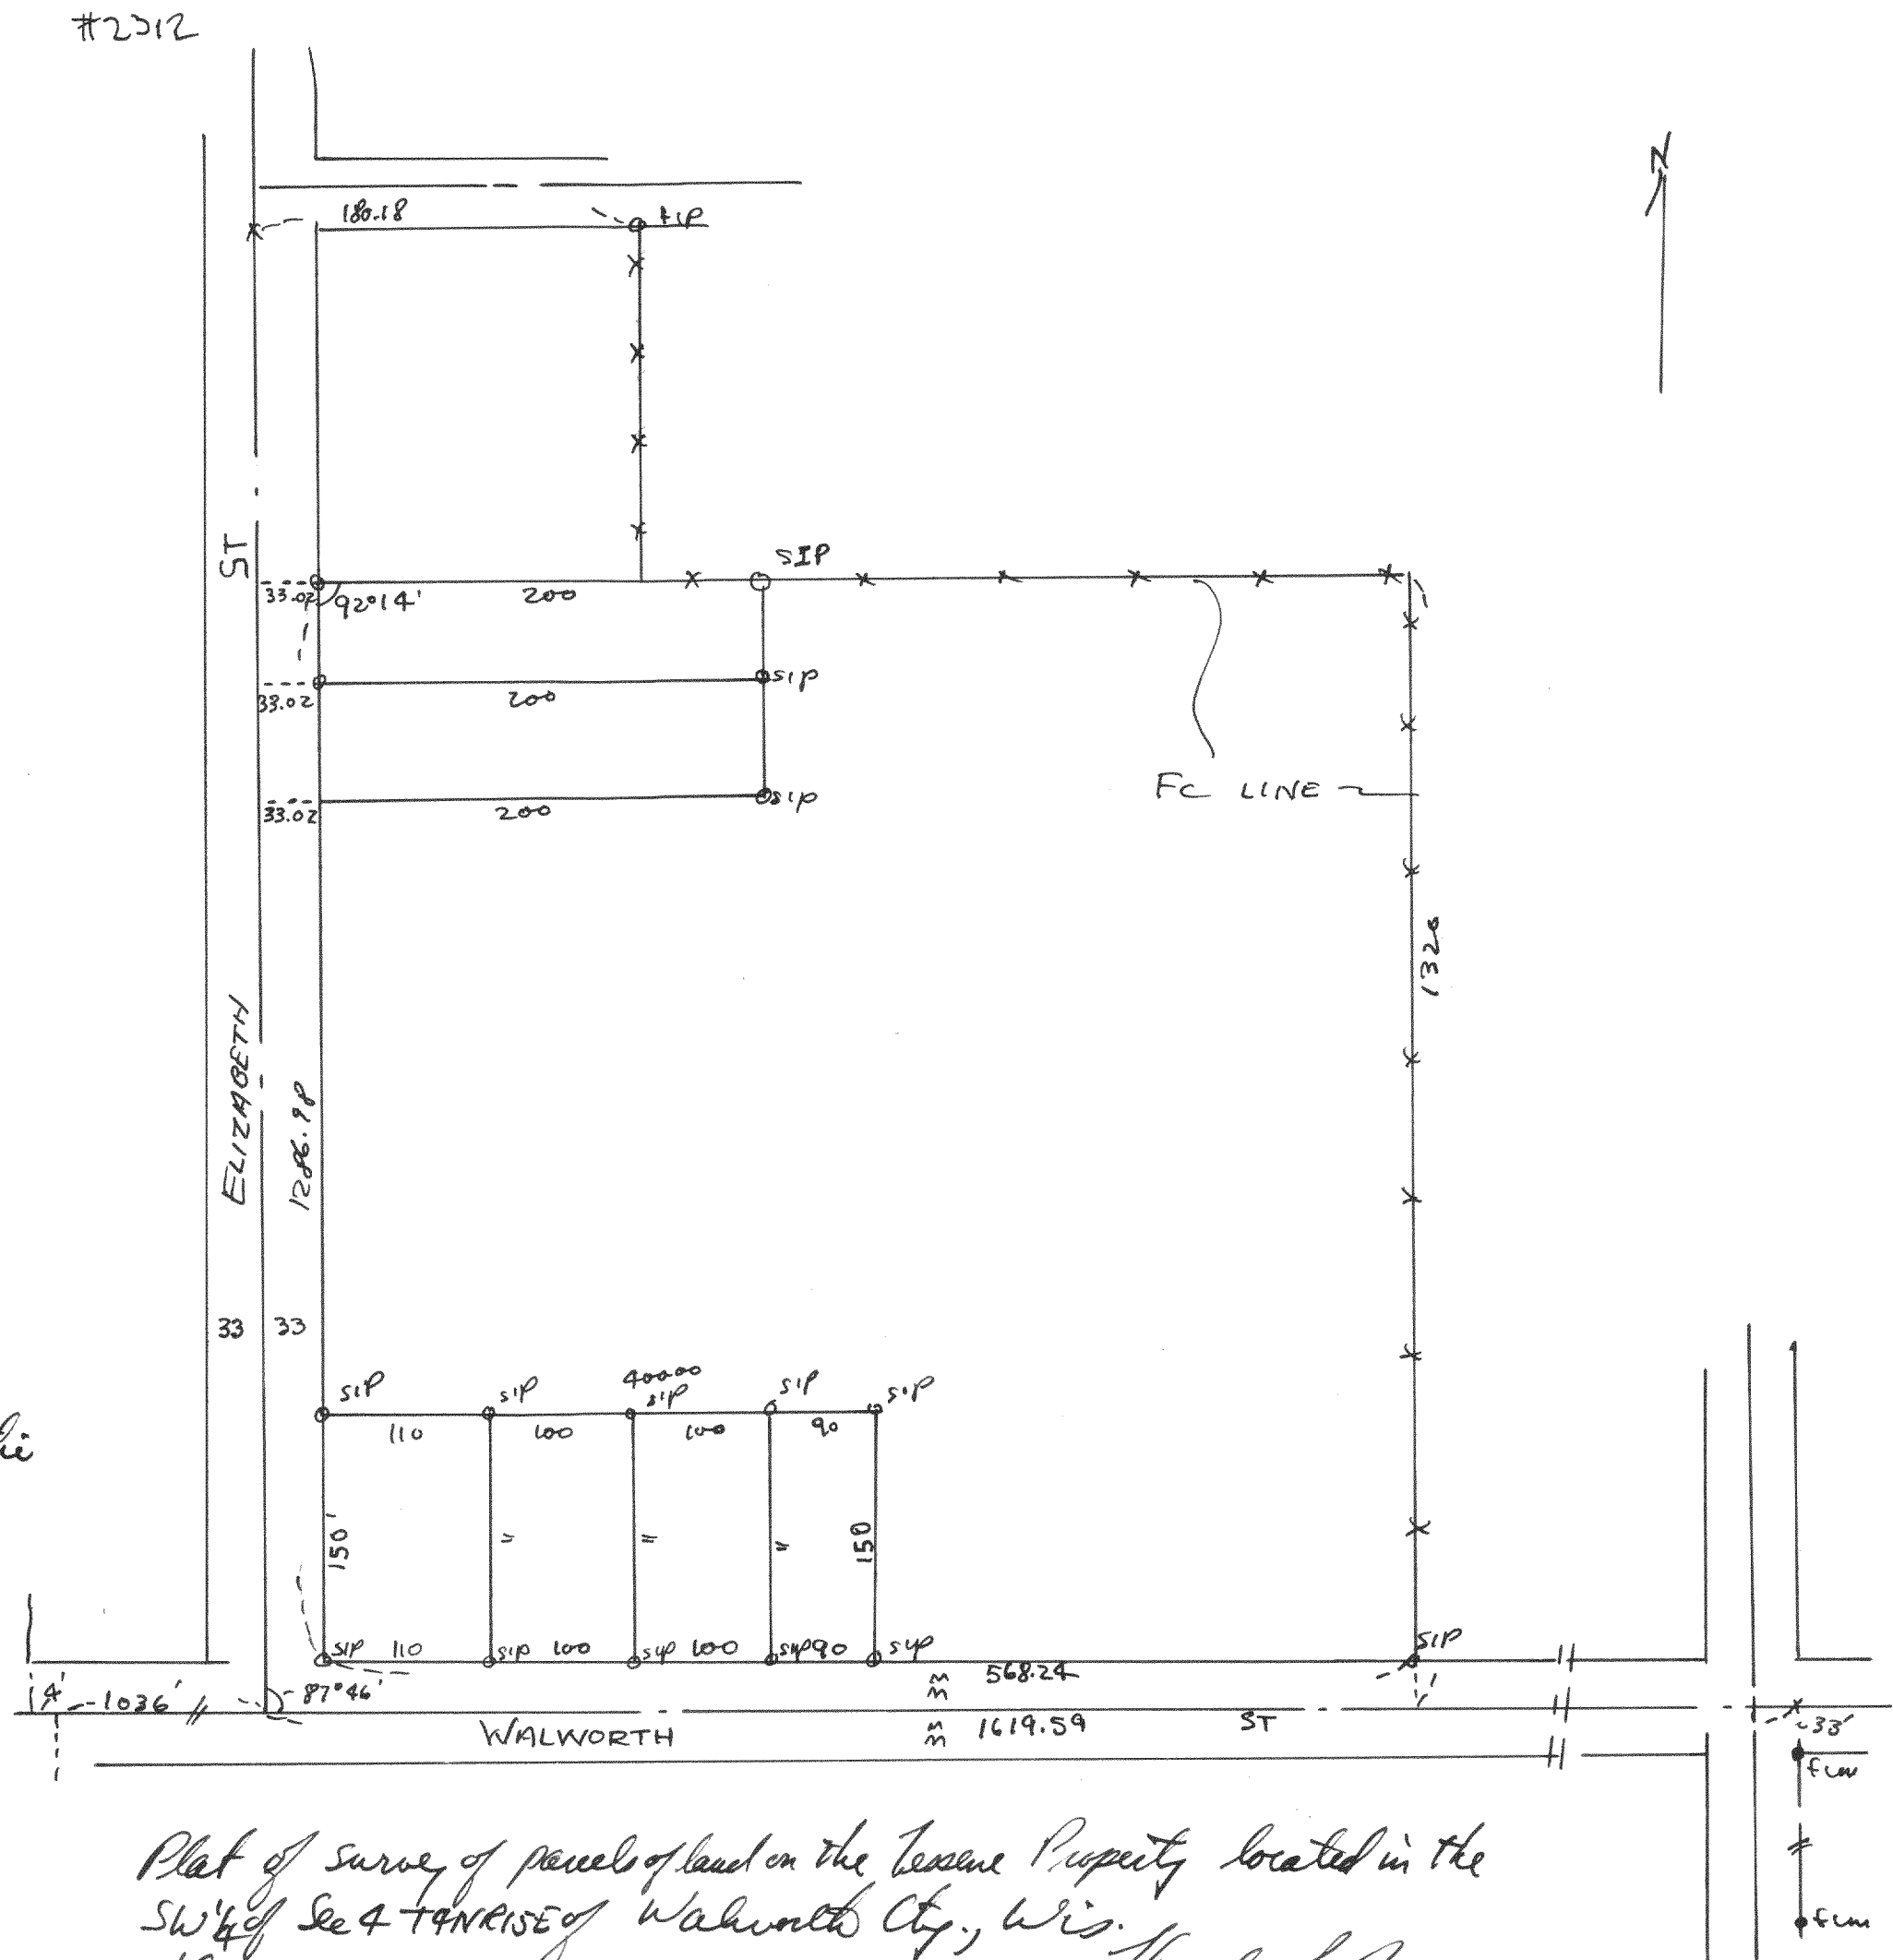

Plat of survey of parcels of land on the Lesane Property located in the SW 1/4 of Sec 4 T4N R17E of Walworth Co., Wis.
1950
Lloyd L. Jensen
County Surveyor