



#2315

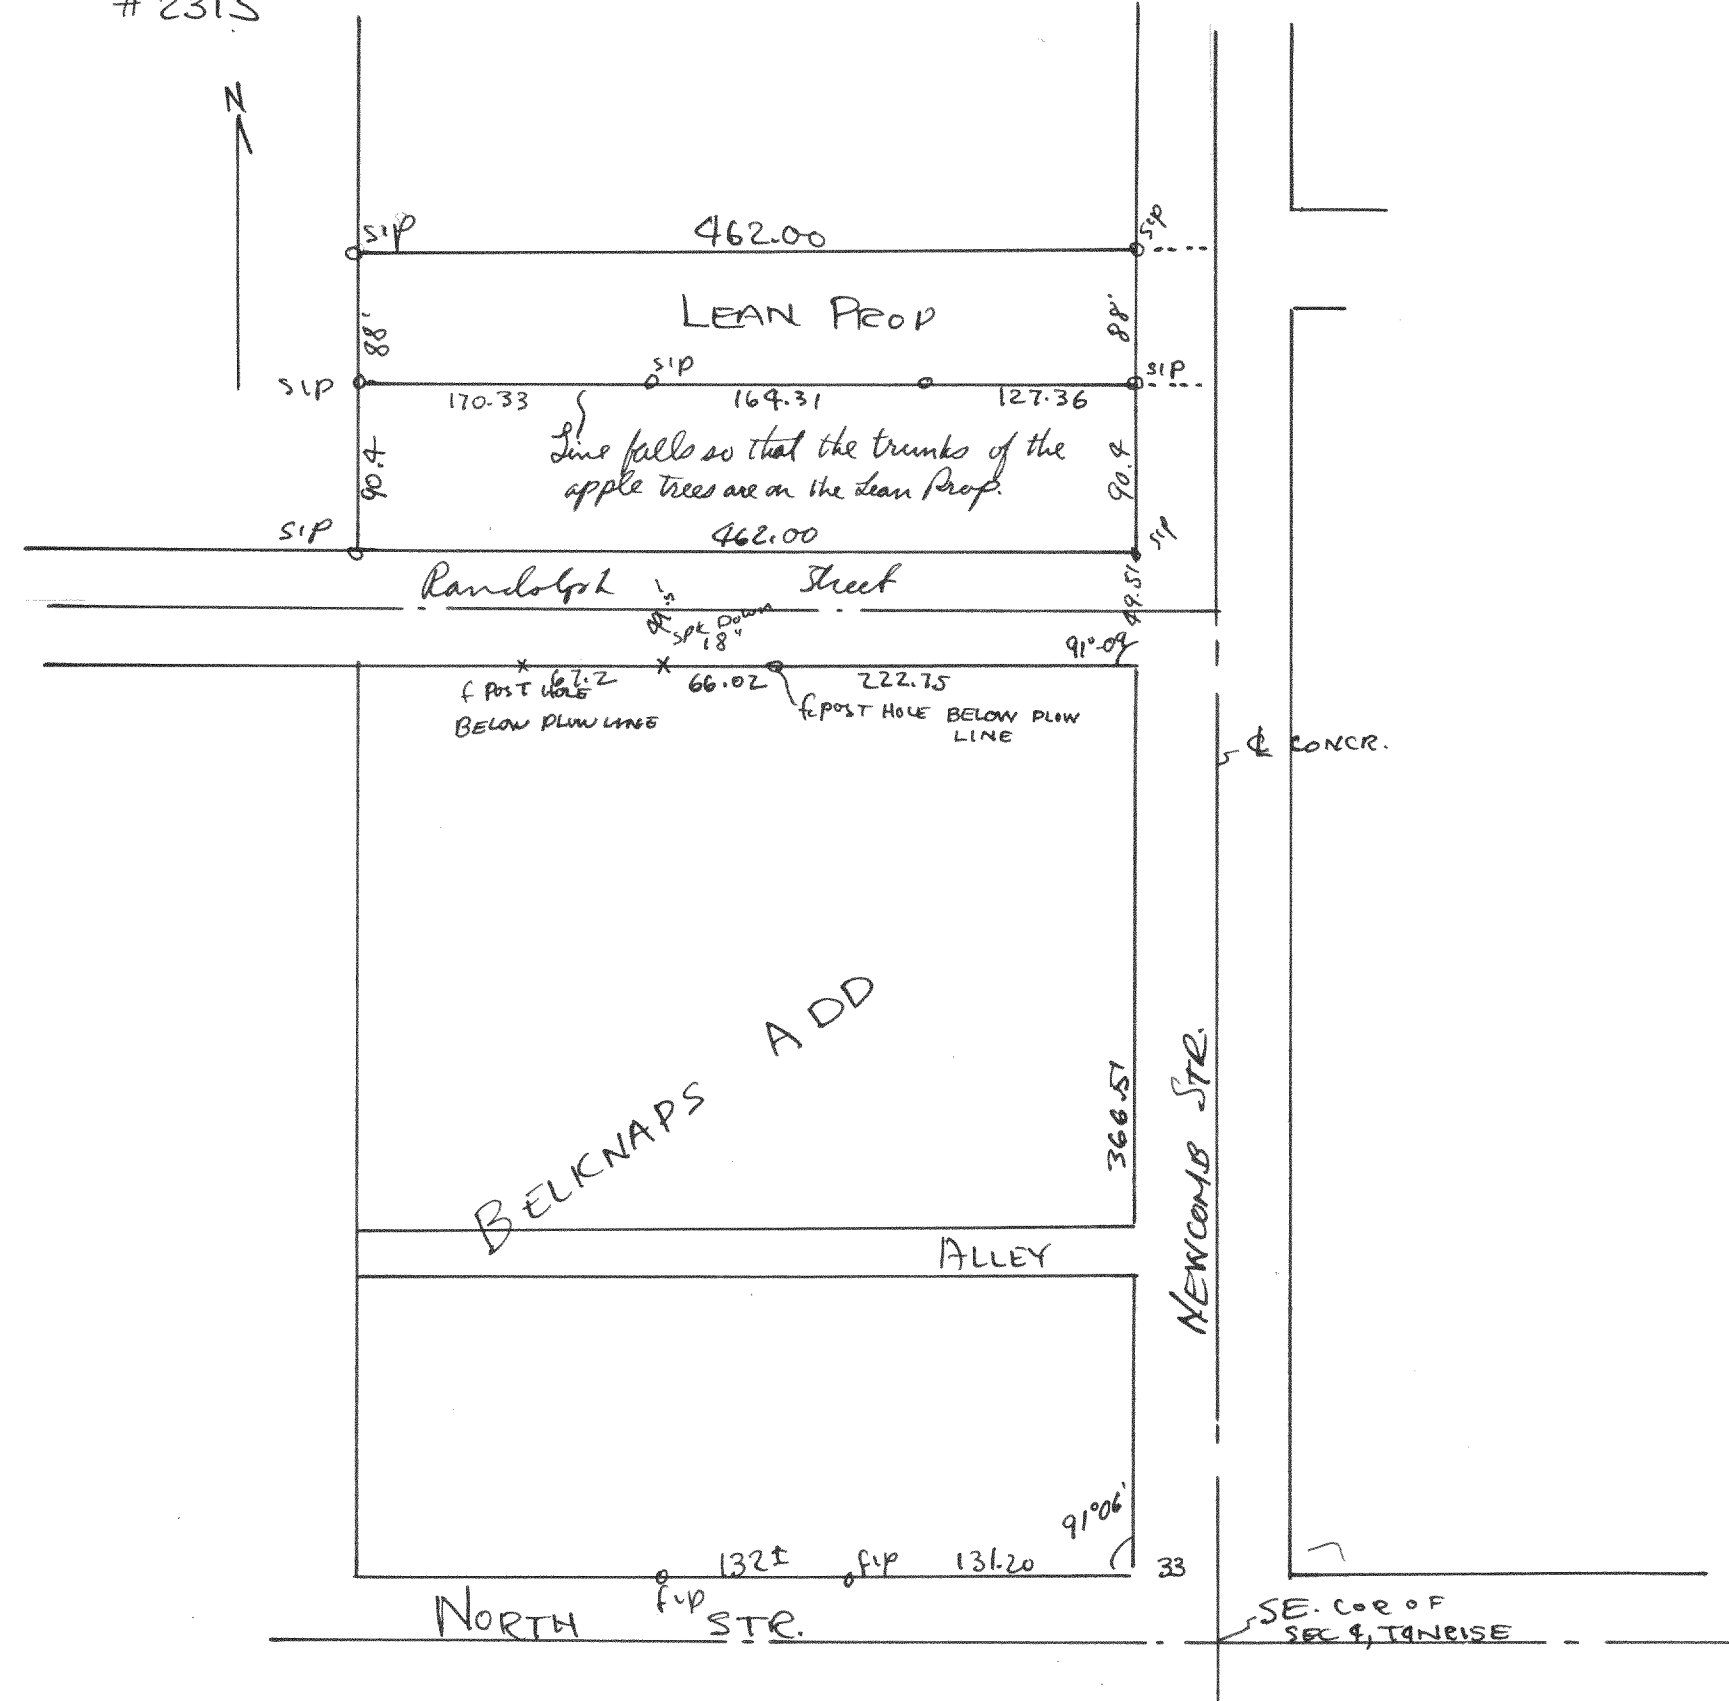

Plat of survey parcel of land owned by Leon and located in
SE $\frac{1}{4}$ Section 9, T4N R15E, City of Whitewater, Walworth County, Wis.
Nov 16, 1950
Floyd L. Jensen
County Surveyor

#2316

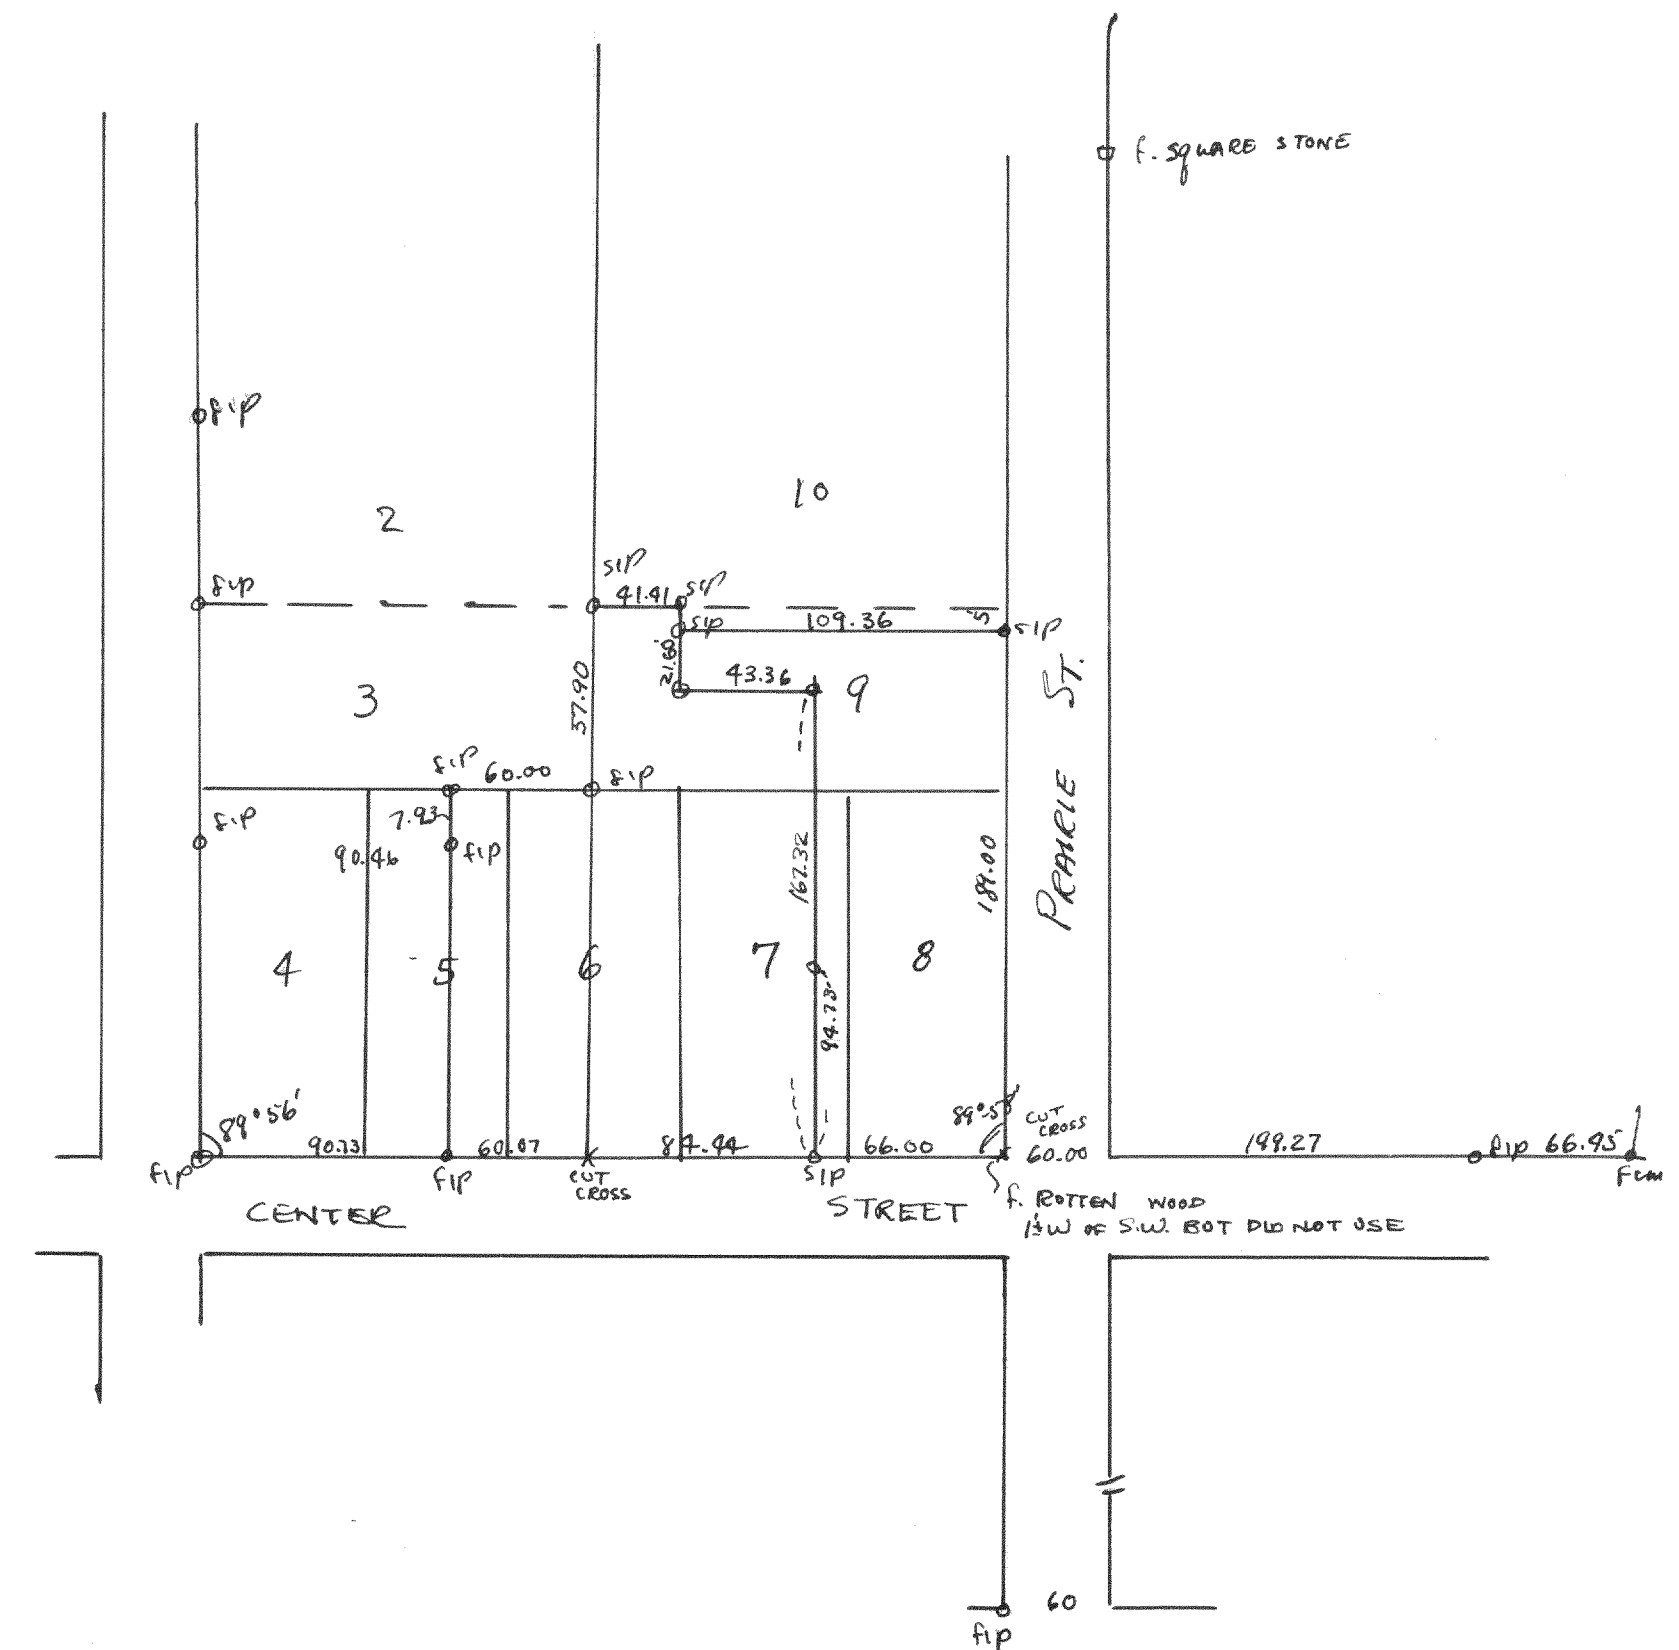

Plat of survey of parts of Lots 6, 7, 8, & 9 of Block 17 Chapman &
Sudingtons Add. City of Milwaukee, Walworth County, Wis.
Nov 17, 1950
Lloyd S. Jensen
County Surveyor