



2329

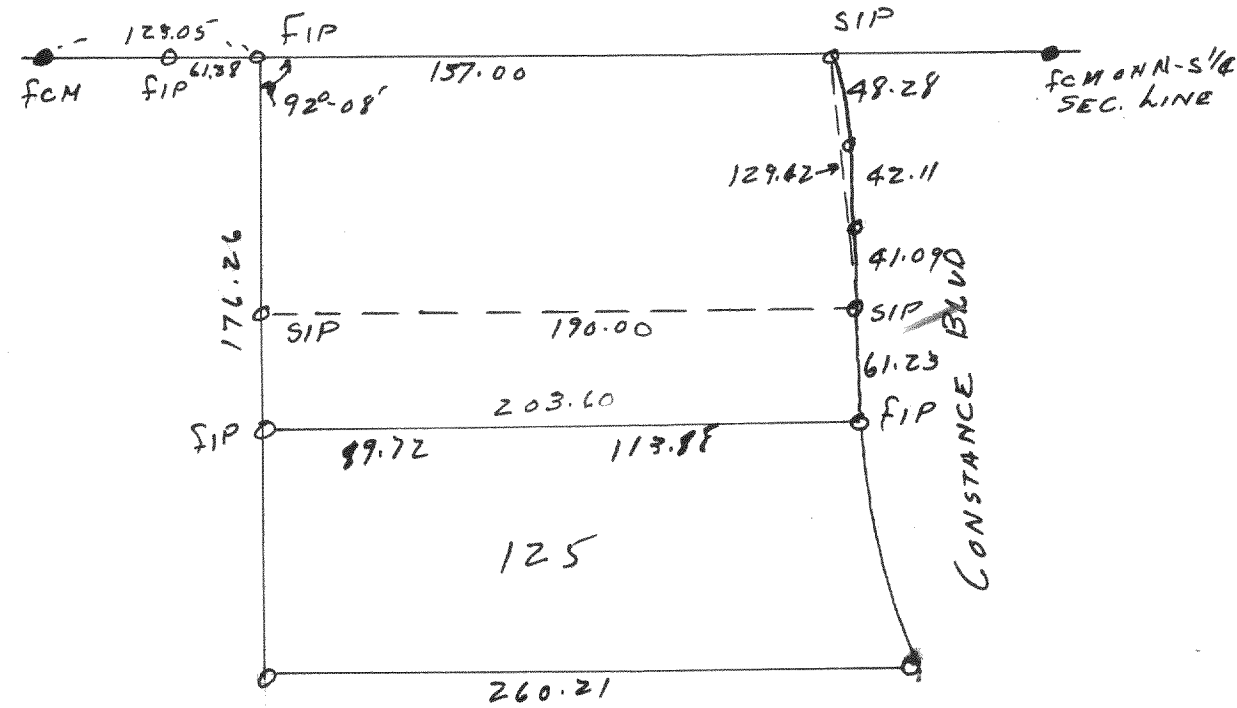

Plot of survey of part of lot 126 of Grand Terrace Subd.
located in the Village of Williams Bay Section 17 T1N R16E Walworth
County, Wis.
April 7, 1950

Floyd L. Jensen CWS
County Surveyor


2331

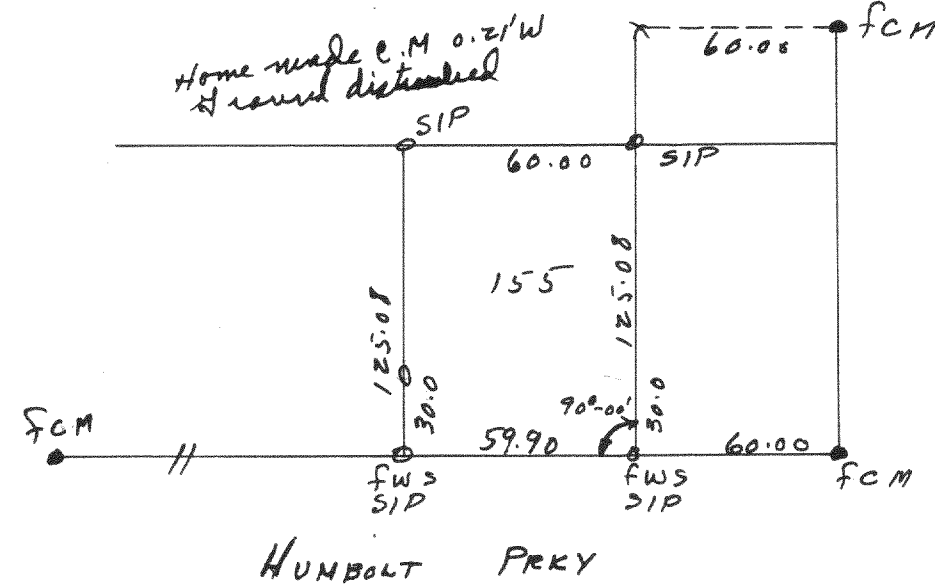

Plot of survey of lot 155 Cedar Point Park Original Subd.
located in Village of Williams Bay Section 6 T1N R17E Walworth County, Wis.
April 15, 1950

Floyd L. Jensen CWS
County Surveyor


2330

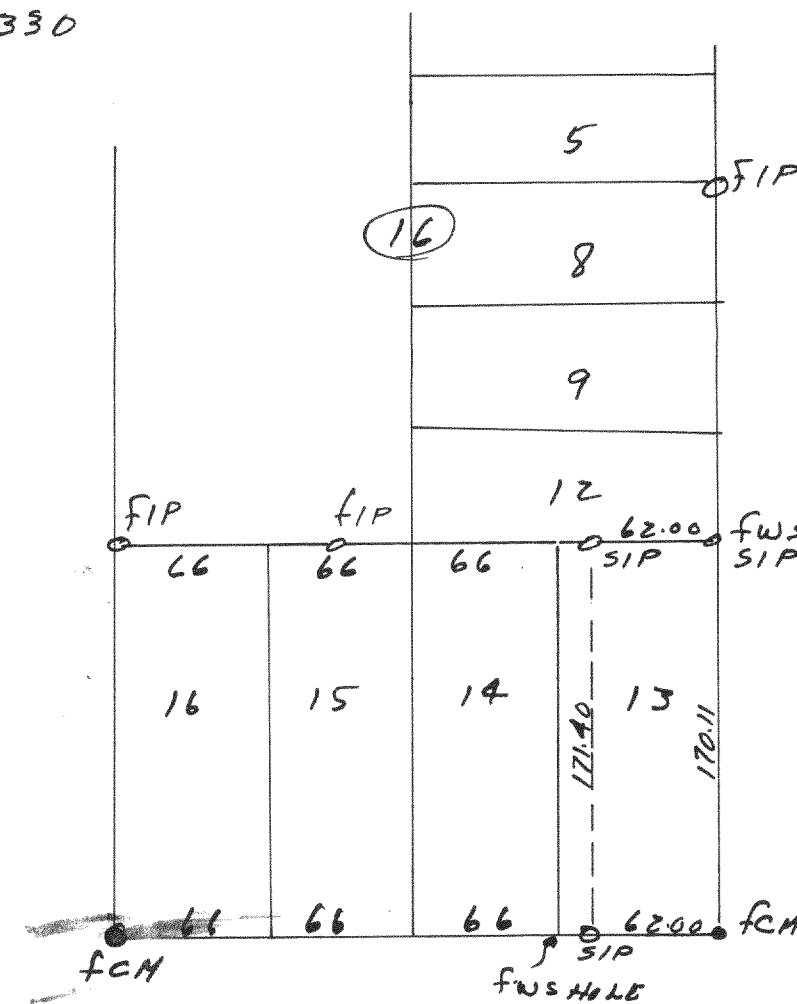

Plot of survey of the east 62 feet of lot 13 Blk 16 of Williams 2nd Add
Village of Williams Bay, Walworth County, Wis.
April 8, 1950

Floyd L. Jensen (CWS)
County Surveyor

2332

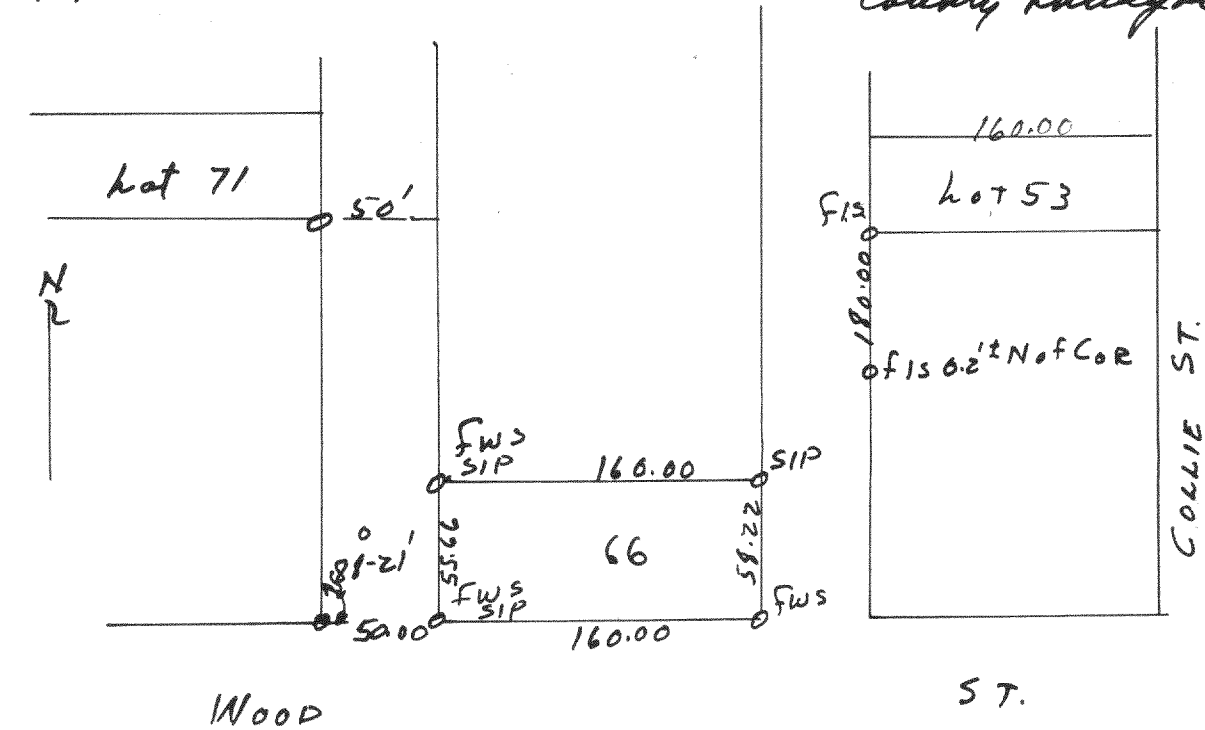

Plot of survey of lot 66 Bay View Subd located in the S.E. 1/4
of Sec. 1 T1N R16E Village of Williams Bay, Walworth County, Wis.
1950

Floyd L. Jensen (CWS)
County Surveyor