


2337

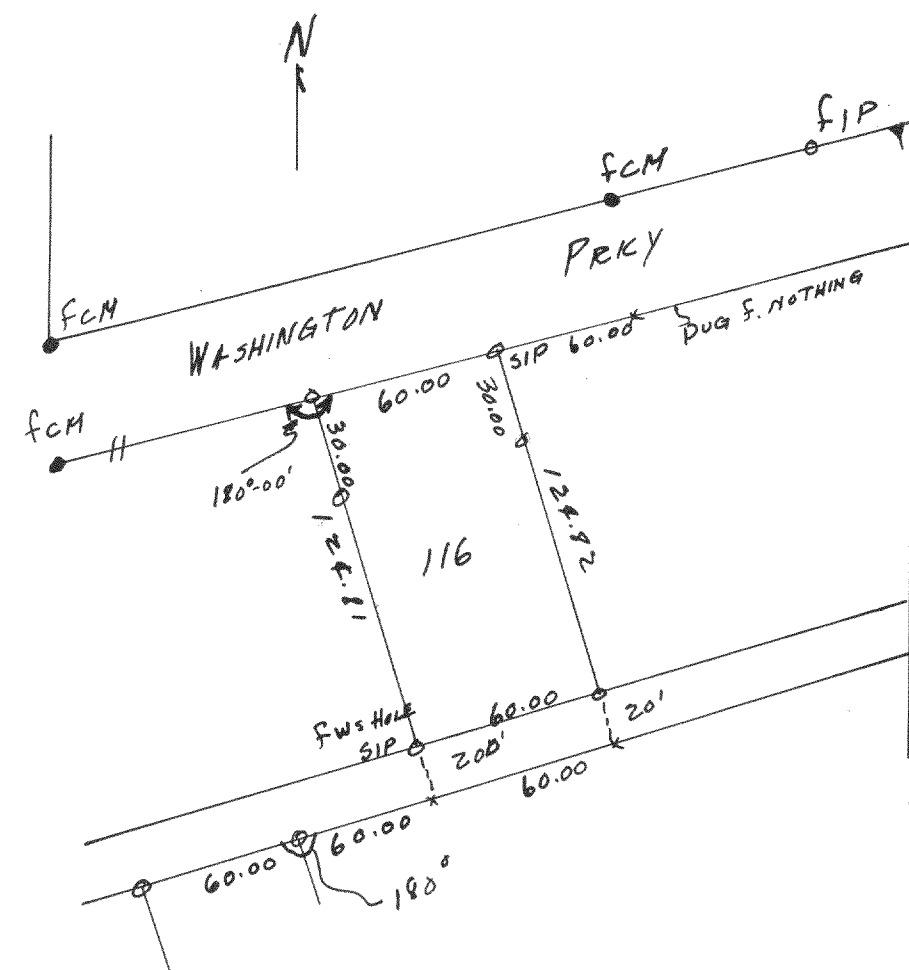


Plot of survey of lot 116 of Cedar Point Park original Subd.
located in the S.E. 1/4 of Sec. 6 T14N R17E, Walworth County, Wis.

Floyd J. Jensen (CWG)
County Surveyor


Aug 2, 1950

2338

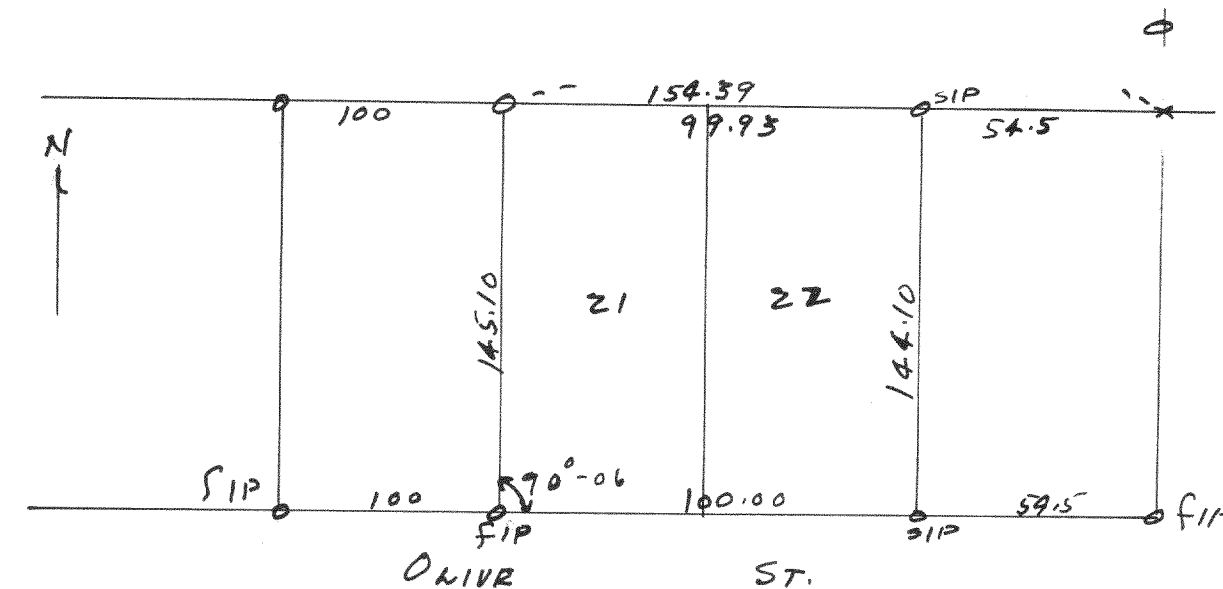

Plot of survey of lots 21 & 22 BLK 1 75th St. S. located in the
NE 1/4 of Sec. 1 T18R16E, Village of Williams Bay, Wauwatosa County, Wis.
Aug 10, 1950
Lloyd J. Jensen (CWS)
County Surveyor

2340

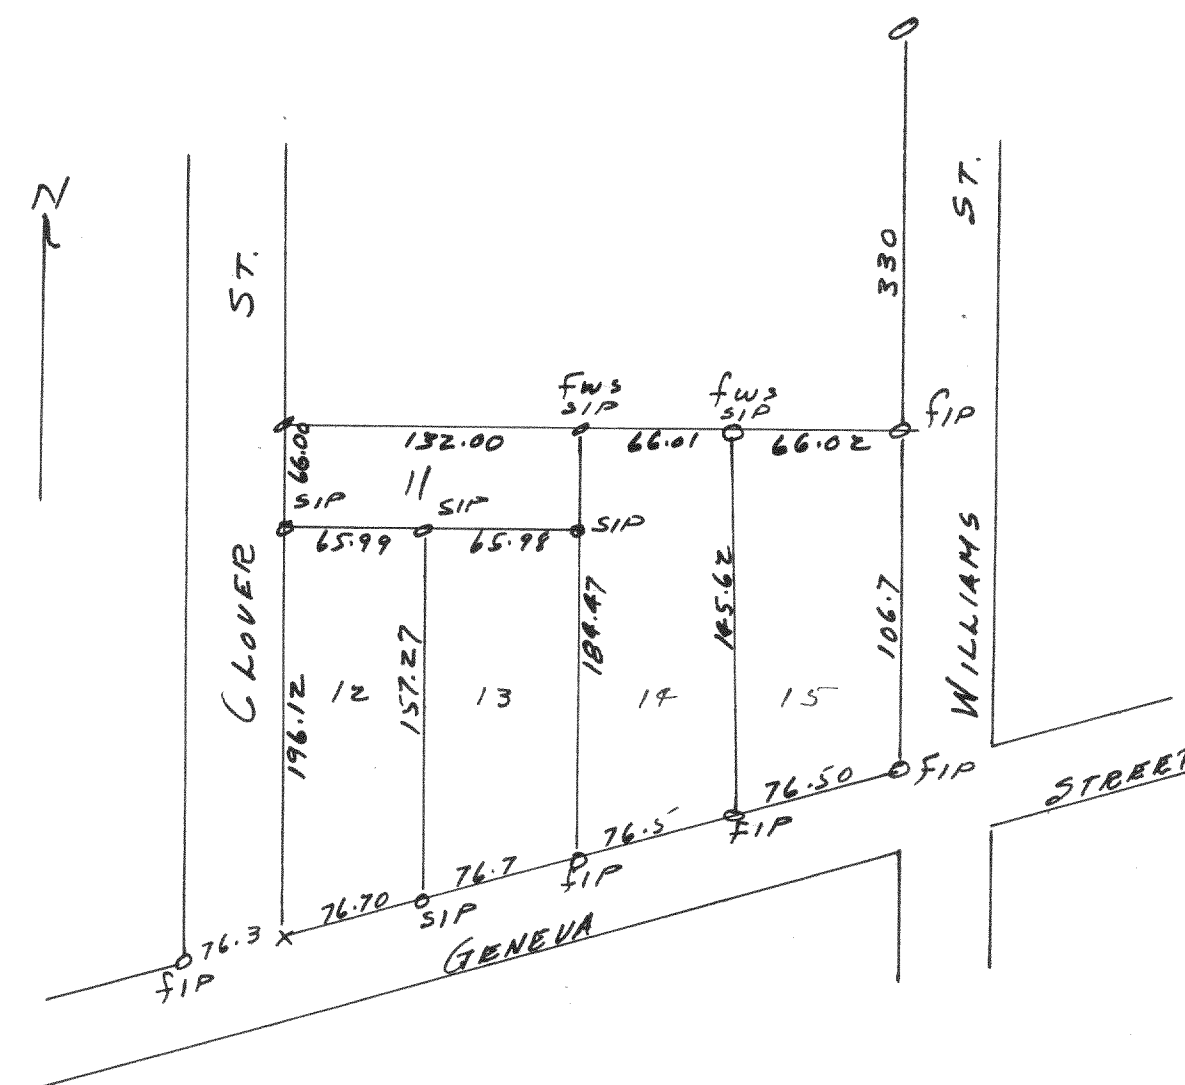


Plot of survey of lot 15 Block 9 of Williams 2nd Addition
located in the NE 1/4 of Sec 17 T14N R16E, Village of Williams Bay
Wauworth County, Wis.

Sept 30, 1950

Floyd L. Jensen (wsg)
 County Surveyor

2339

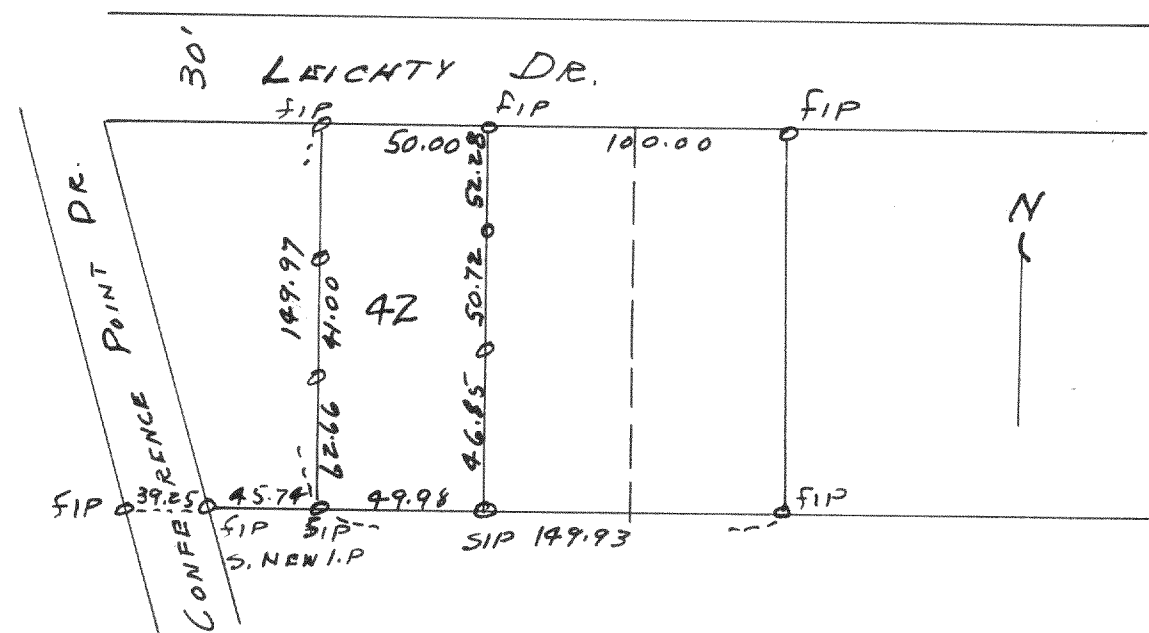

Plot of survey of lot 42 Summer Haven Subd.
located in SE 1/4 of Sec 17 T16N R16E Village of Wilkins Bay
Walworth County, Wis. Floyd T. Jensen (Clerk)
Sept 9, 1950 County Surveyor