


SURVEY NO. 1283

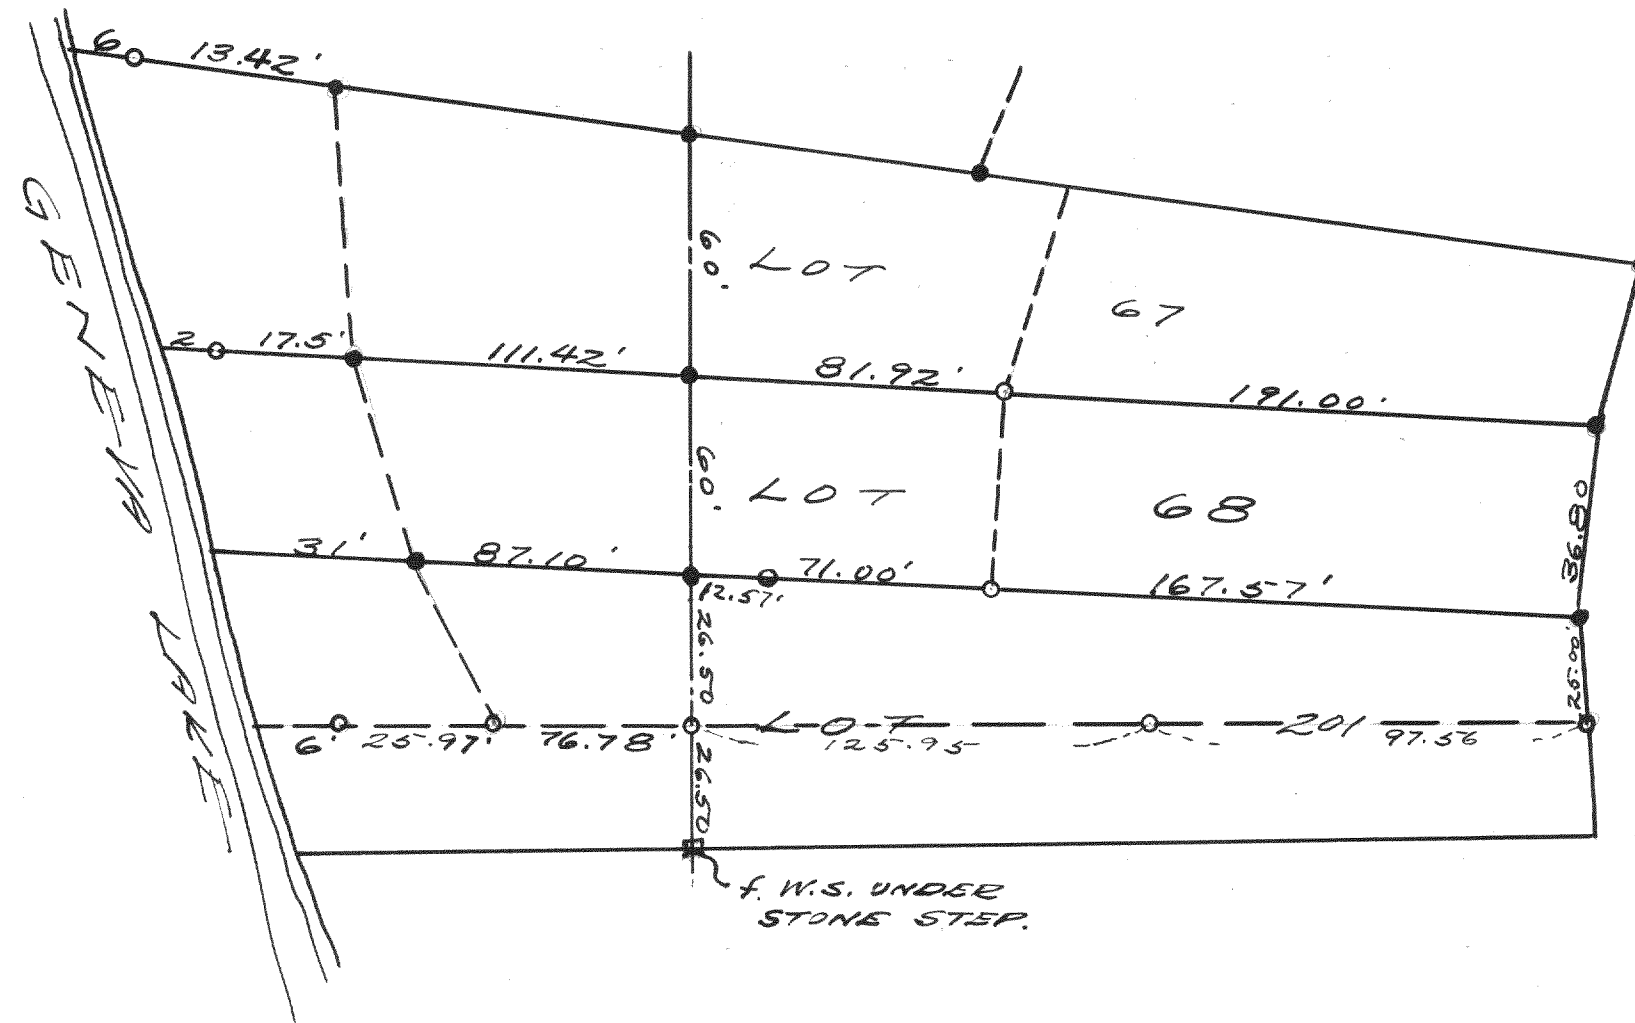


N
PLAT OF SURVEY OF LOT 68 OF THE
1ST ADD. AND THE N $\frac{1}{2}$ OF LOT 201 OF
THE 3RD ADD. TO CEDAR POINT PARK,
IN THE VILLAGE OF WMS. BAY, WALWORTH
COUNTY, WISCONSIN.
AUG. 1941

Lloyd Jensen
REG.

● = CONC. MON.

○ = IRON PIPE.

SURVEY NO. 1284

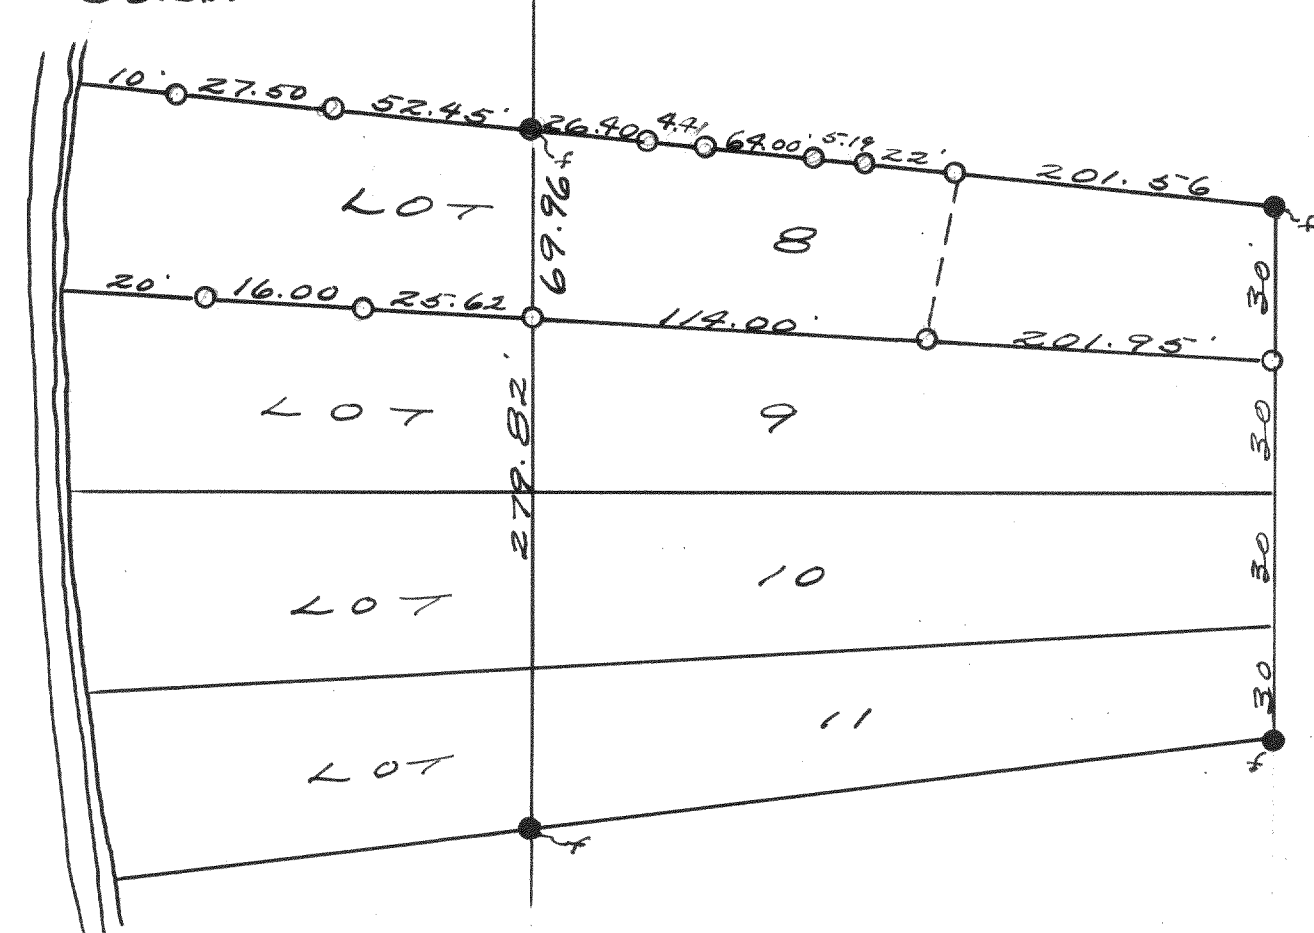

PLAT OF SURVEY OF LOT 8 OF THE FIRST
ADDITION TO CEDAR POINT PARK IN
THE VILLAGE OF WMS. BAY, WALWORTH
COUNTY, WISCONSIN.

AUG. 5, 1941

Lloyd Jensen
REG.