



SURVEY NO. 1287

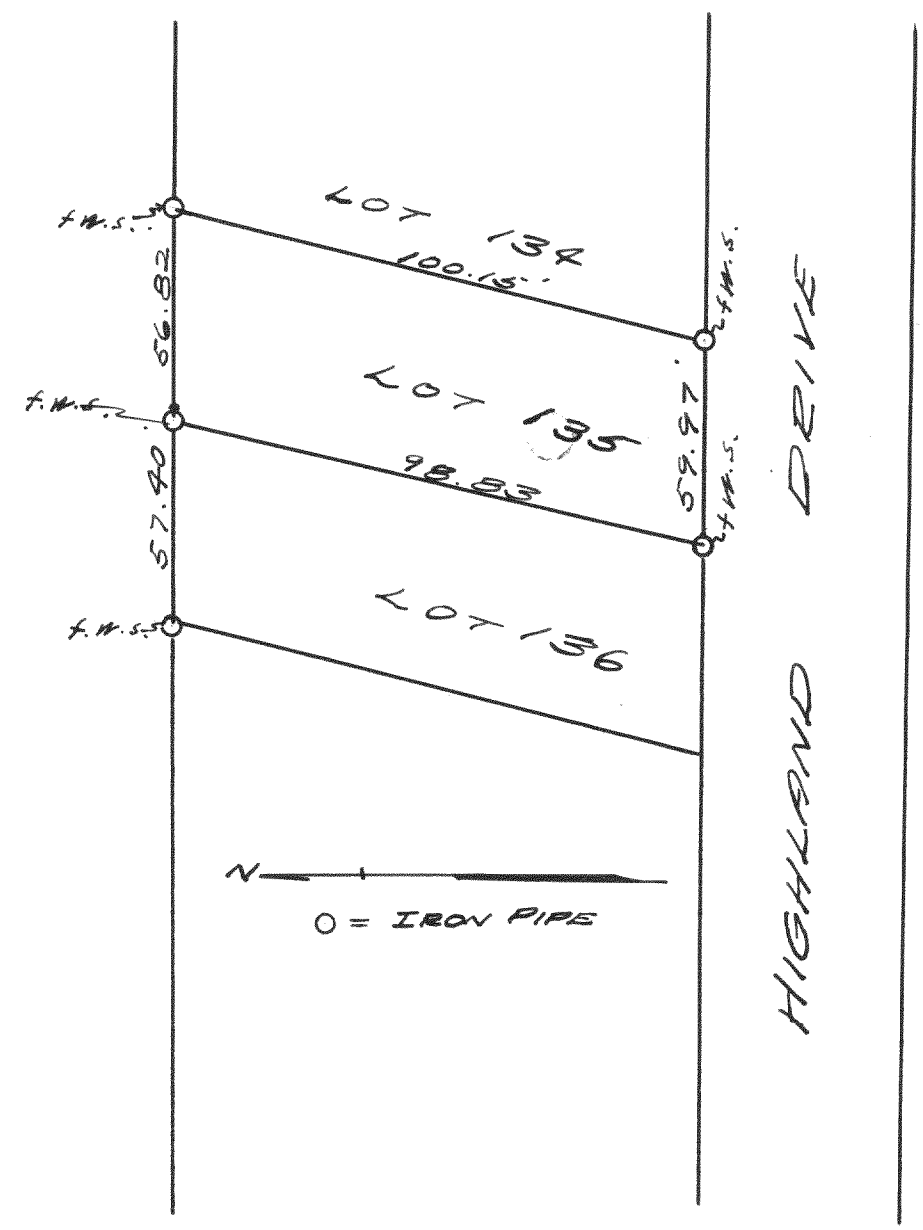

PLAT OF SURVEY OF LOT 135
OF THE 2ND ADDITION TO CEDAR
POINT PARK IN THE VILLAGE OF
WINDS. BAY, WALWORTH COUNTY, WISC.
AUG. 29, 1941
Lloyd L. Jensen
REG.

SURVEY NO. 1288

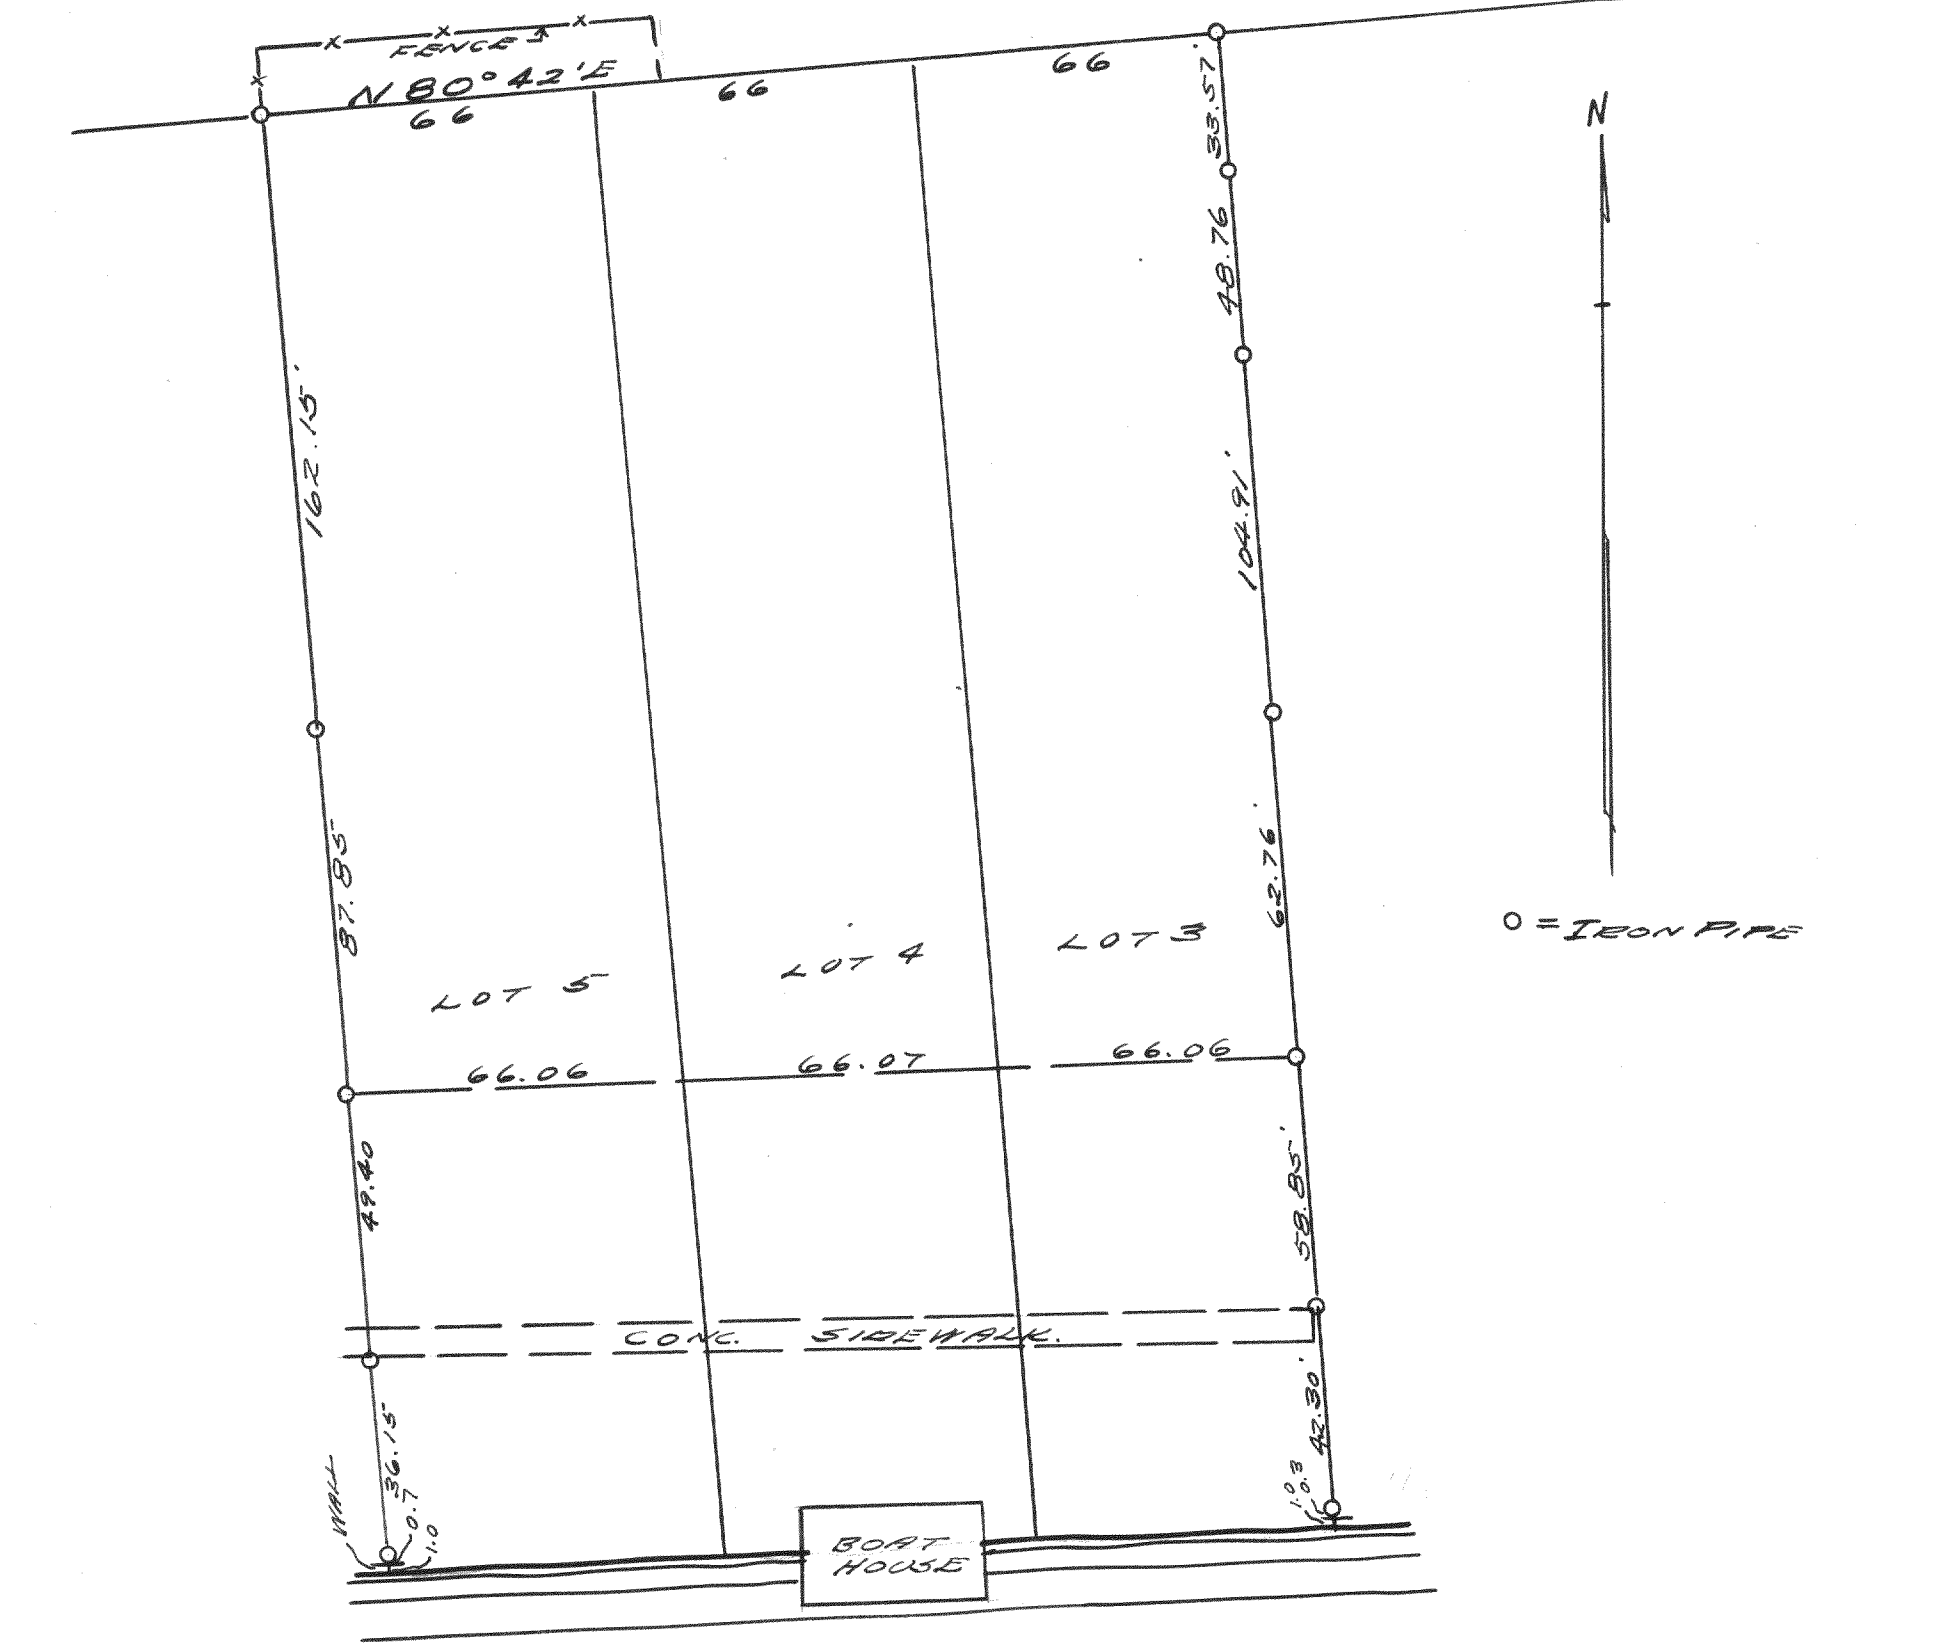

PLAT OF SURVEY OF LOTS 3, 4 & 5
OF ST. MARY'S SUBD. IN THE NW 1/4
SECTION 28 T2N R16E, WALWORTH
COUNTY, WISCONSIN.
FEB., 1942
Lloyd L. Jensen
REG.