



2442

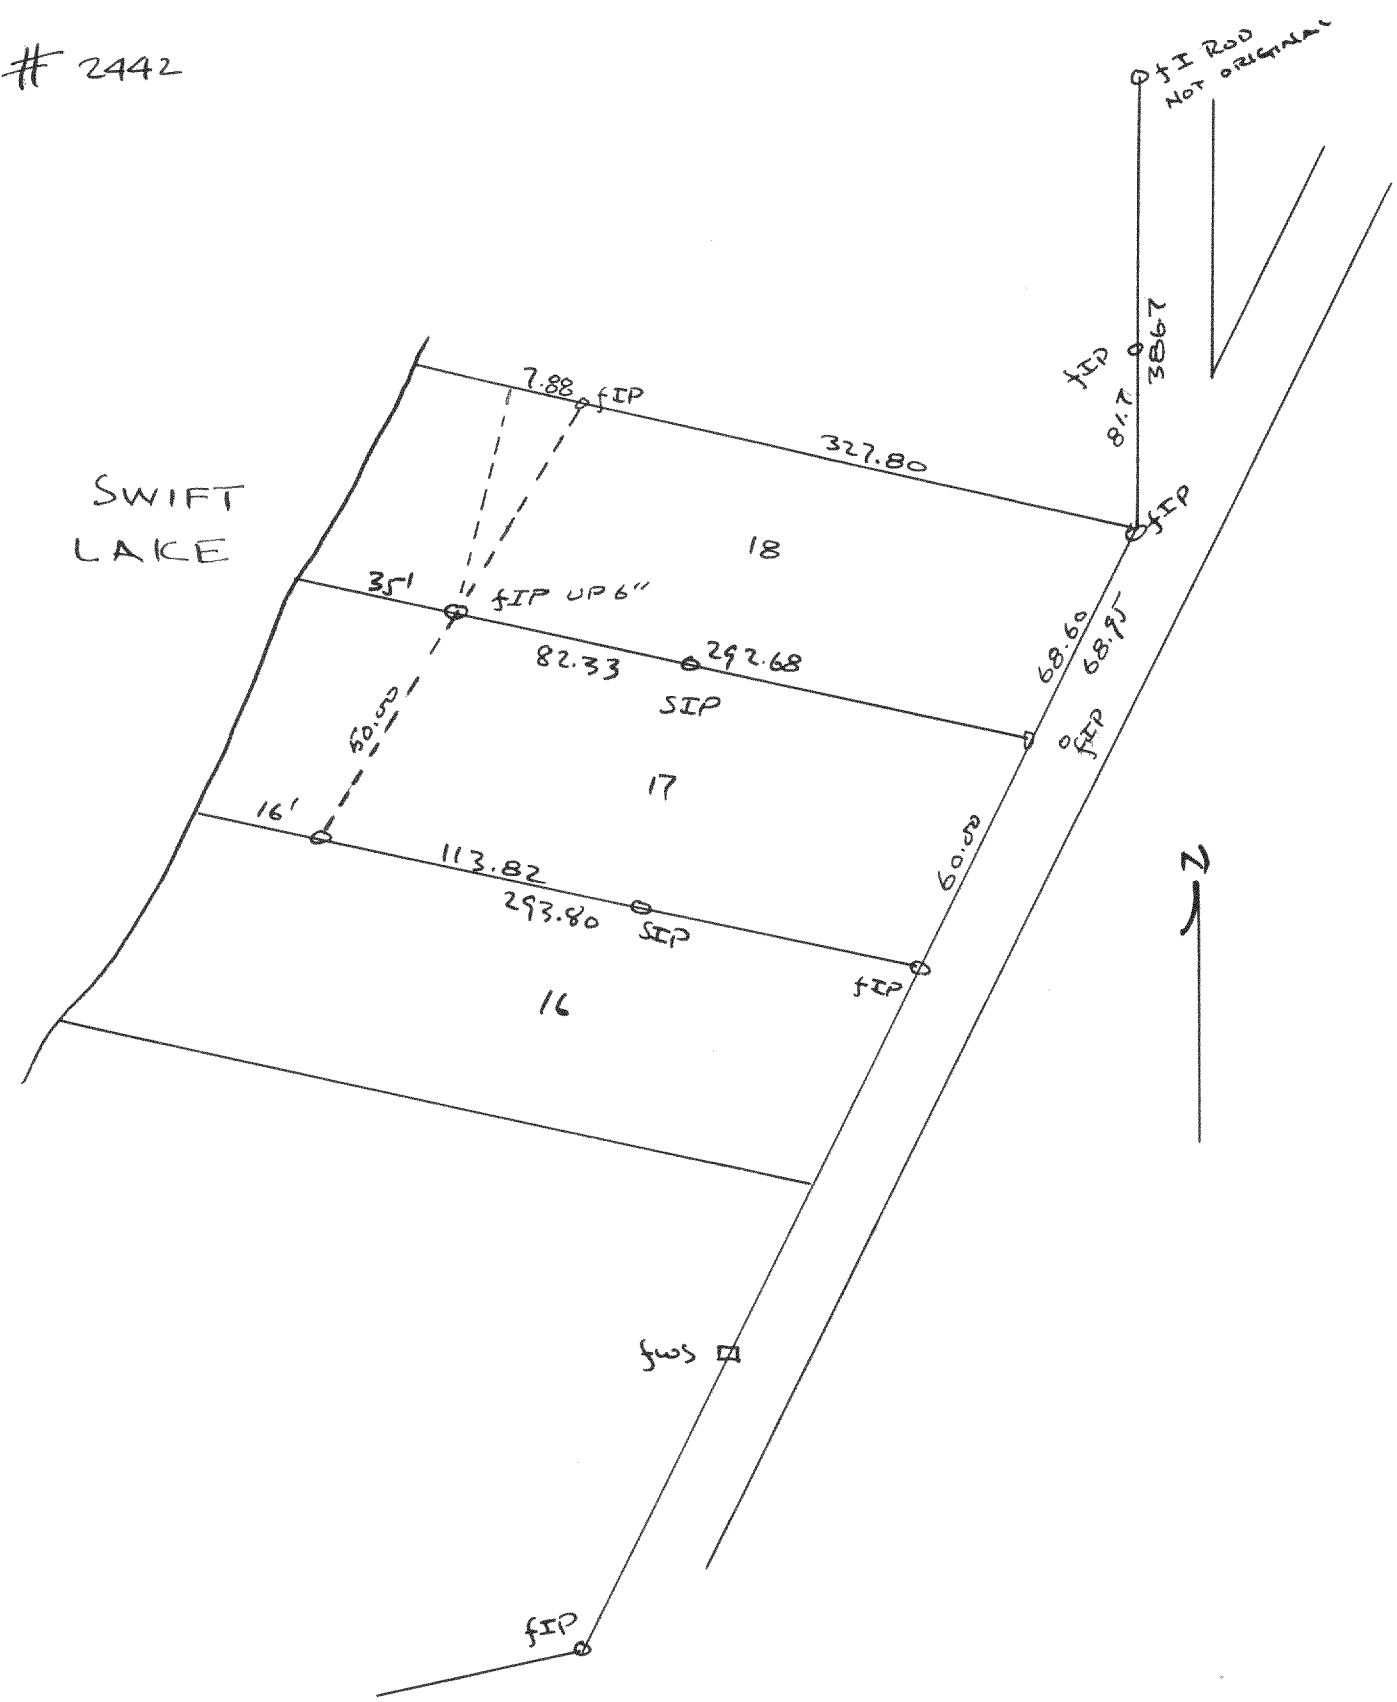

Plat of survey of lots 17, Blk 2 of Swift Lake Subdivision located in Sec. 8, T4N R17E, Walworth County, Wisconsin
 Aug. 27, 1951
 Lloyd S. Jensen reg
 County Surveyor

2443

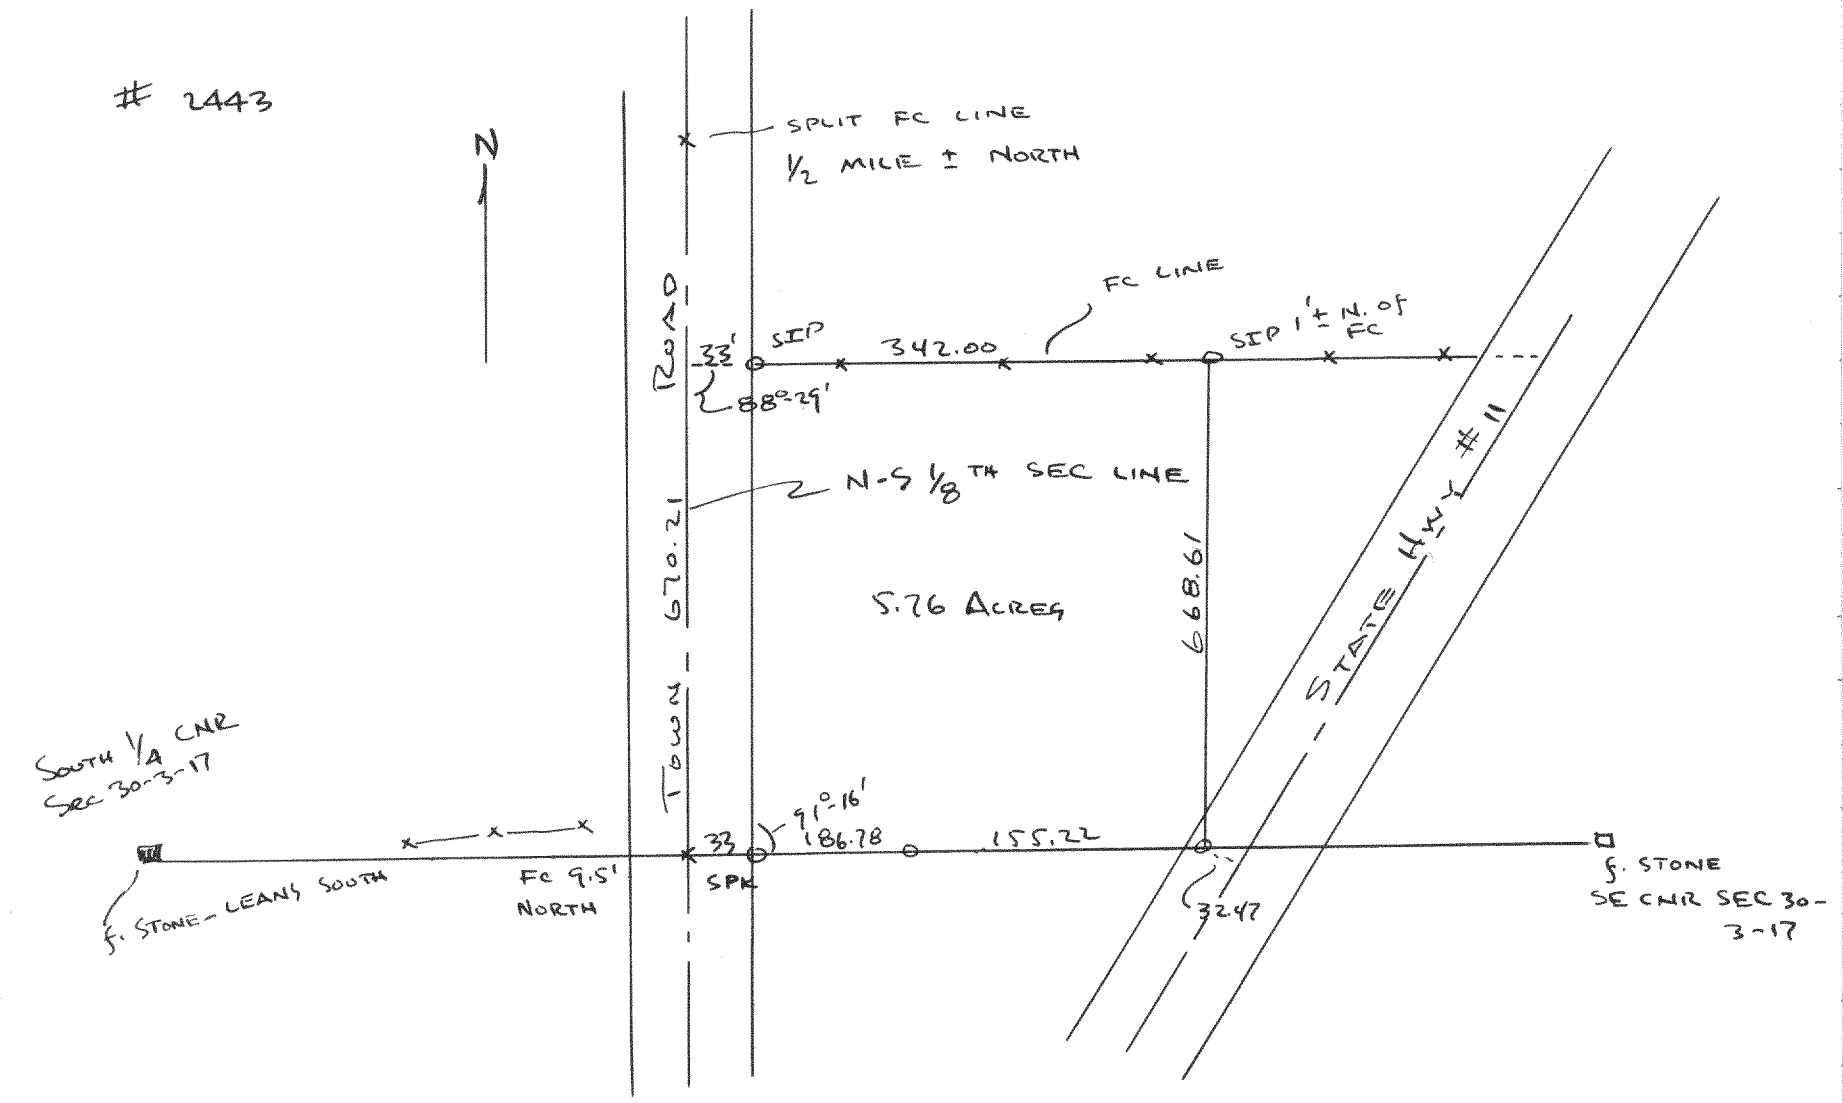

Plat of survey of a parcel of land on the Anderson Farm located in the SE 1/4 of Section 30-T3N R17E, Walworth County, Wisconsin
 Aug. 28, 1951
 Lloyd S. Jensen reg
 County Surveyor