


2444

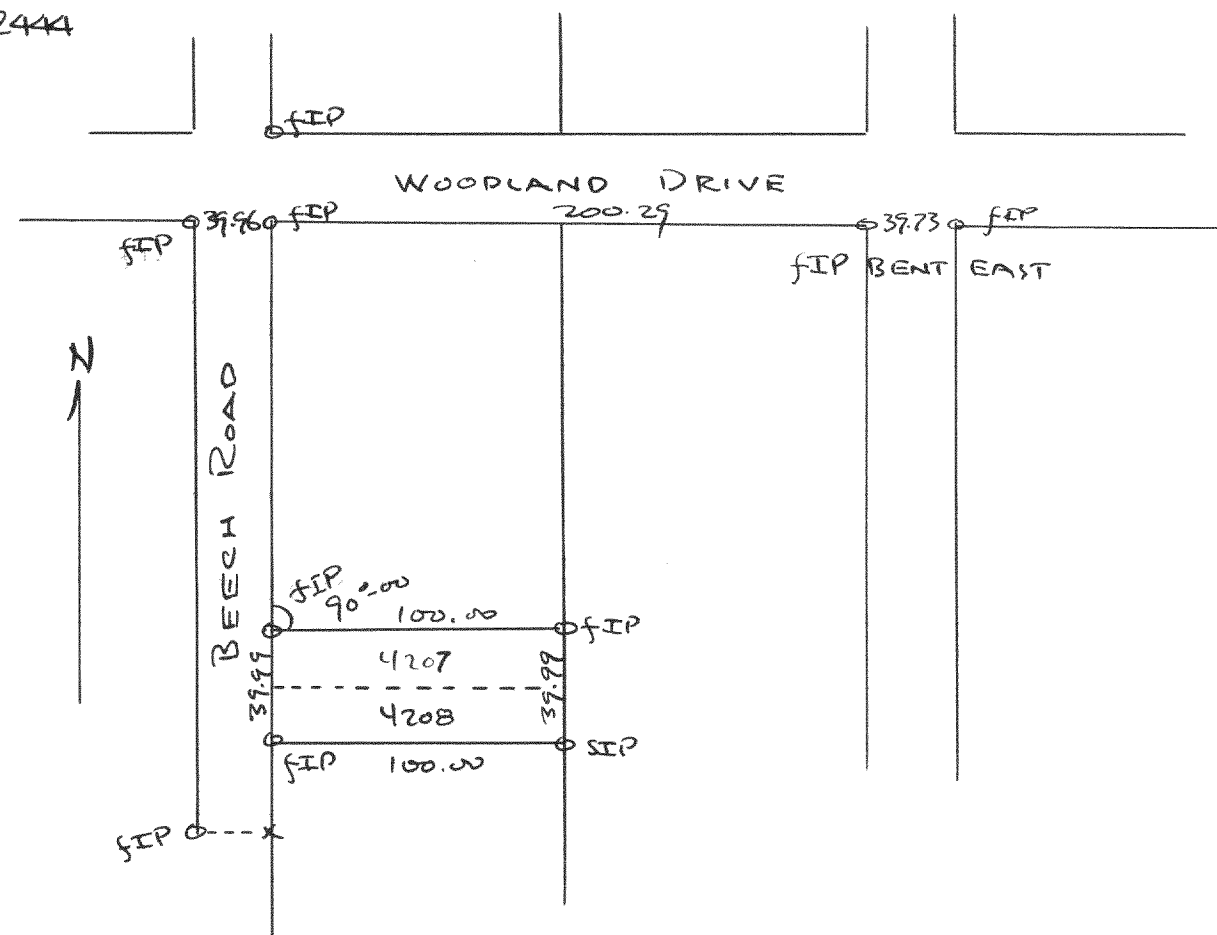


Plat of survey of lots 4207-4208, Lake Como Beach Subdivision
in T2N R17E, Walworth County, Wisconsin

June 9, 1951

Floyd L. Jensen
County Surveyor

2446

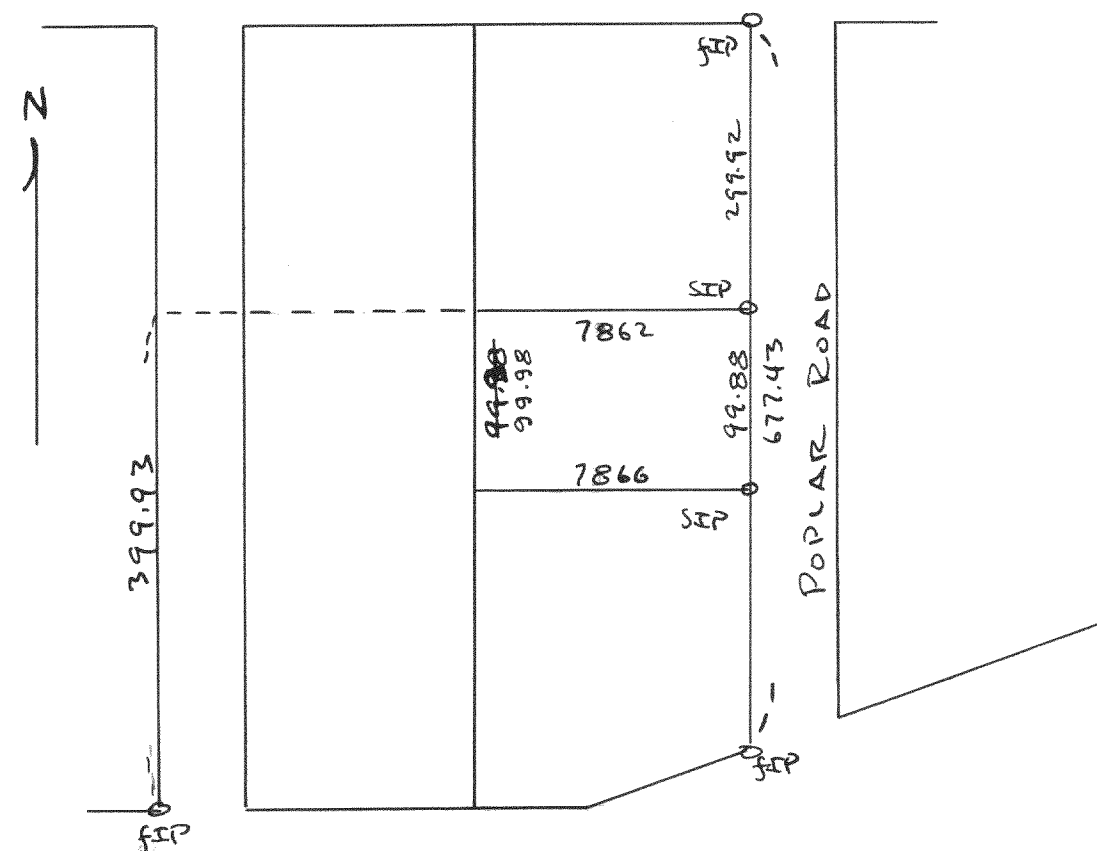


Plat of survey of lots 7862-7866, Lake Como Beach Subdivision
located in T2N R17E, Walworth County, Wisconsin

July 14, 1951

Floyd L. Jensen
County Surveyor

2445

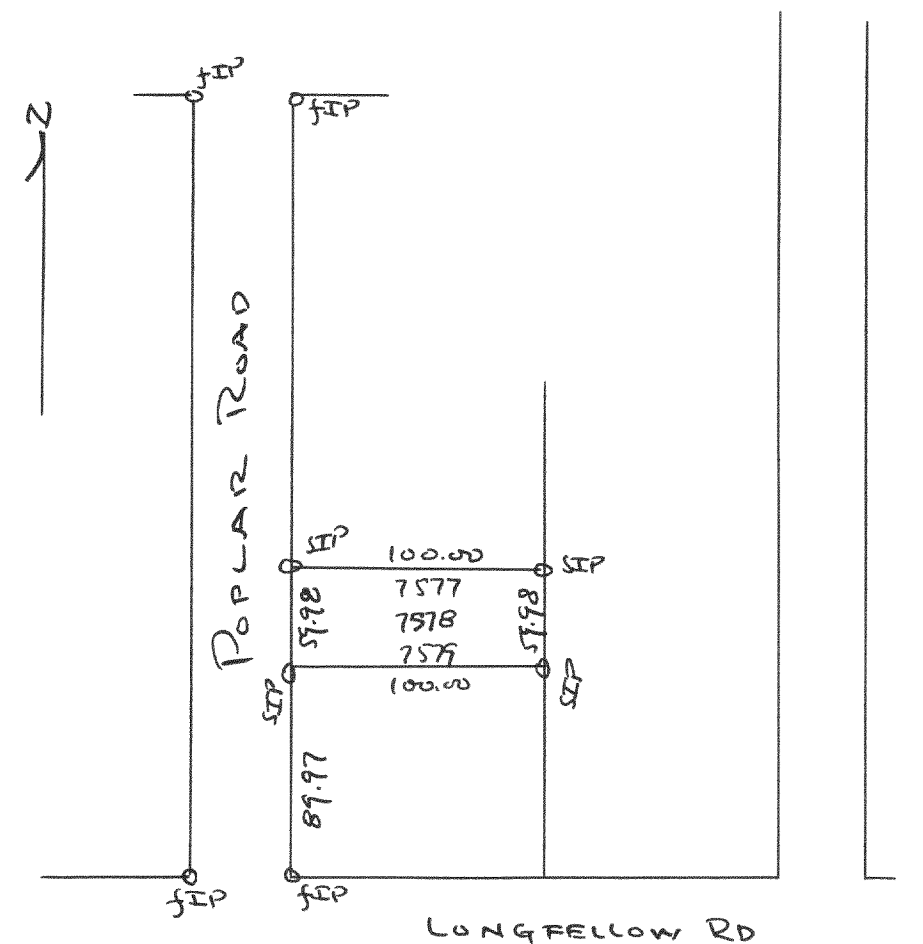


Plat of survey of lots 7577-7579 Lake Como Beach Subdivision
in T2N R17E, Walworth County, Wisconsin

July 10, 1951

Floyd L. Jensen
County Surveyor

2447

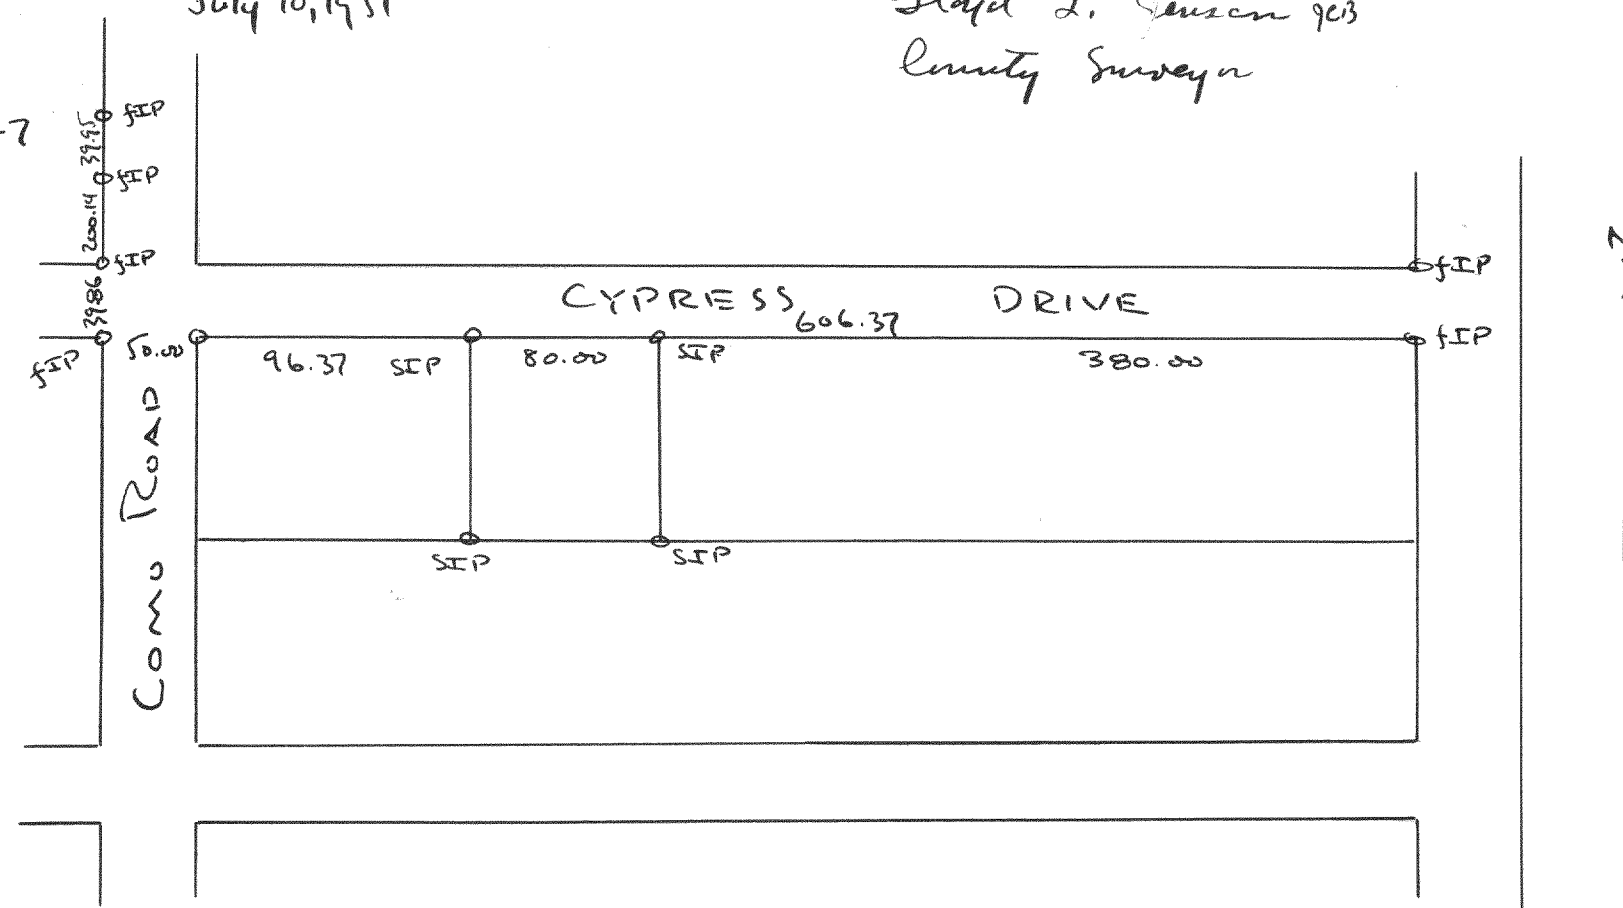

Plat of survey of lots 8947-8950 of Lake Como Beach Subdivision located
in T2N R17E, Walworth County, Wisconsin

Aug 1, 1951

Floyd L. Jensen
County Surveyor