



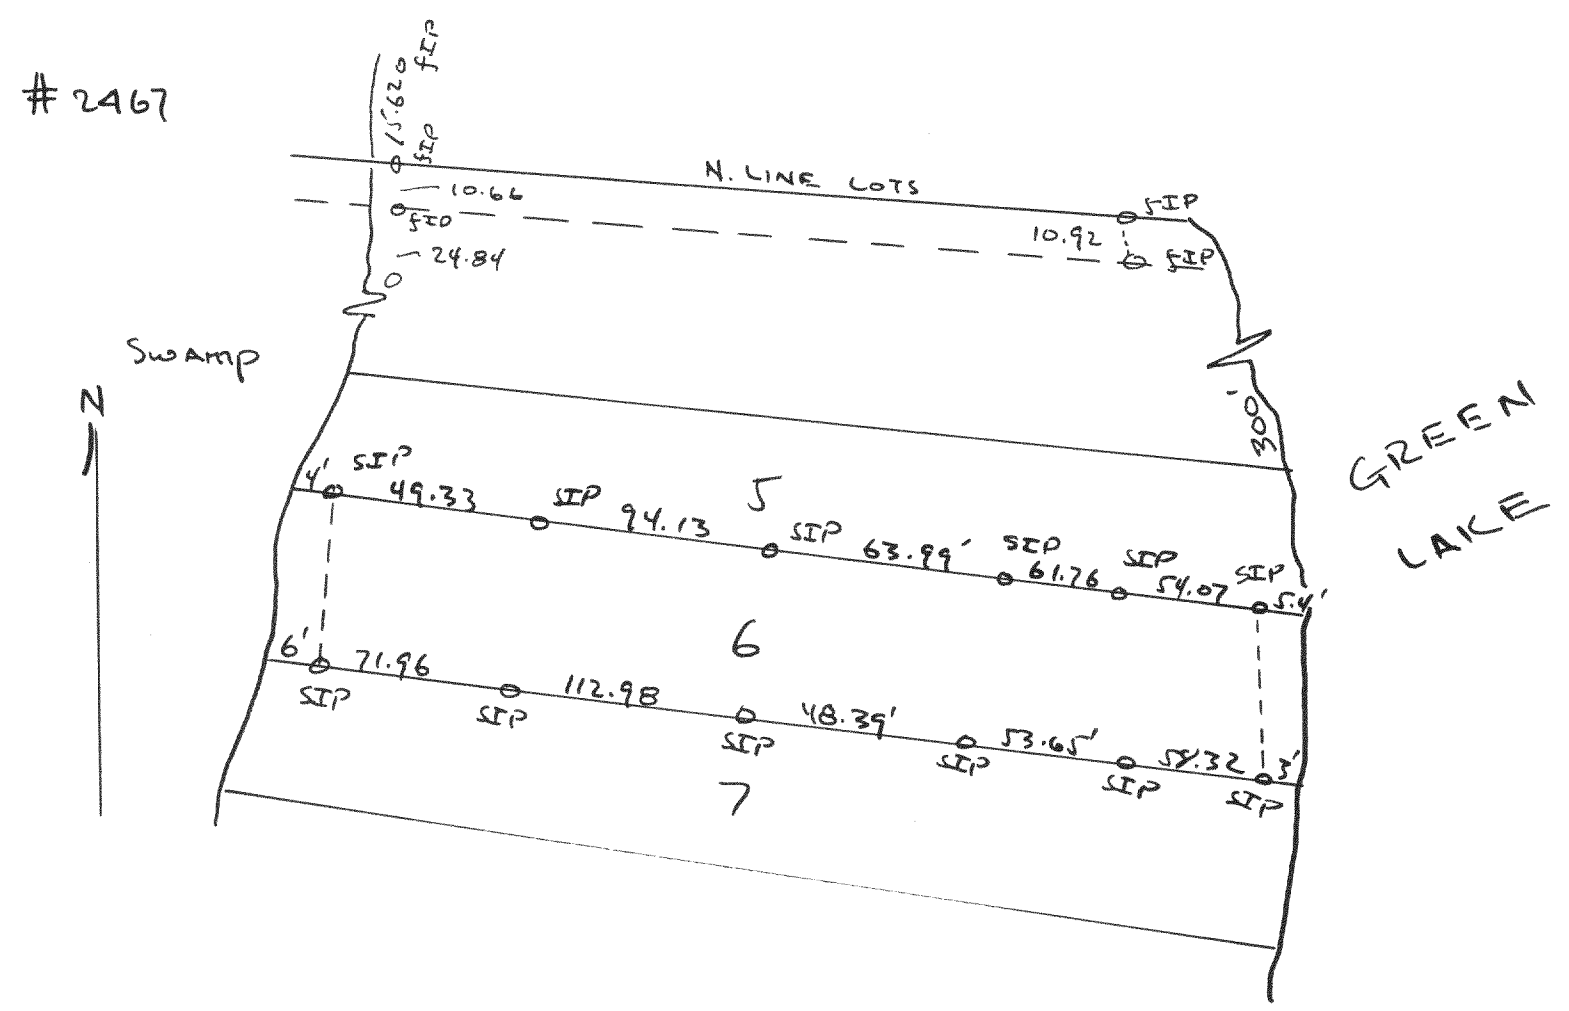

Plot of survey of lot 6 of Ingerside Point Subdivision located in the SE 1/4 of Section 26, T4N R16E of Walworth County, Wisconsin Aug. 24, 1951
 Floyd L. Jensen 9213
 County Surveyor

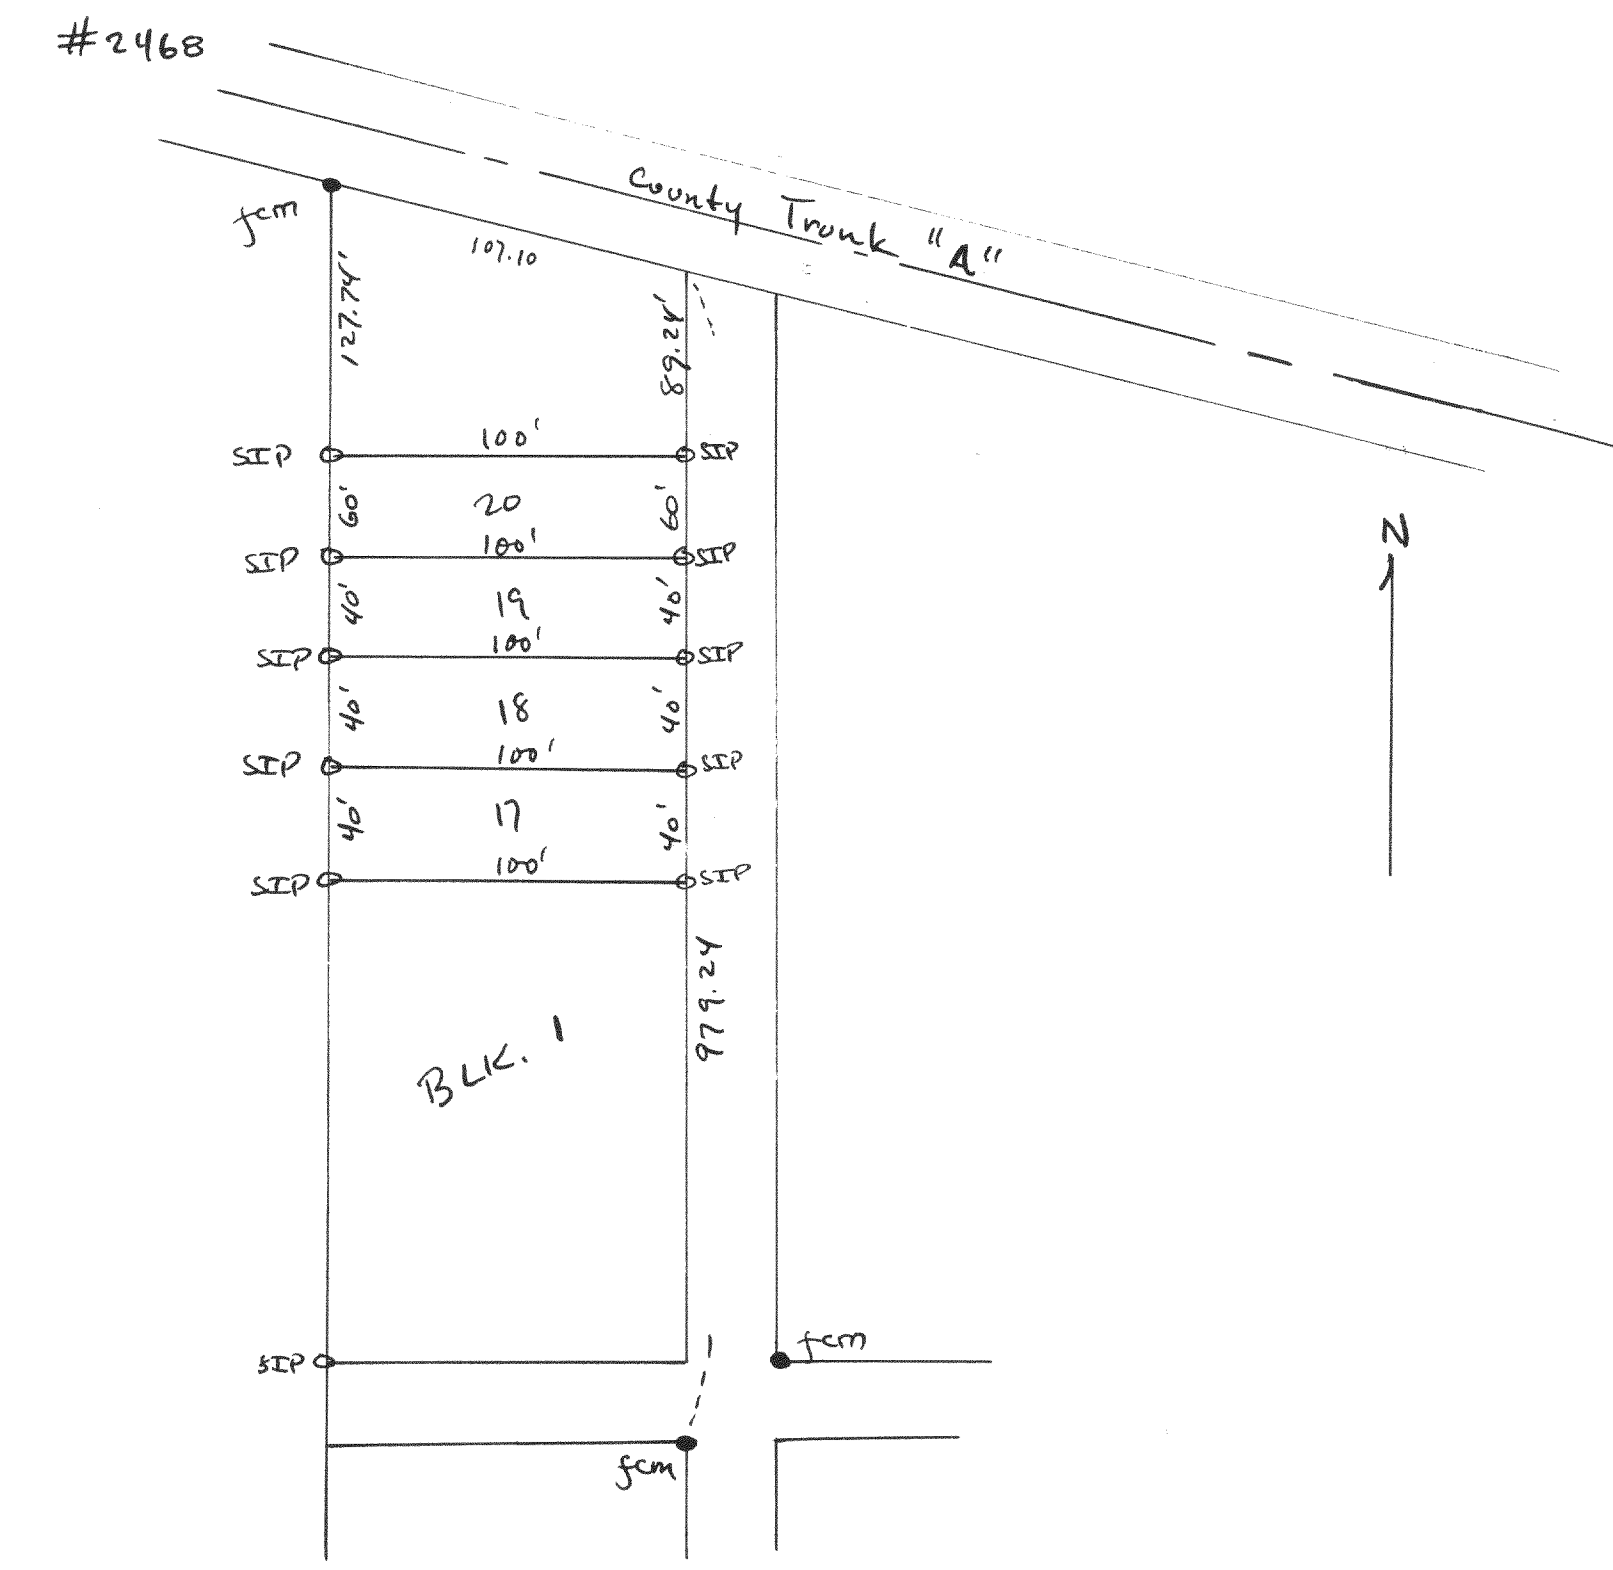

Plot of survey of lots 17-20, Block 1, Interlaken Subdivision located in Section 11, T3N R16E, Walworth County, Wisconsin Jan'y 23, 1951
 Floyd L. Jensen 9213
 County Surveyor