



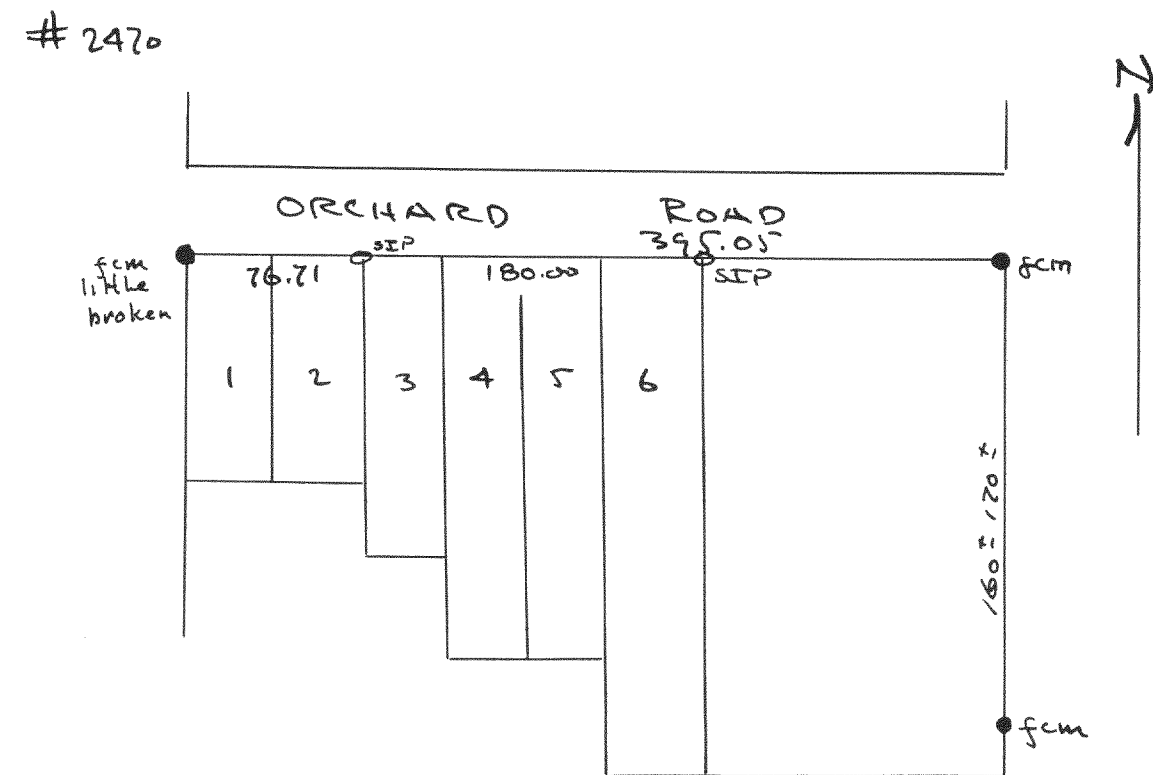


Plat of survey of the north line of lots 3-6
Block 37 of Interlaken Subdivisions located in Sec. 11 T3N R16E
of Walworth County, Wisconsin
July 23, 1951
Ryd L. Jensen rec

Royd L. Jensen 1923
County Surveyor

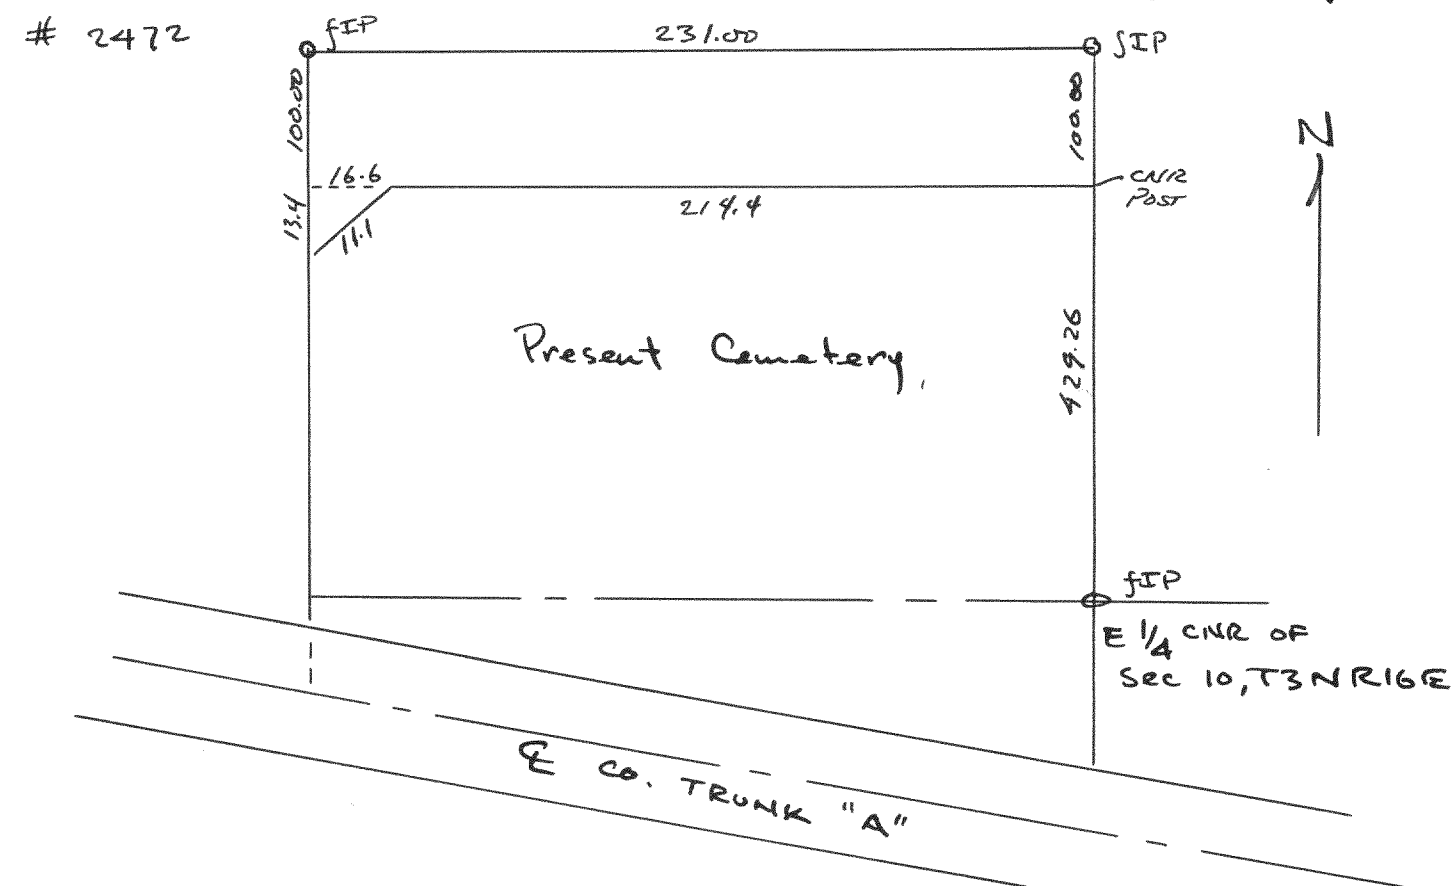

Plat of survey of 100' strip of land along the North line
of Sugar Creek Cemetery located in Section 10, T3N R16E,
Walworth County, Wisconsin
Sept 12, 1951
Sloyd L. Jensen geob

Floyd L. Jensen 923
 County Surveyor

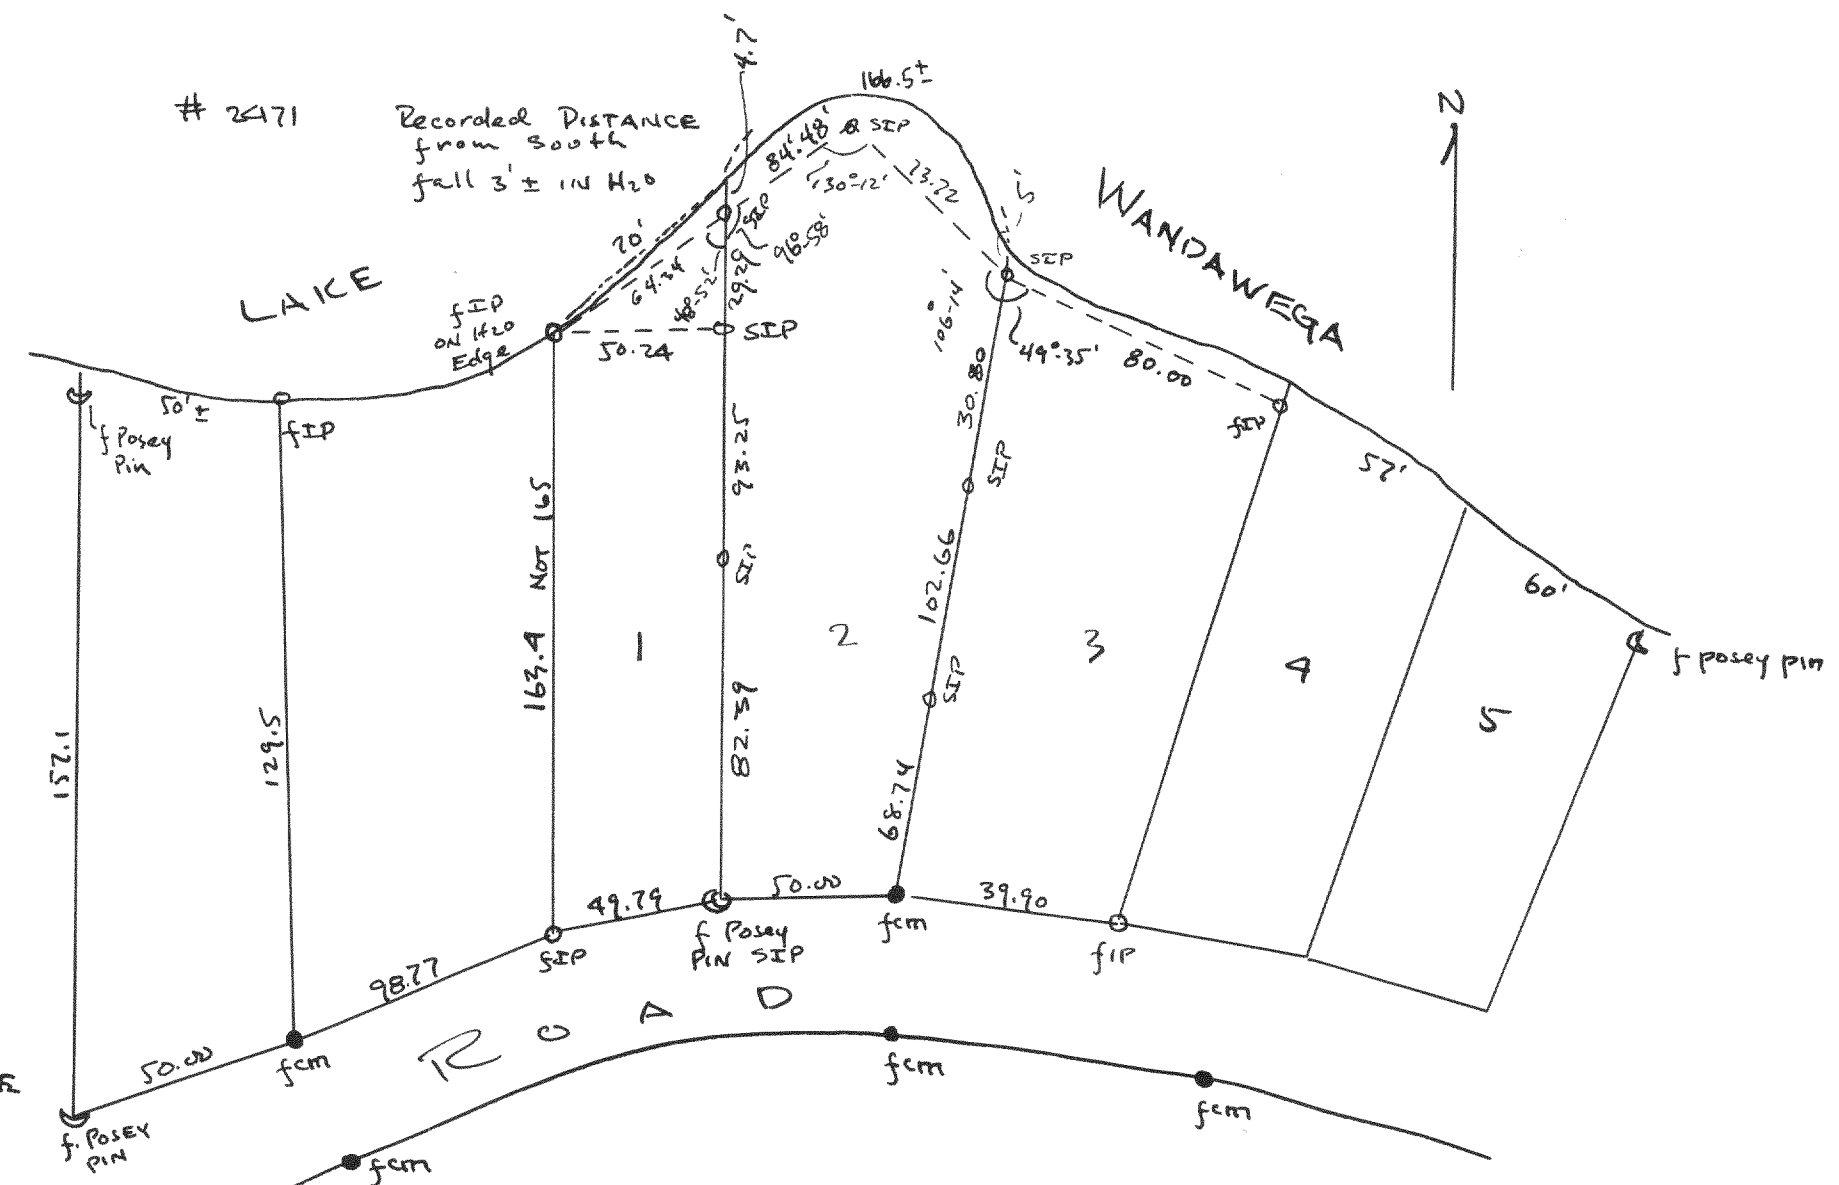

Plat of survey of lot 2, Block 2, Lake Wandauegan Subdivision
located in Section 12, T3N R16E Walworth County, Wisconsin
Aug 22, 1951
Ray L. Jensen 4013

Shy L. Jensen 423
County Surveyor