



2473

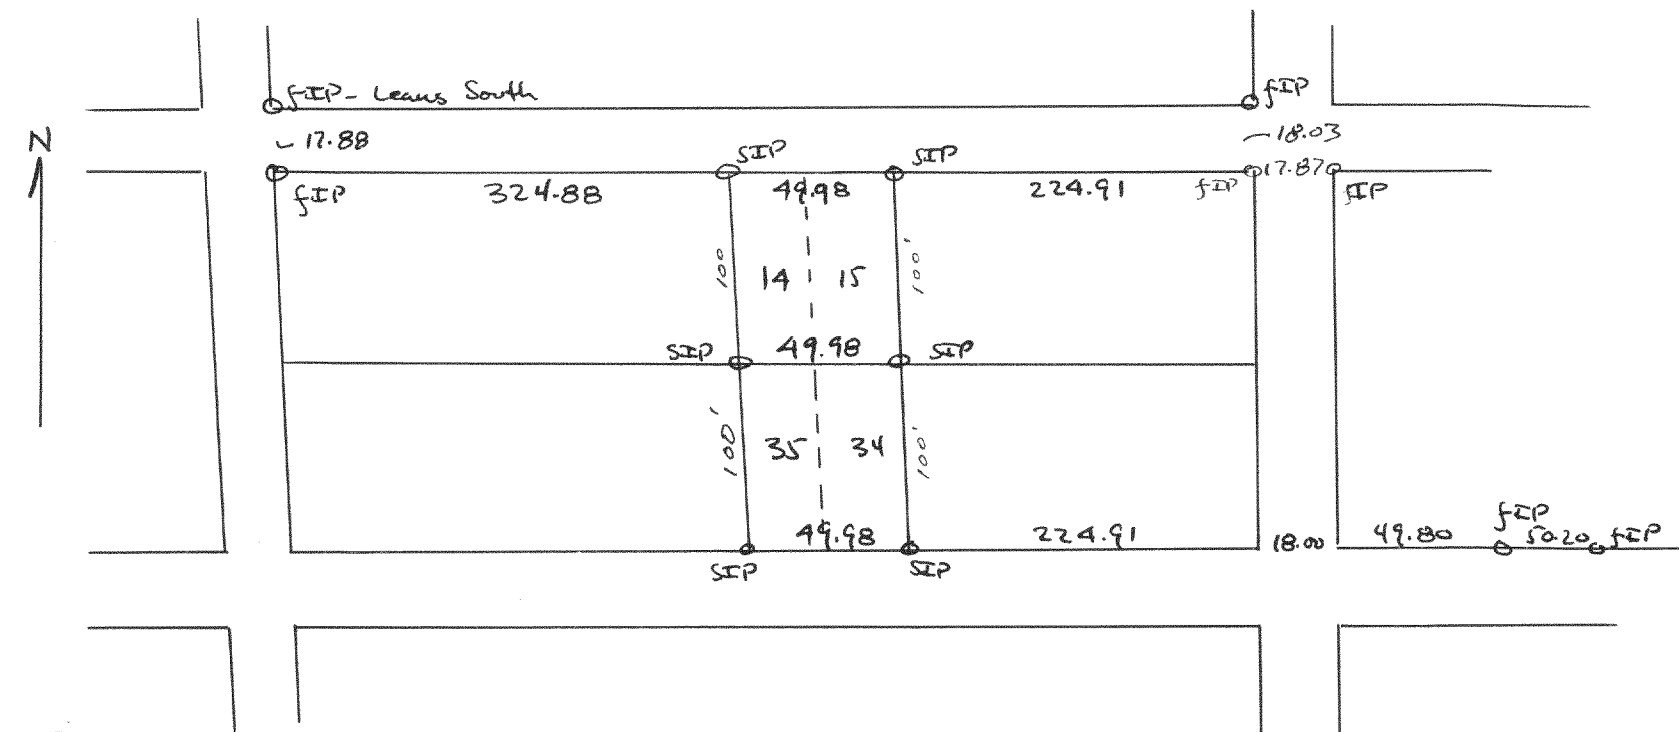


Plat of survey of lots 14-15, 34-35 of Block 102, Lake Waukegan
Subdivision located in Section 1, T3N R16E of Walworth County, Wisconsin
Sept 19, 1951
Lloyd L. Jensen 9213
County Surveyor

2475

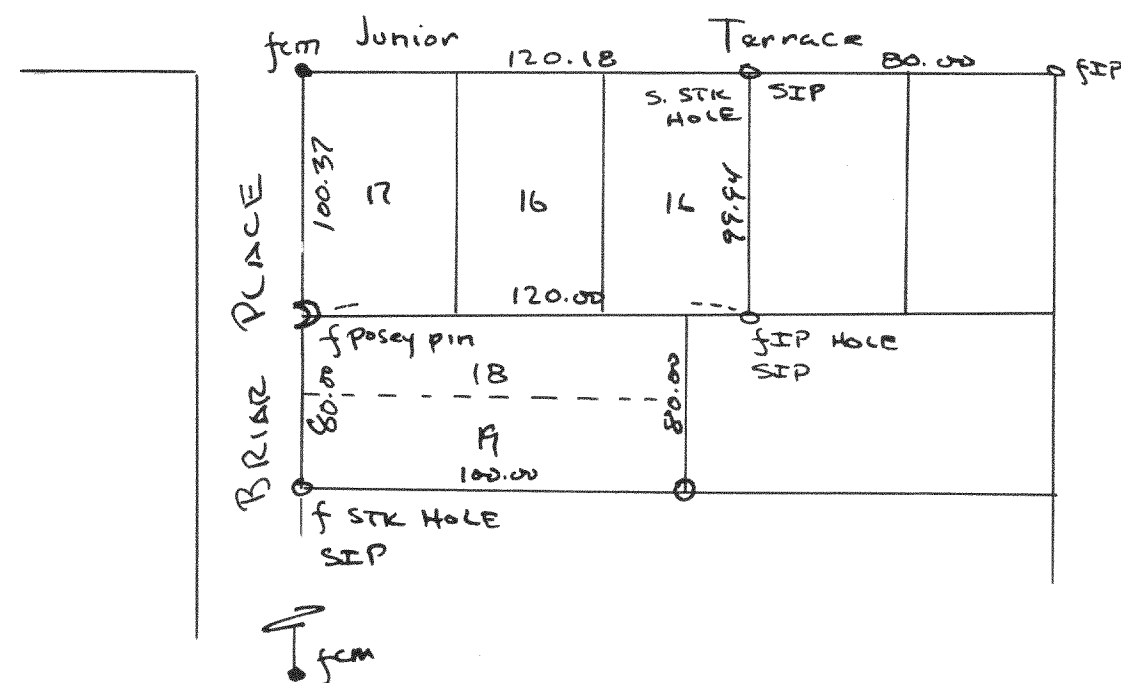

Plat of survey of lots 15-19 Block 11 of South Shore
Manner, 1st add located in the SE 1/4 of Section 32
T2N R16E, Walworth County, Wisconsin
March 20, 1951
Lloyd L. Jensen 9213
County Surveyor

2474

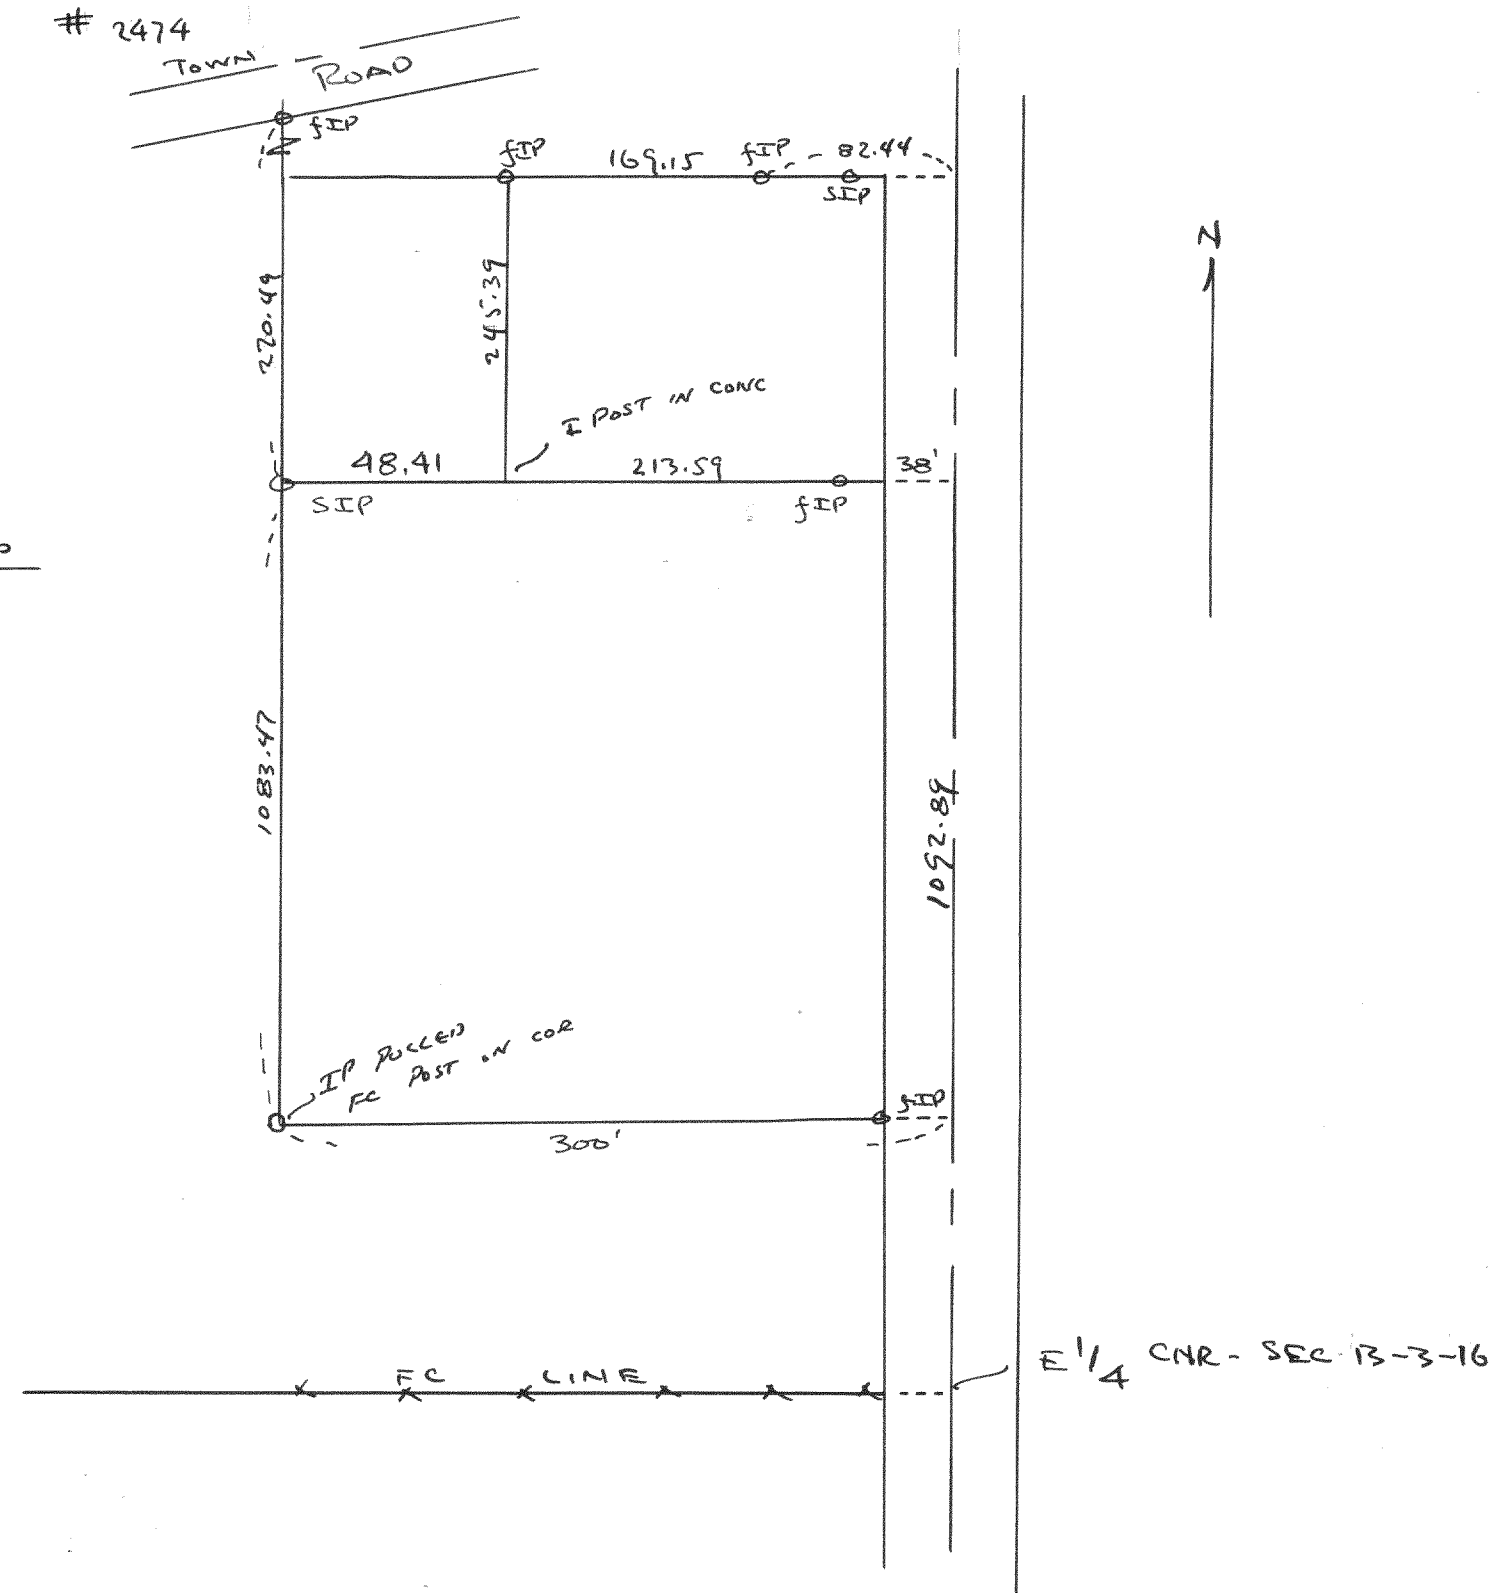

Plat of survey of land south of Griggs located in
Section 13, T3N R16E of Walworth County, Wisconsin
Oct 8, 1951
Lloyd L. Jensen 9213
County Surveyor