



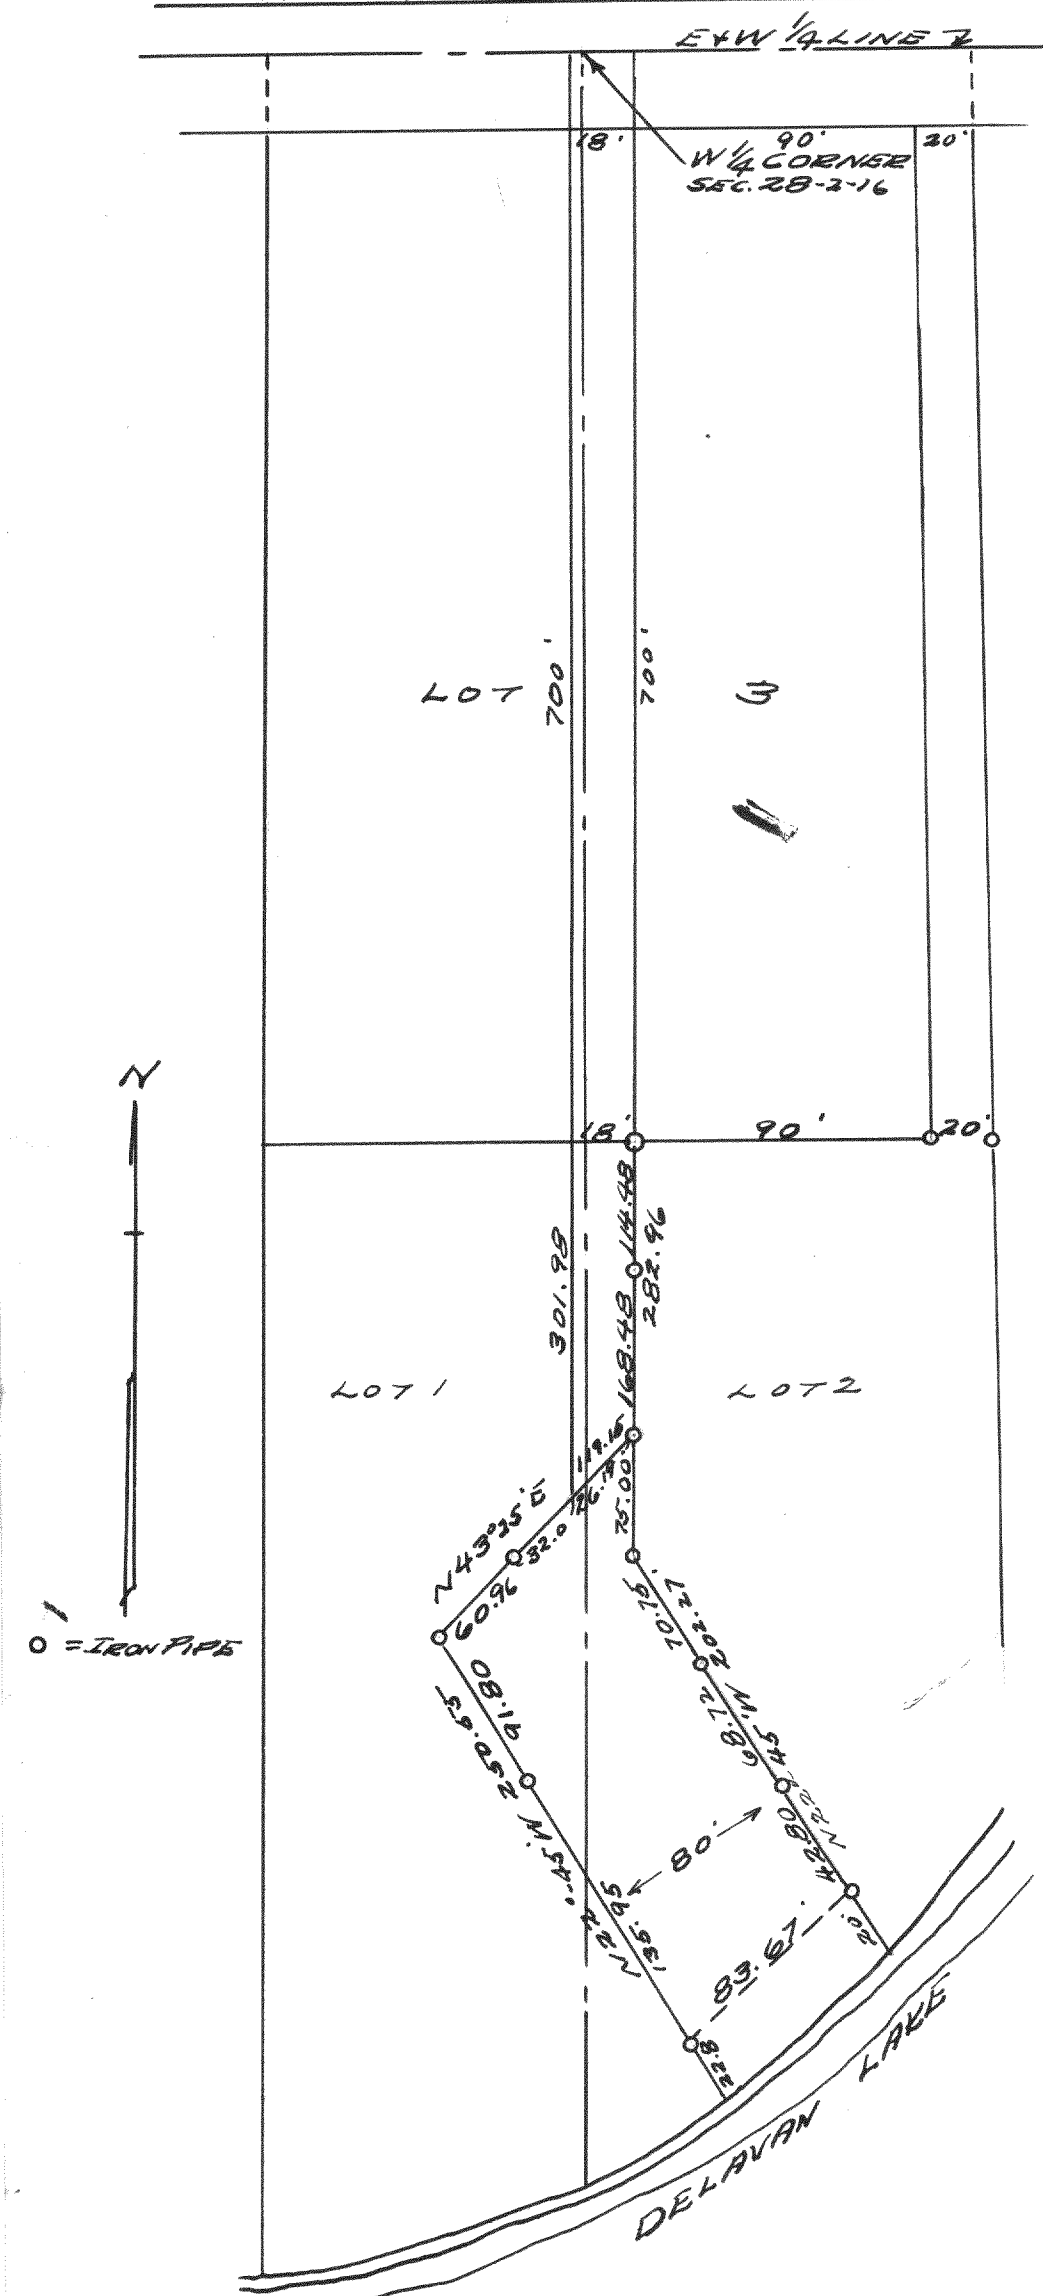

PLAT OF SURVEY OF PART OF
GLENVIEW SUBD. IN 28+29-2-16
DEC. 29, 1941 *Lloyd L. Jensen*

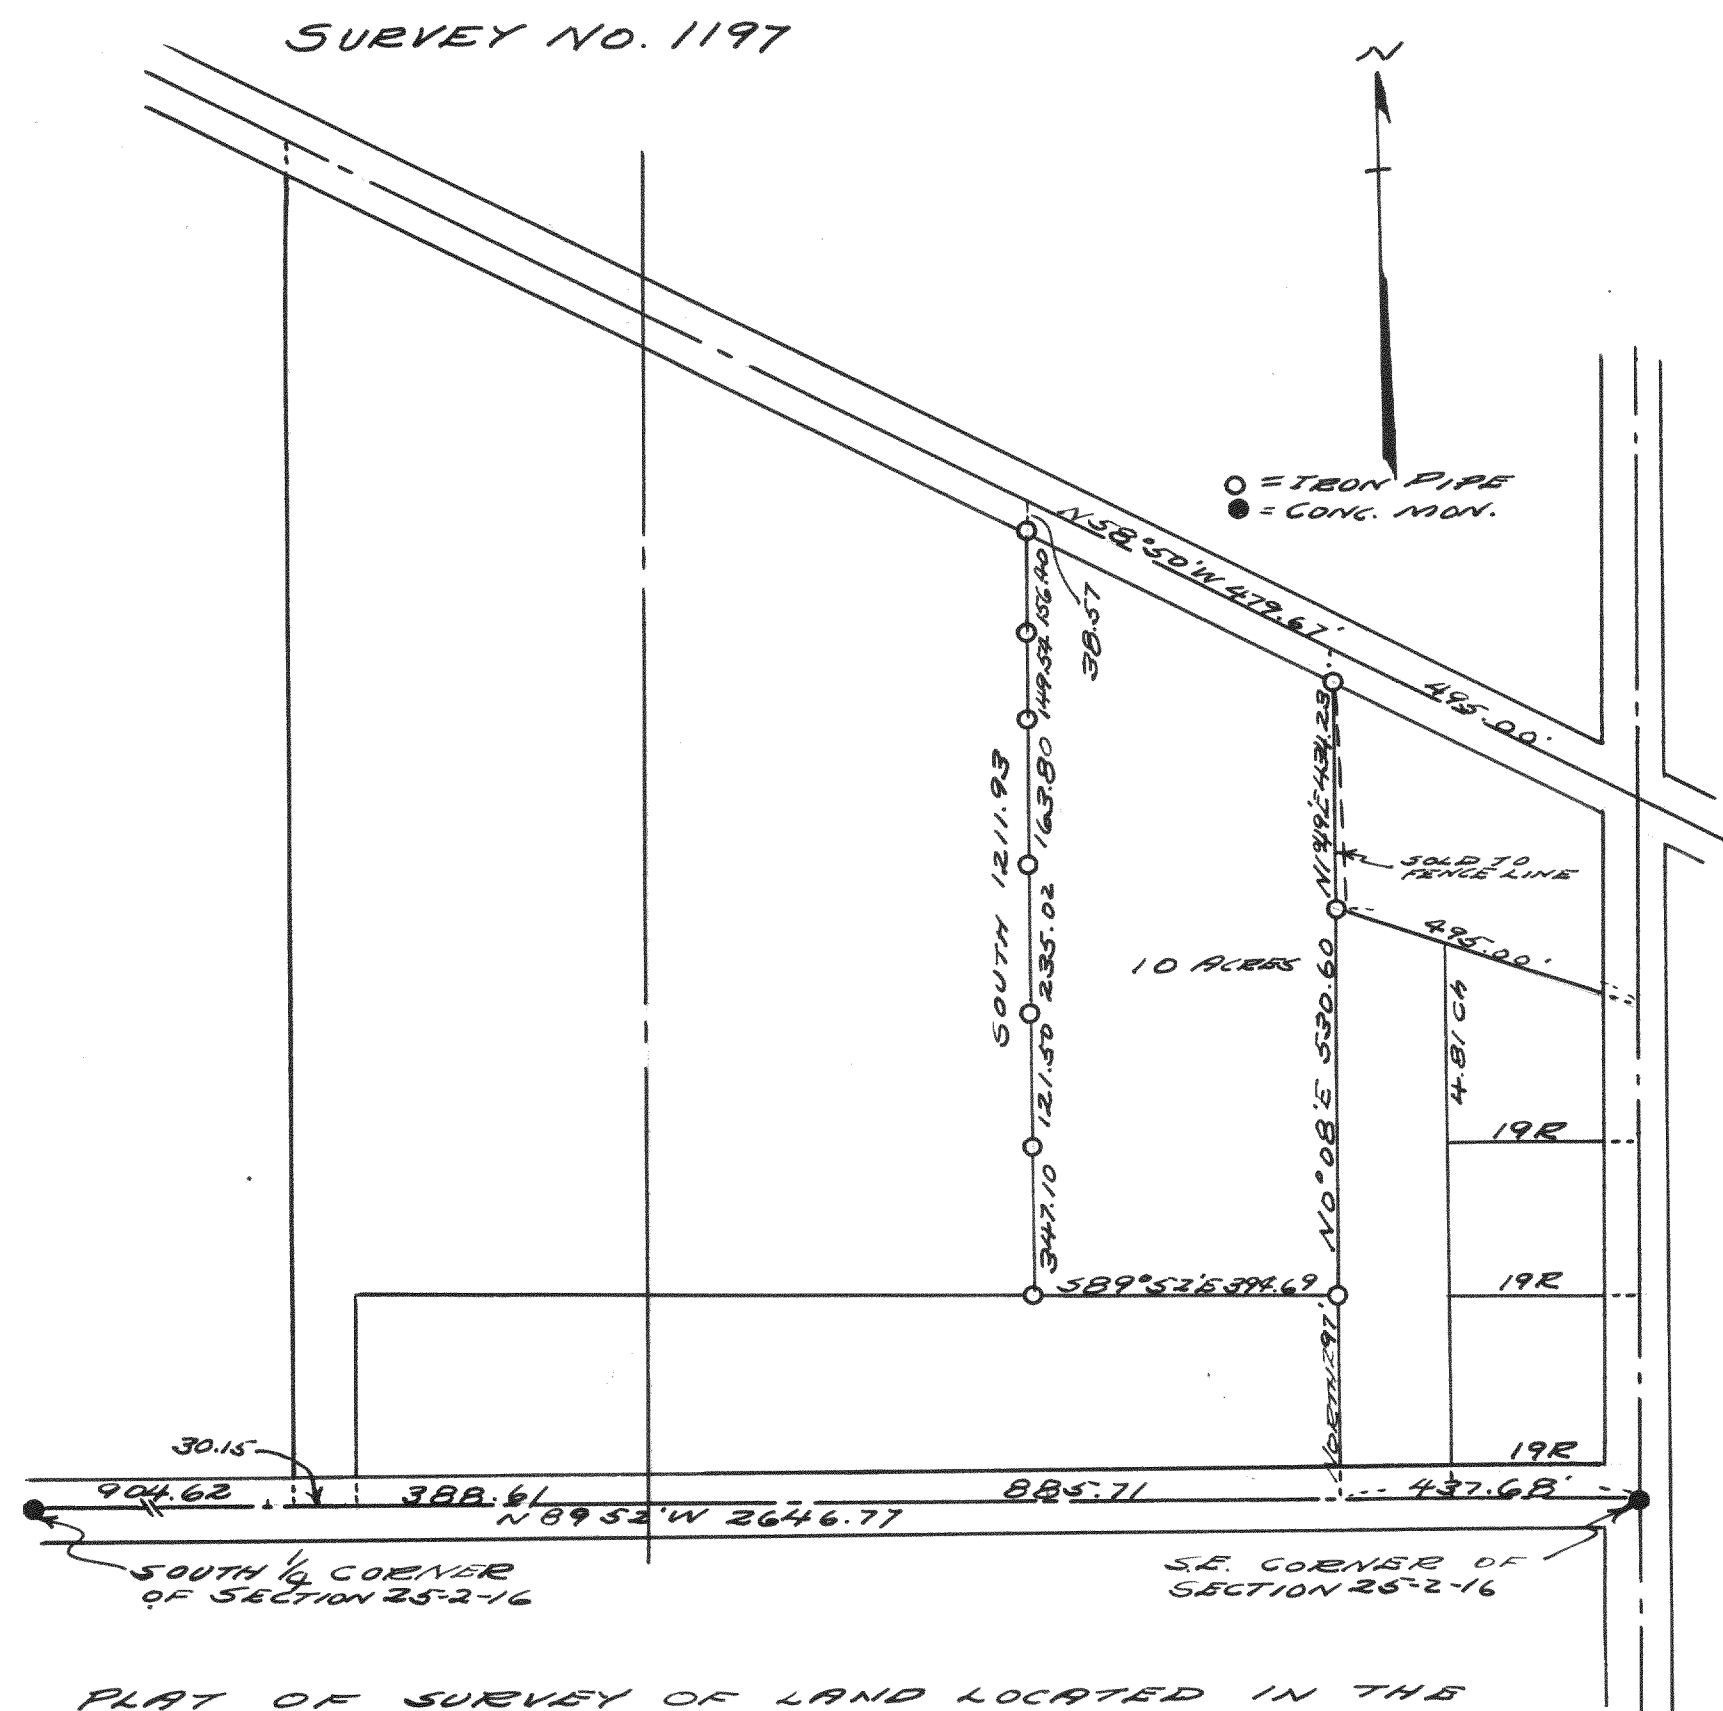

PLAT OF SURVEY OF LAND LOCATED IN THE
 SOUTHEAST $\frac{1}{4}$ OF SECTION 25 T2N R16E, WALWORTH
 COUNTY, WISCONSIN
 JAN. 5, 1942

Lloyd L. Jensen
H.E.F.