



#2509

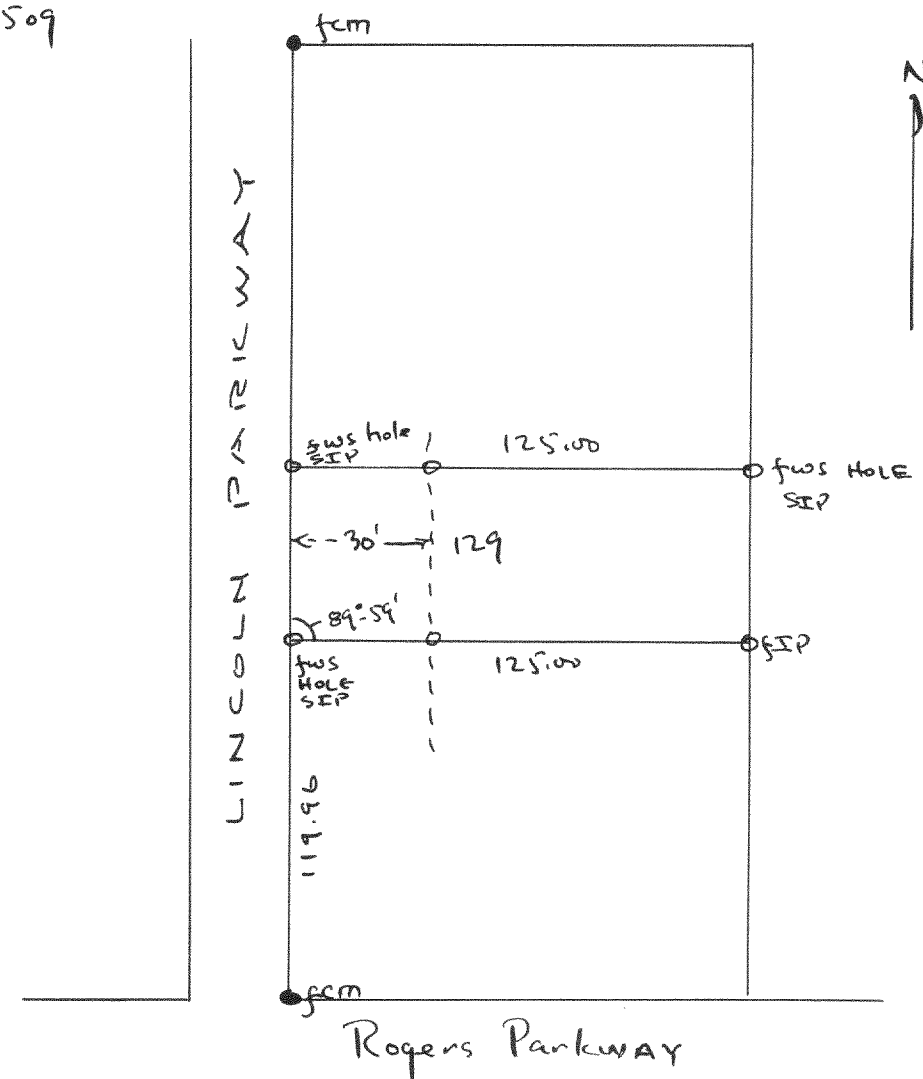

Plat of survey of lot 129 of Cedar Point Park Original Subdivision to the Village of Williams Bay in Section 6, T1N R17E, Walworth County, Wisconsin
March 26, 1951

Lloyd L. Jensen JEB
County Surveyor


#2511

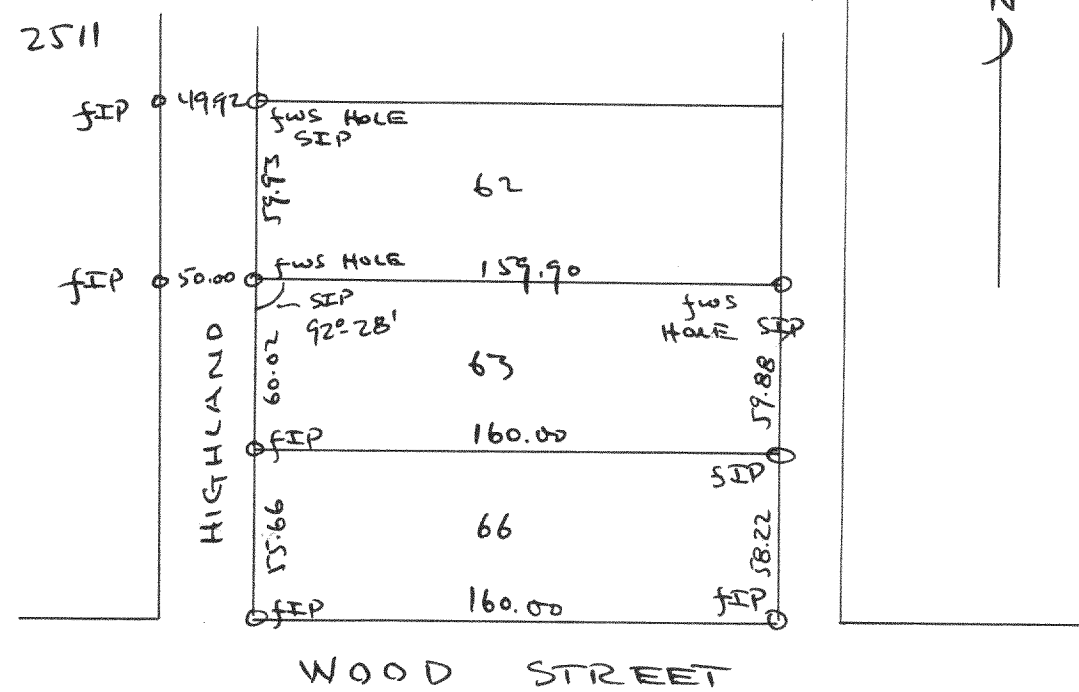

Survey of lot 63 & front line of lot 62, Bay View Subdivision
Village of Williams Bay, Section 1, T1N R16E, Walworth County, Wisconsin
May 29, 1951

Lloyd L. Jensen JEB
County Surveyor


#2510

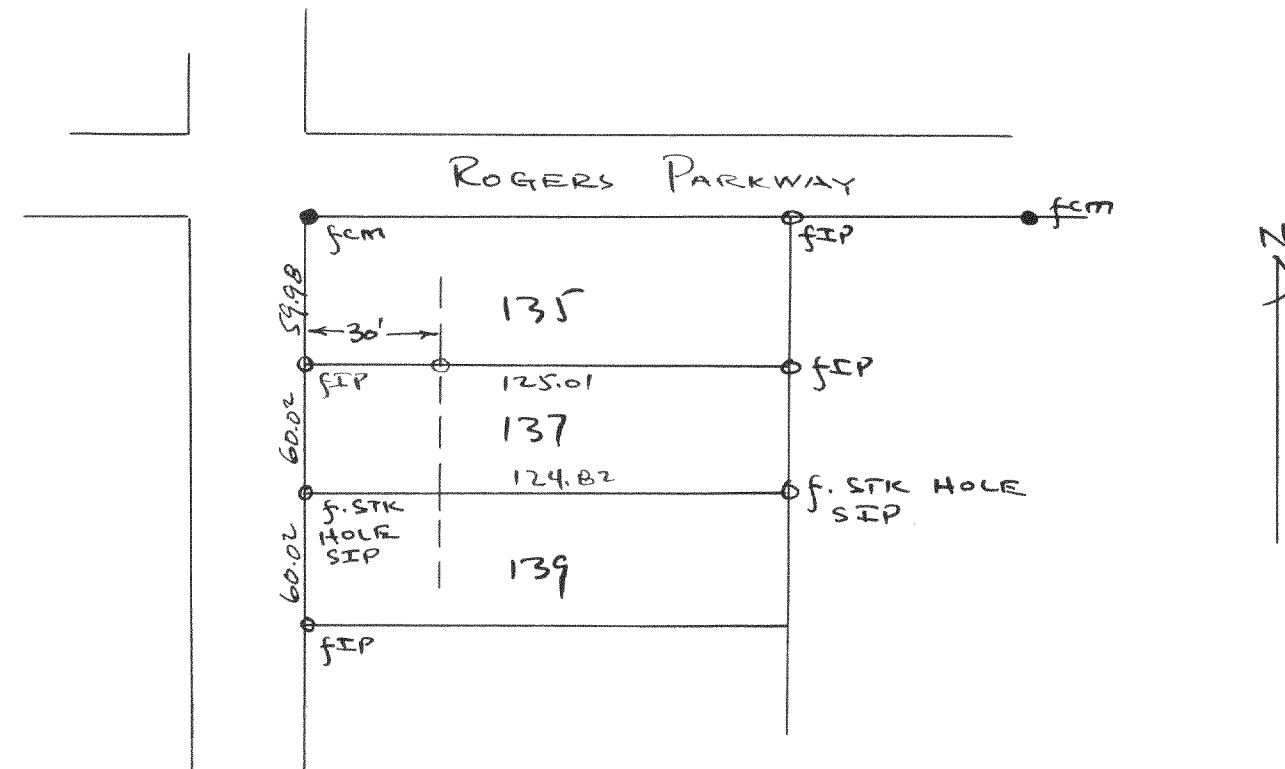

Plat of survey of lots 135, 137, & 139 of Cedar Point Park Original Subdivision in the Village of Williams Bay, Section 6, T1N R17E, Walworth County, Wisconsin
May 25, 1951

Lloyd L. Jensen JEB
County Surveyor

#2512

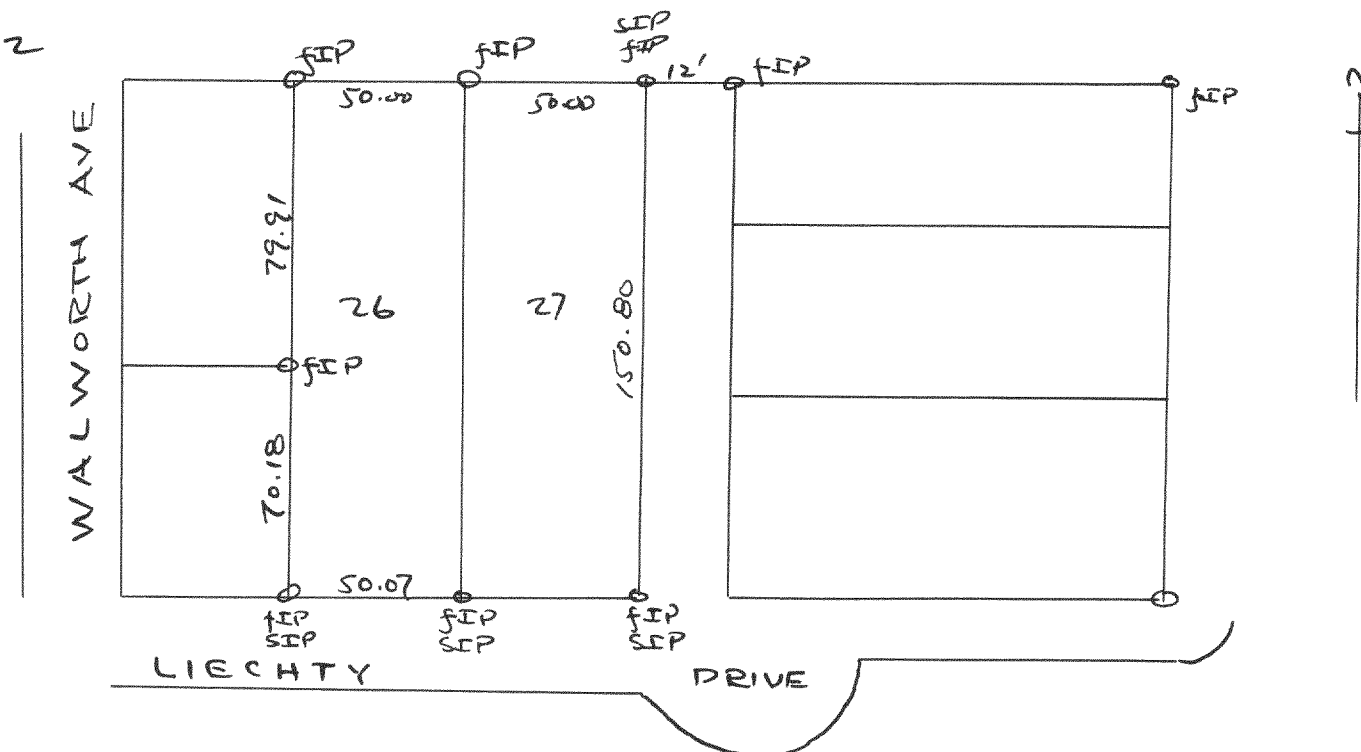

Plat of survey of lots 26 & 27, Summer Haven in Village of Williams Bay, Section 1, T1N R16E, Walworth County, Wisconsin
May 29, 1951

Lloyd L. Jensen JEB
County Surveyor