



2513

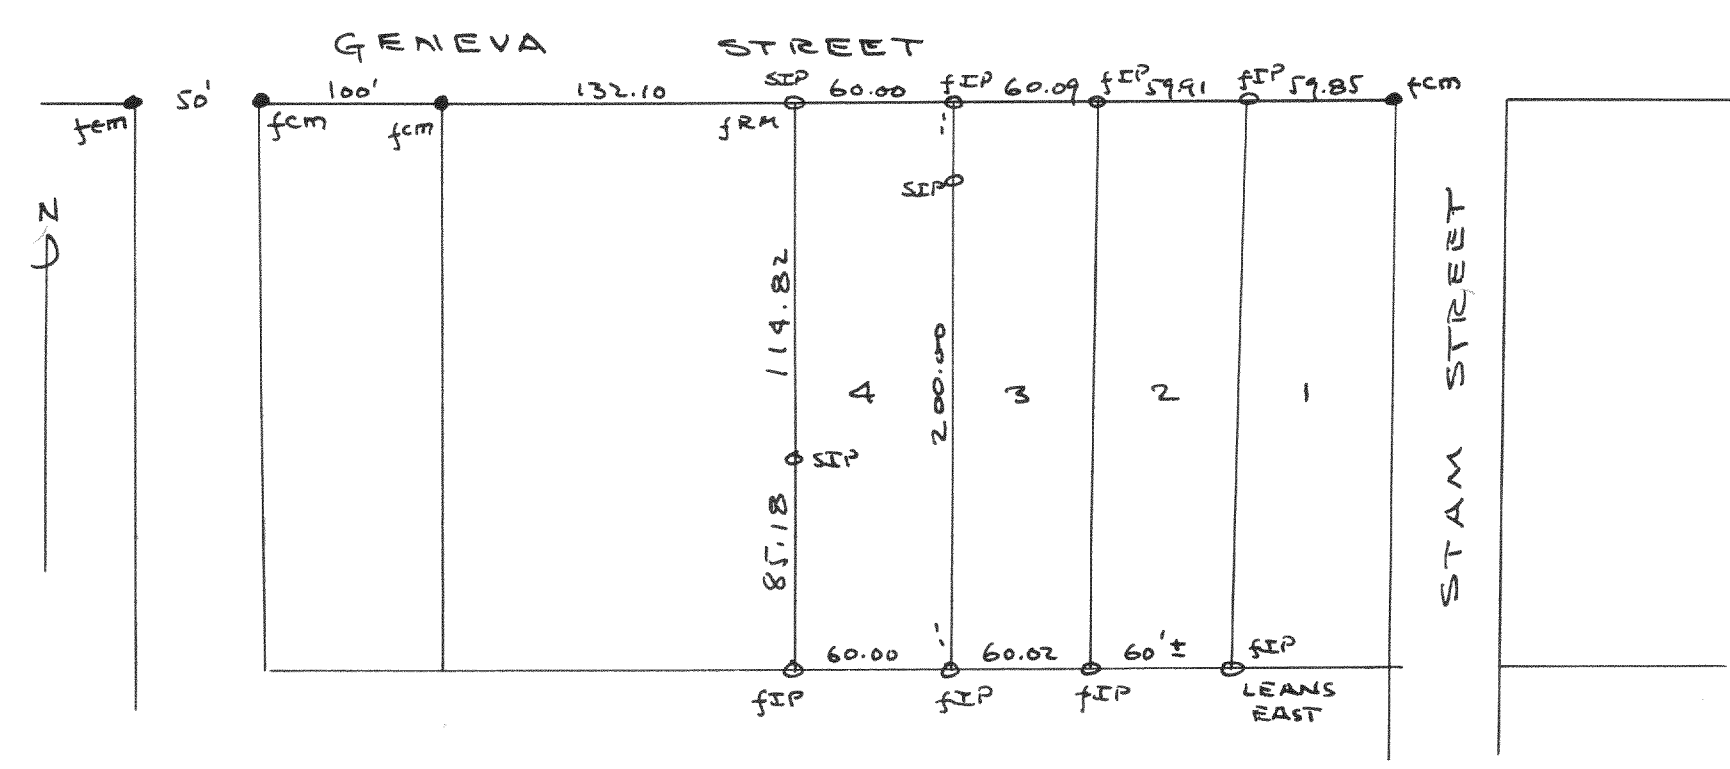


Plat of survey of lot 4, Wm. Pearsons Subdivision, Village of Williams Bay, Section 1, T1N R16E, Walworth County, Wisconsin
July 10, 1951
Floyd L. Jensen JCB
County Surveyor

2514

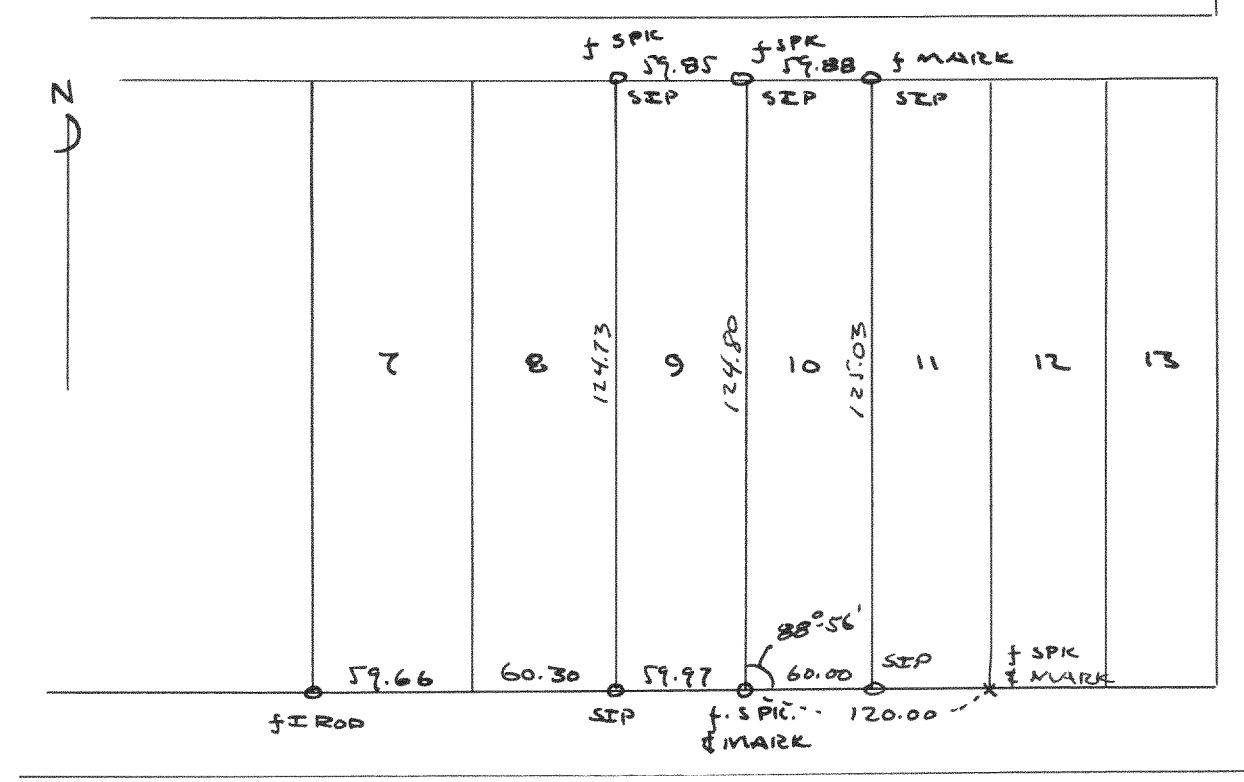


Plat of survey of lots 9 & 10, Lackey Bros. Subdivision, Village of Williams Bay, Section 1, T1N R16E, Walworth County, Wisconsin
July 20, 1951
Floyd L. Jensen JCB
County Surveyor

2515

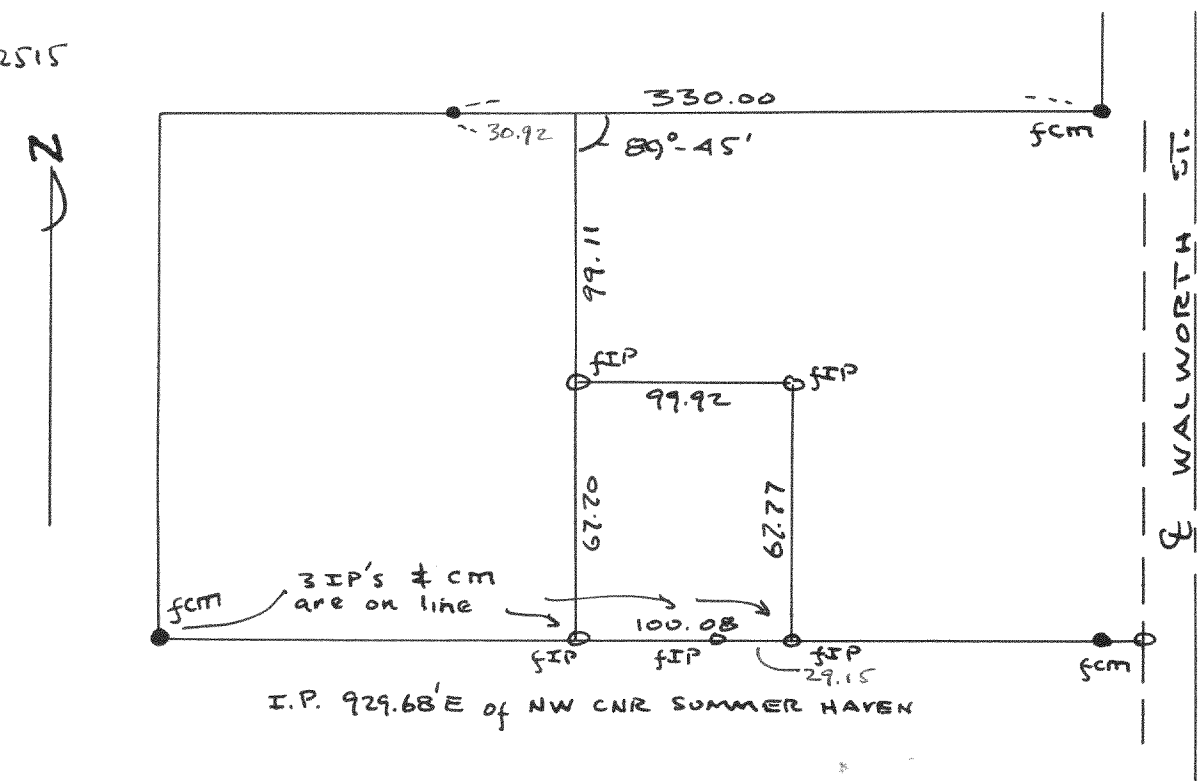

Plat of survey of a parcel of land out of Hitch Estate located in SE 1/4 of Section 1, T1N R16E, Village of Williams Bay, Walworth County, Wis.
Aug 6, 1951
Floyd L. Jensen JCB
County Surveyor

2516

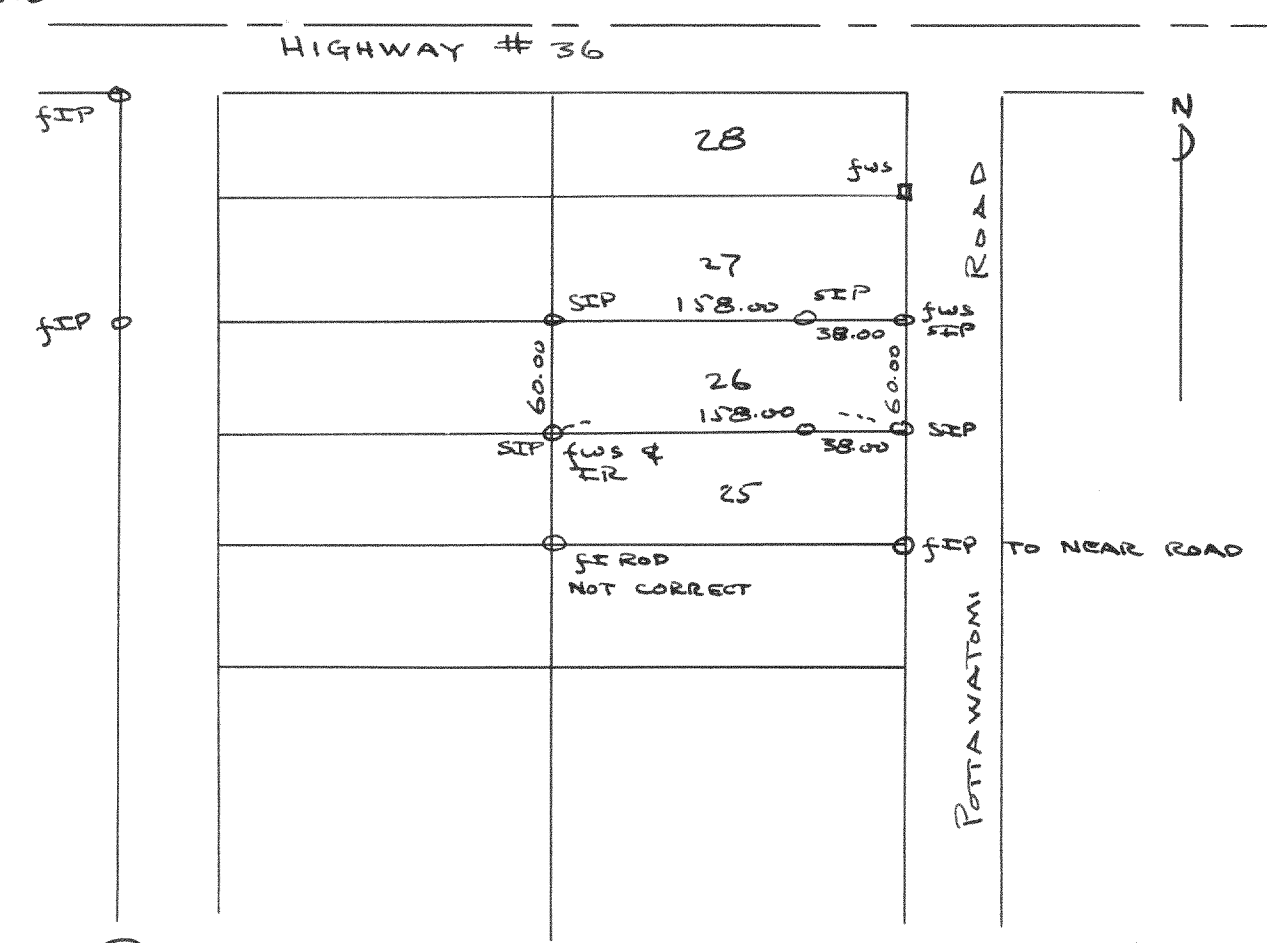

Plat of survey of lot 26, Block 2, Harbor View Subdivision, Village of Williams Bay, Section 6, T1N R17E, Walworth County, Wis.
Aug. 20, 1951
Floyd L. Jensen JCB
County Surveyor