



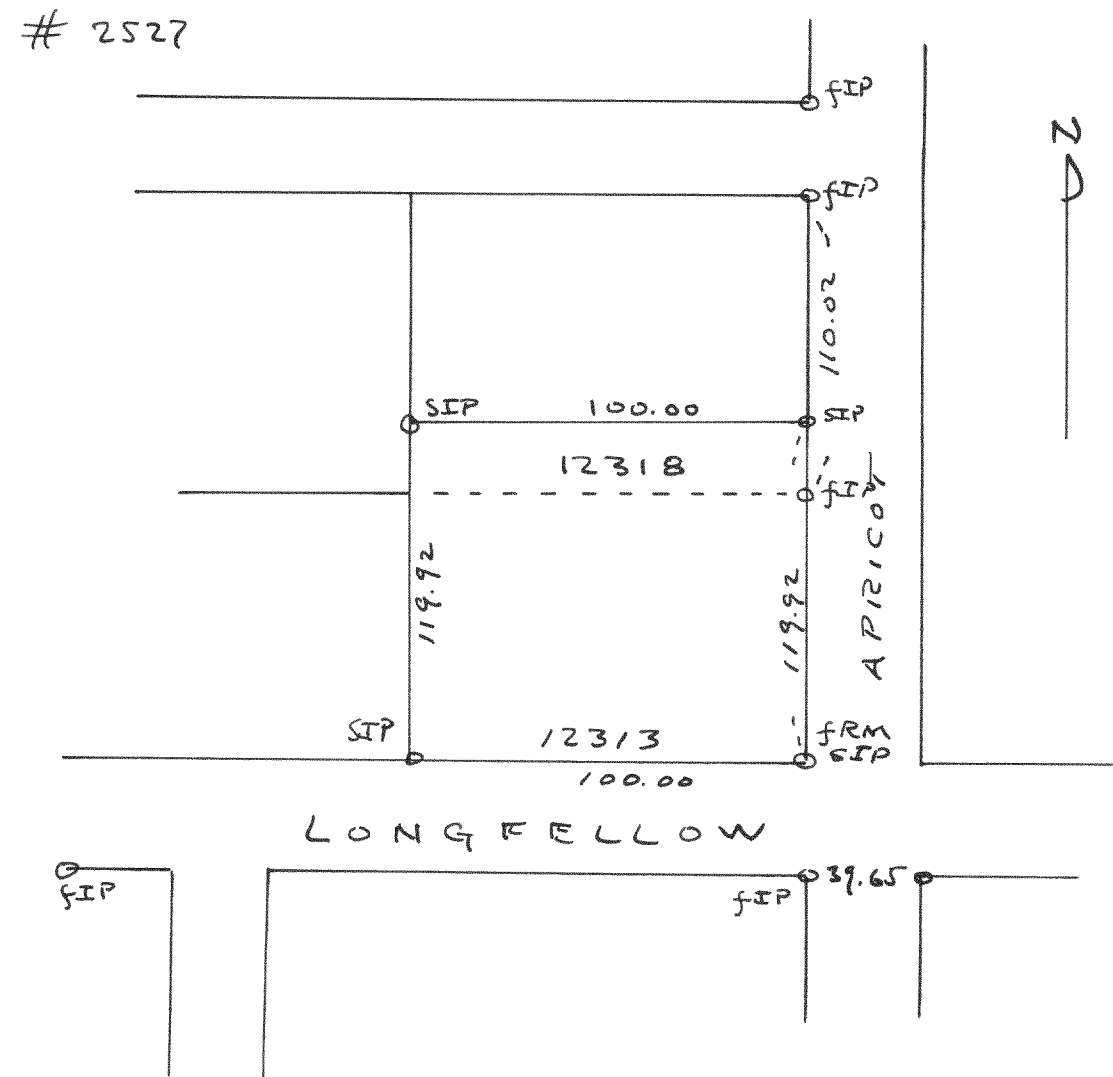

Plat of survey of lots 12313-12318 Lake Como Beach
Subdivision, T 24 N R 17 E, Walworth County, Wisconsin
April 20, 1951
Floyd L. Jensen JCB
County Surveyor

2529 Plat of Oak Shores Subdivision in Section 18, T14 N R 17 E
Walworth County, Wisconsin - See recorded plat on
file in the Register of Deeds Office at the County
Court House
1951
Floyd L. Jensen JCB
County Surveyor

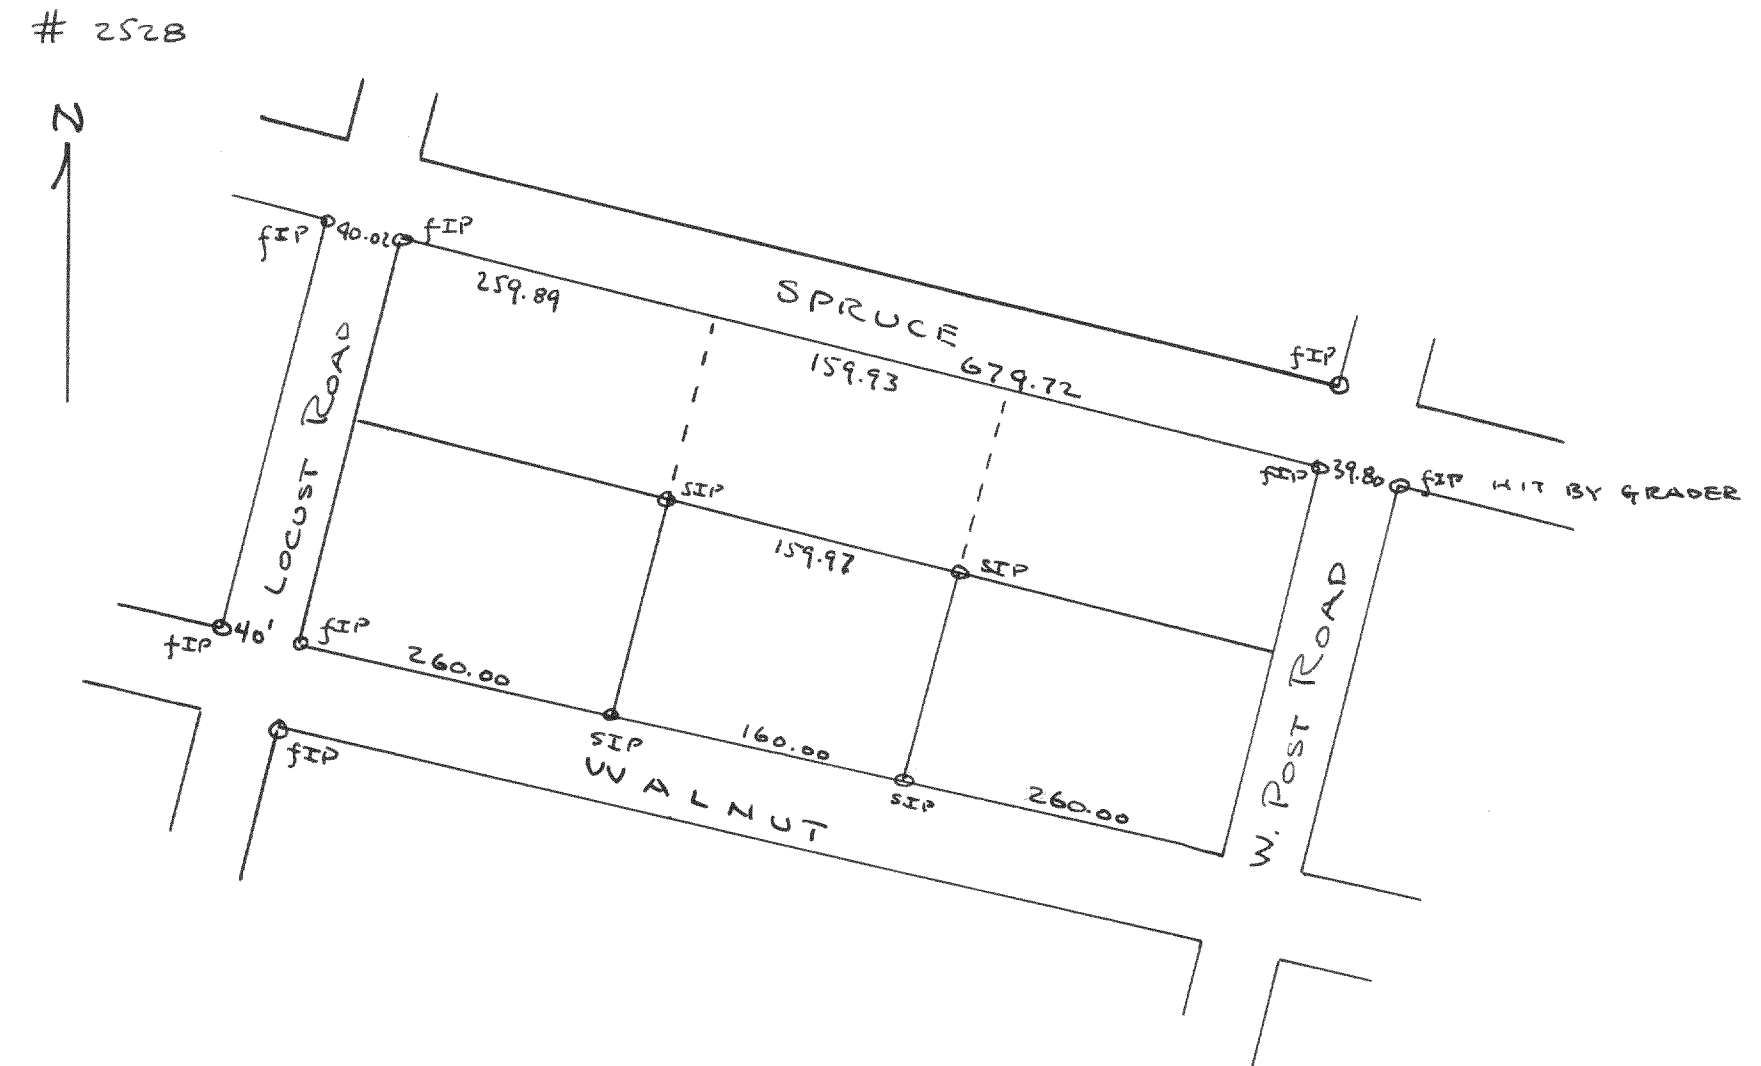

Plat of survey of lots 561-568 Pelee Lake Subdivision
T14 N R 17 E, Walworth County, Wisconsin
Sept 18, 1951
Floyd L. Jensen JCB
County Surveyor

2530 Plat of survey of Wippersink Highlands located in
Section 24, T14 N R 17 E, Walworth County, Wisconsin - See
recorded plat on file in Register of Deeds Office at the
County Court House
1951
Floyd L. Jensen JCB
County Surveyor