
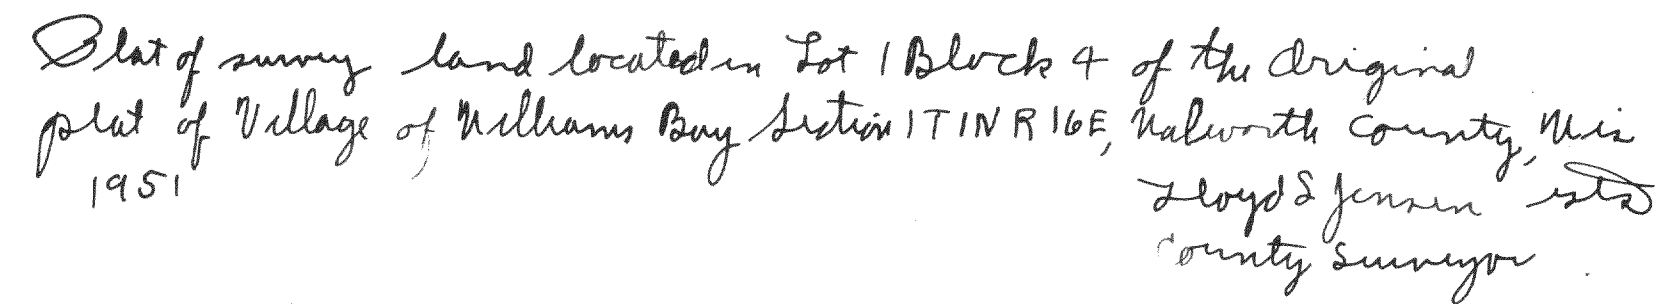


↑

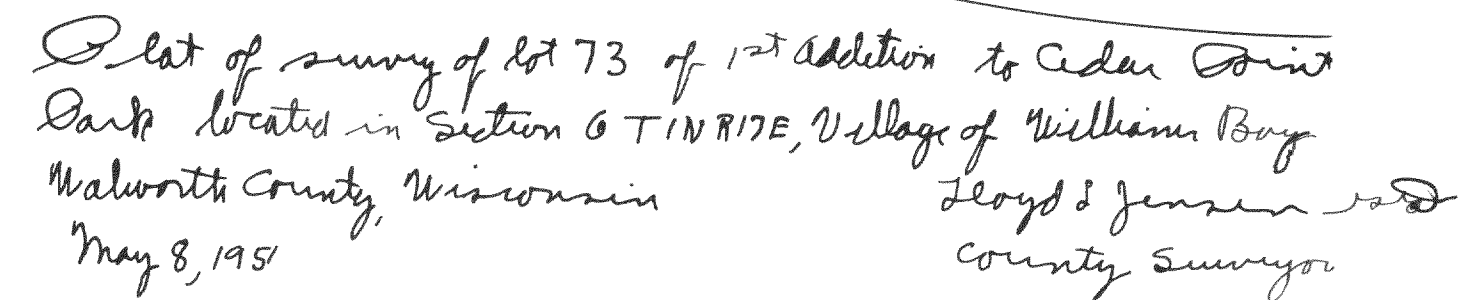

SOUTHWEST CORNER OF
THE N $\frac{1}{2}$ OF THE NW $\frac{1}{4}$
OF THE NW $\frac{1}{4}$ OF THE
SW $\frac{1}{4}$ OF SECTION 31

2543

[illegible]

PLAT OF A SURVEY OF LAND LOCATED
IN THE NORTHWEST $\frac{1}{4}$ OF SECTION 10, T2N, R1E
OF WALWORTH COUNTY, WISCONSIN.
JULY 1952
Lloyd L. Jensen sr
COUNTY SURVEYOR