


2565

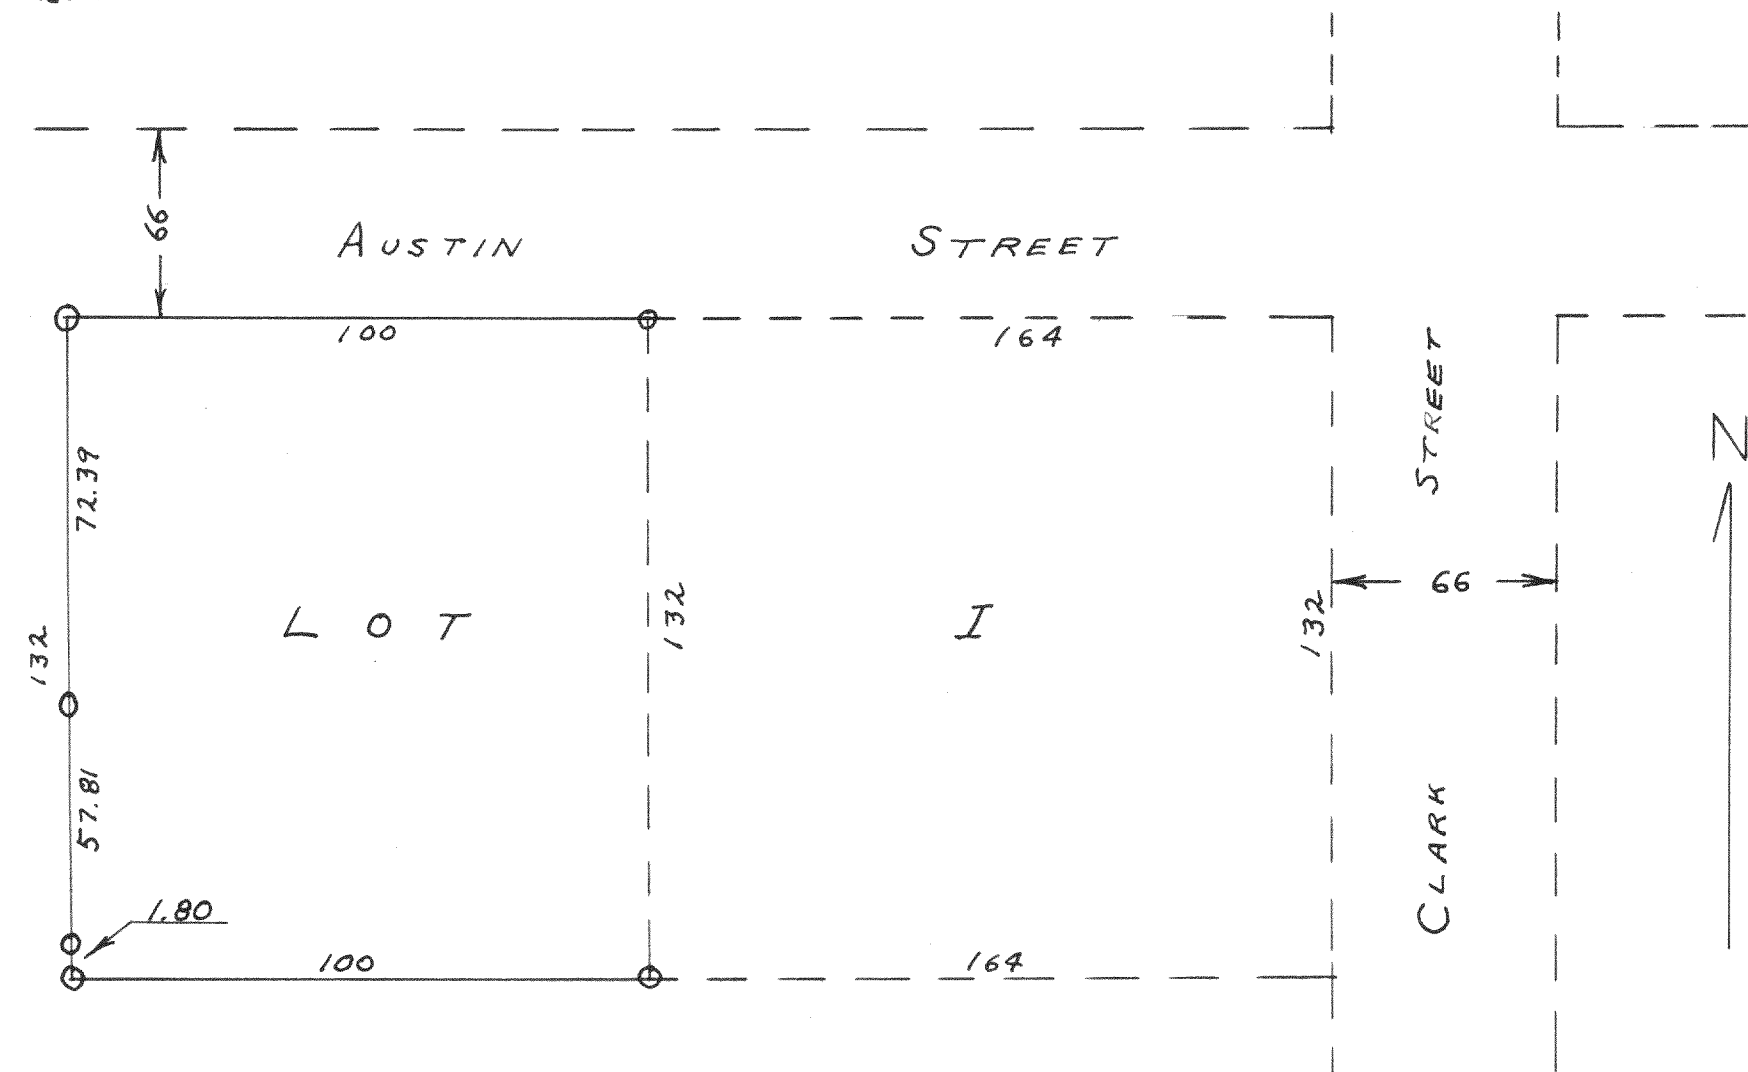


PLAT OF SURVEY OF THE WEST
100 FEET OF LOT I OF BLOCK
18 OF THE ORIGINAL PLAT OF THE
VILLAGE OF EAST TROY, WISCONSIN.

MAY 1952

Lloyd L. Jensen SA
COUNTY SURVEYOR

2566

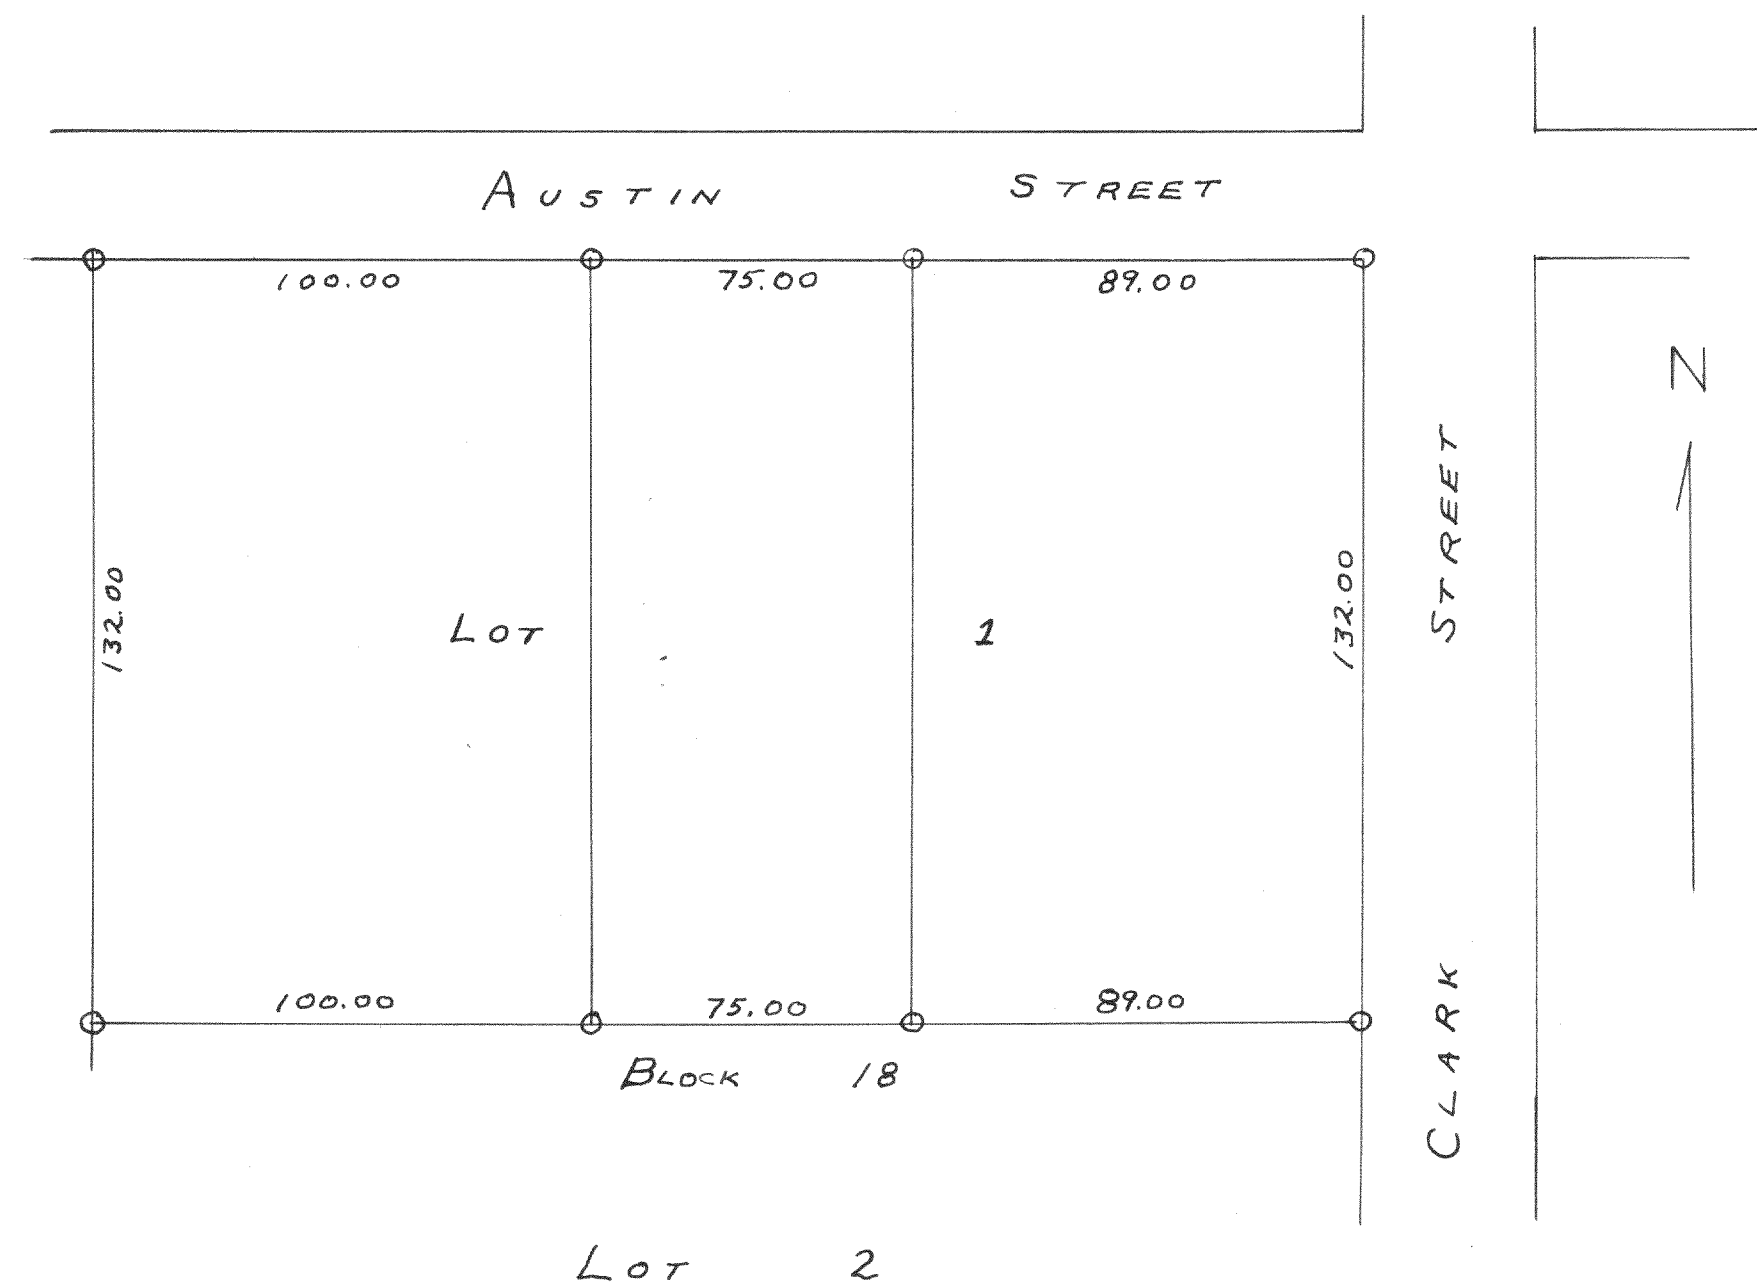

PLAT OF SURVEY OF LOT 1, BLOCK 18,
ORIGINAL PLAT OF THE VILLAGE OF EAST
TROY, WALWORTH COUNTY, WISCONSIN.
MAY 1952

Lloyd L. Jensen SA
COUNTY SURVEYOR