



#1299

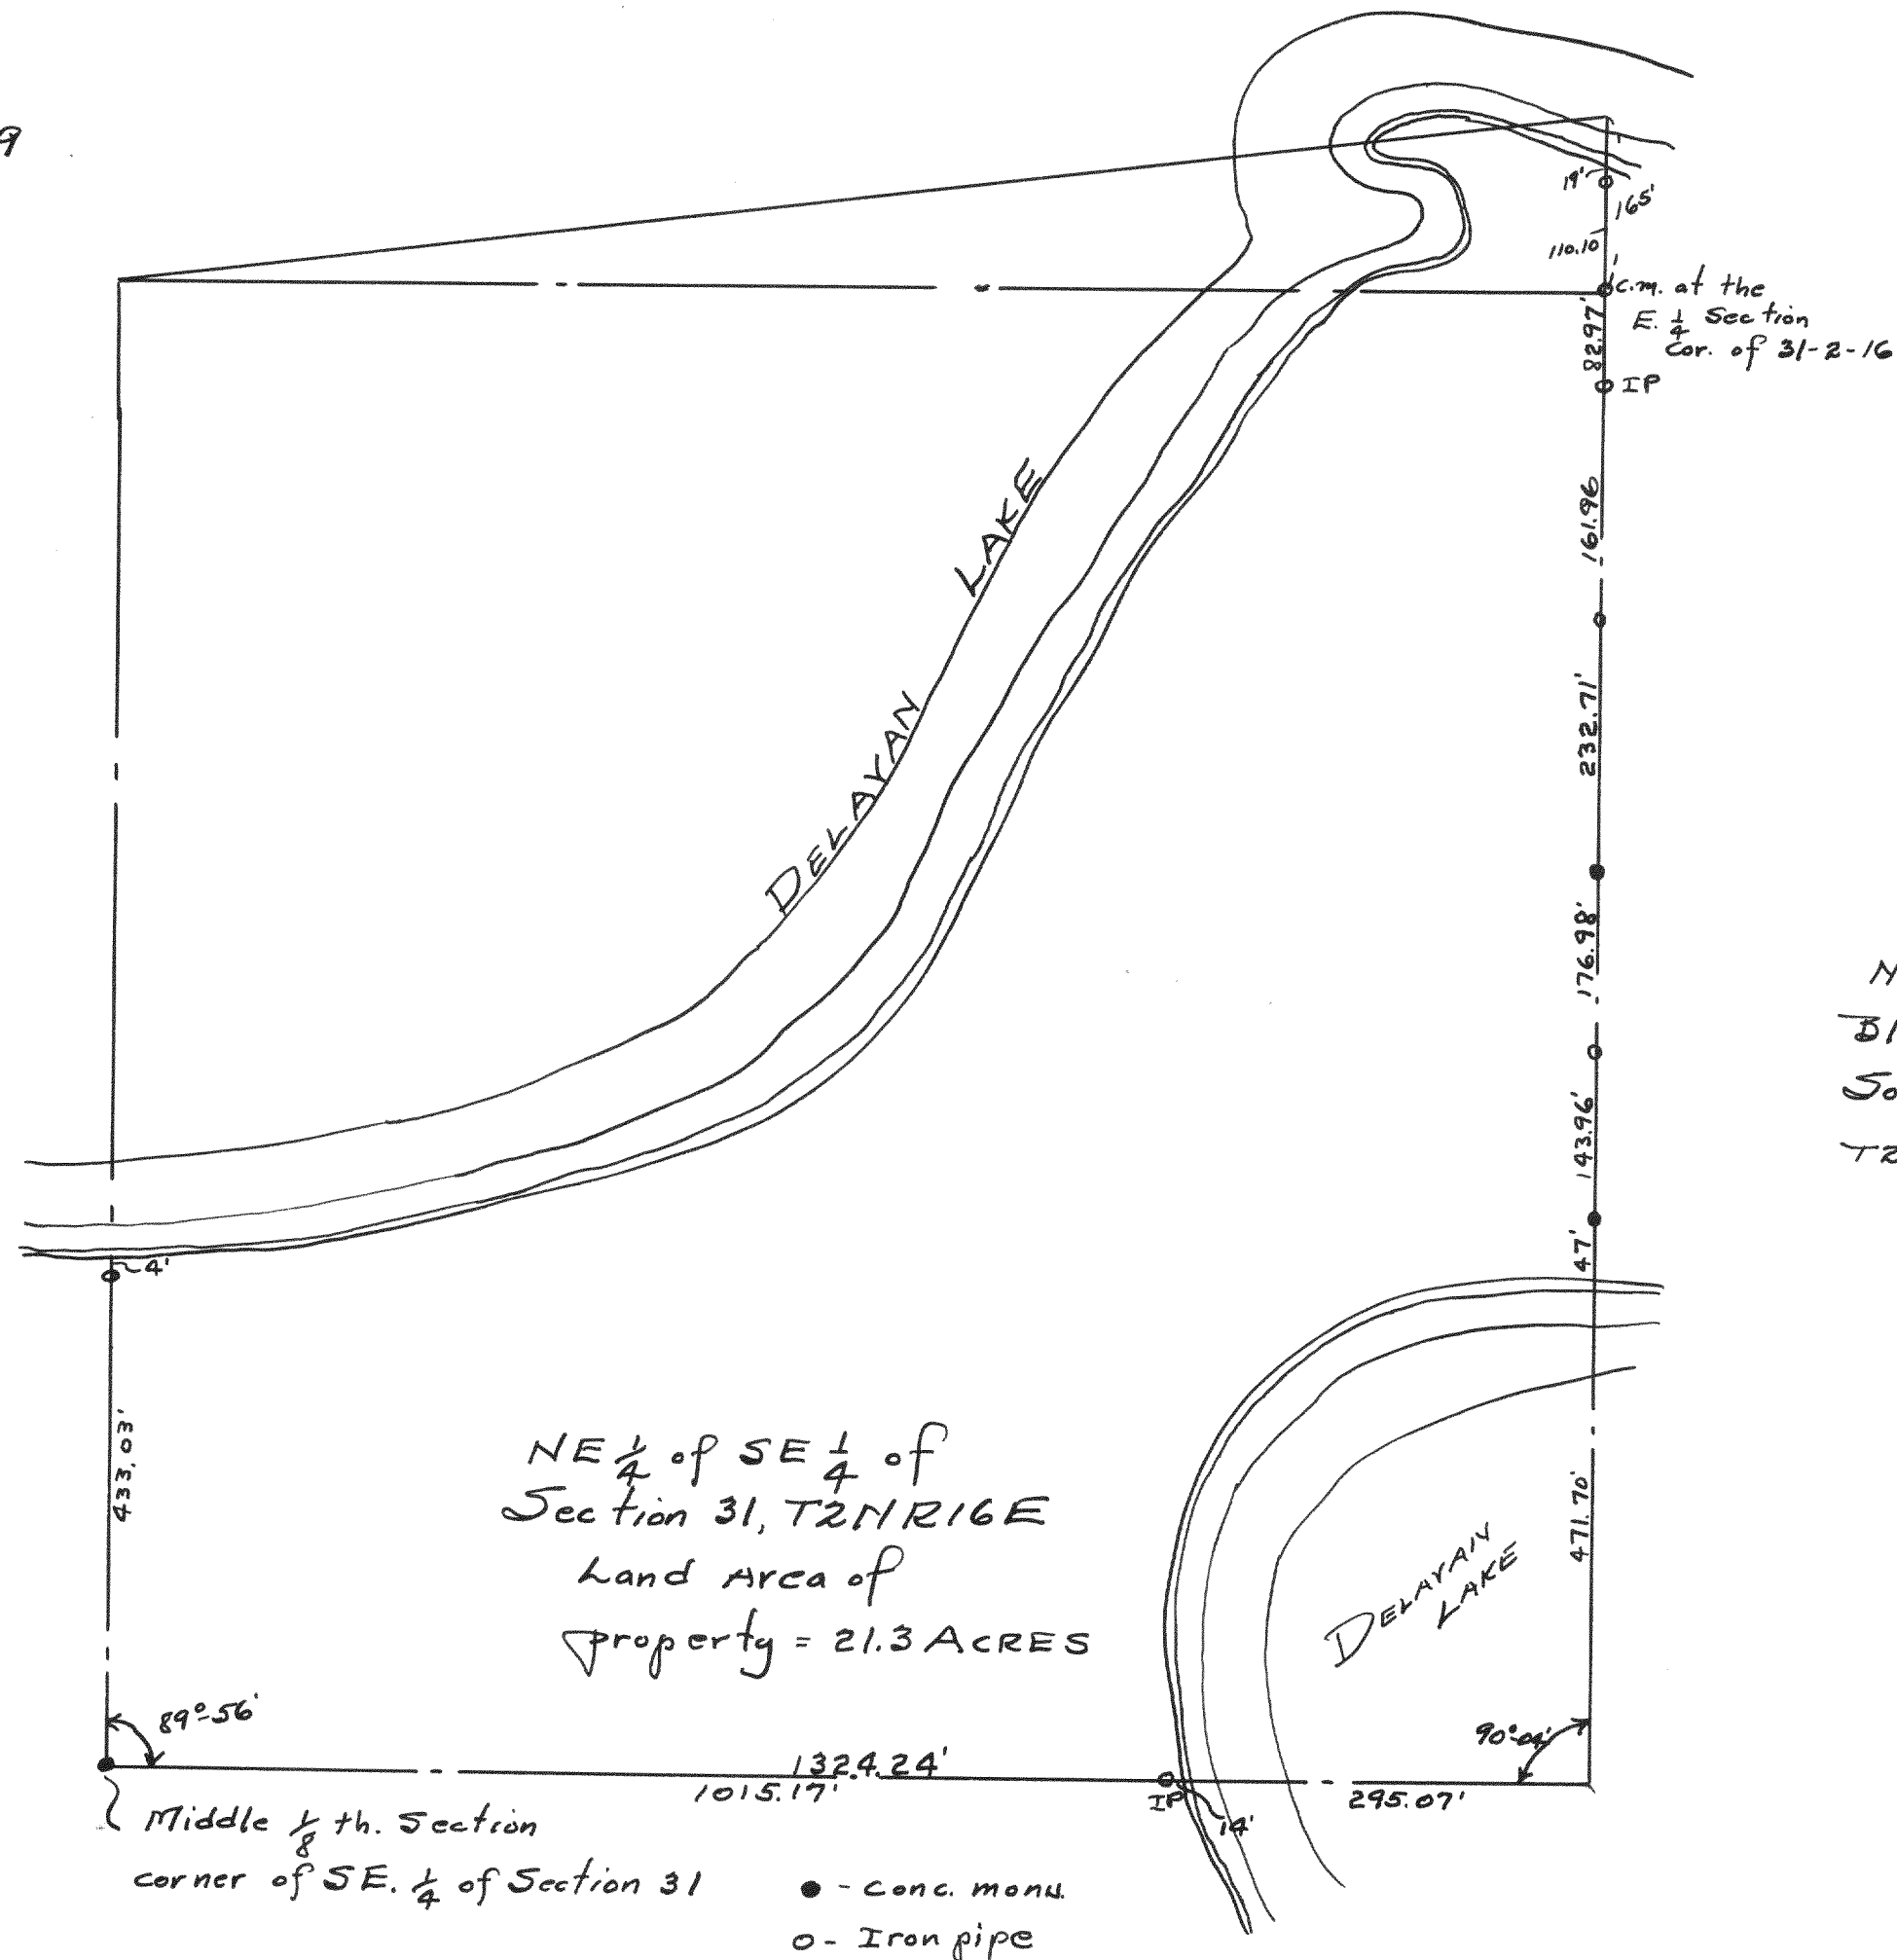

Survey of Central Baptist Childrens Home property
at Delavan Lake.
July 1942

Lloyd L. Jensen
County Surveyor

#1300

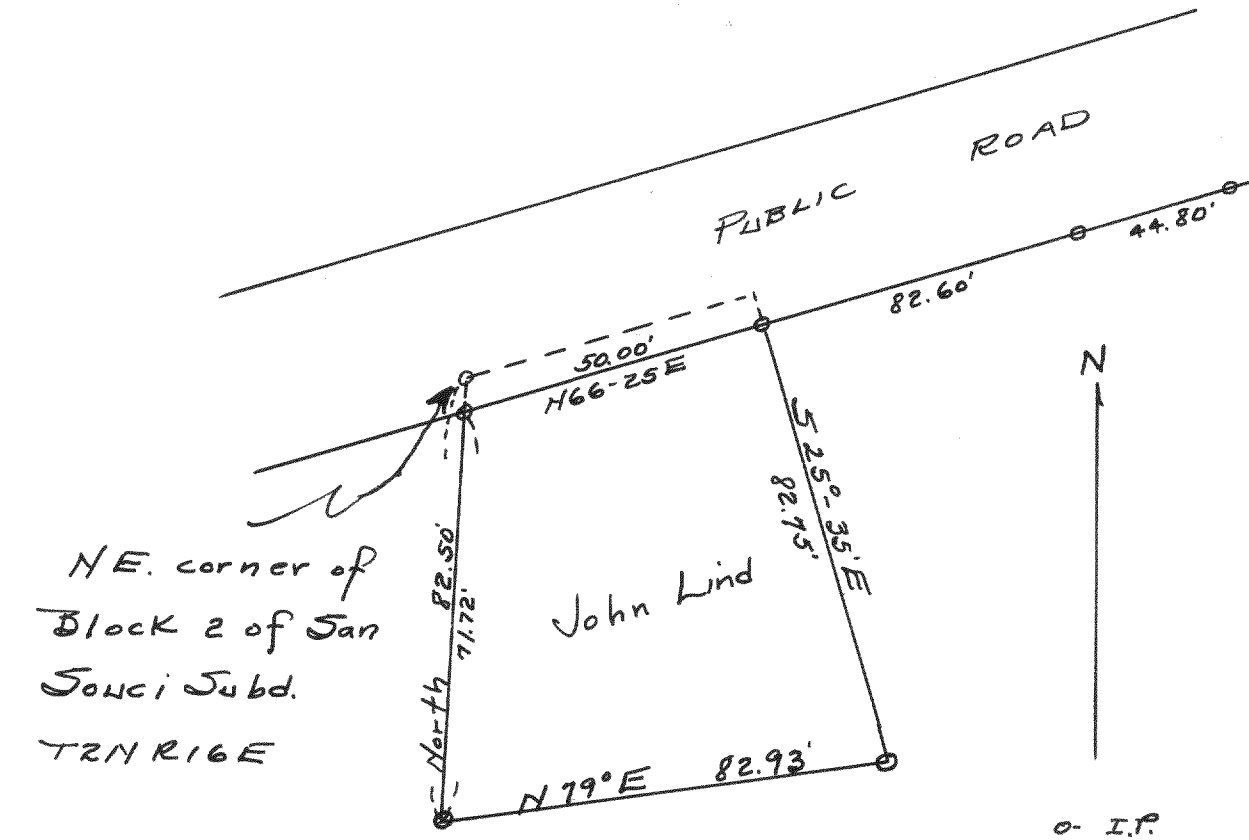

Plot of survey of land owned by
John Lind in Section 22, T2N R16E,
land is located across from
Hall's Park at Delavan Lake.
Aug. 1942

Lloyd L. Jensen