


#1301

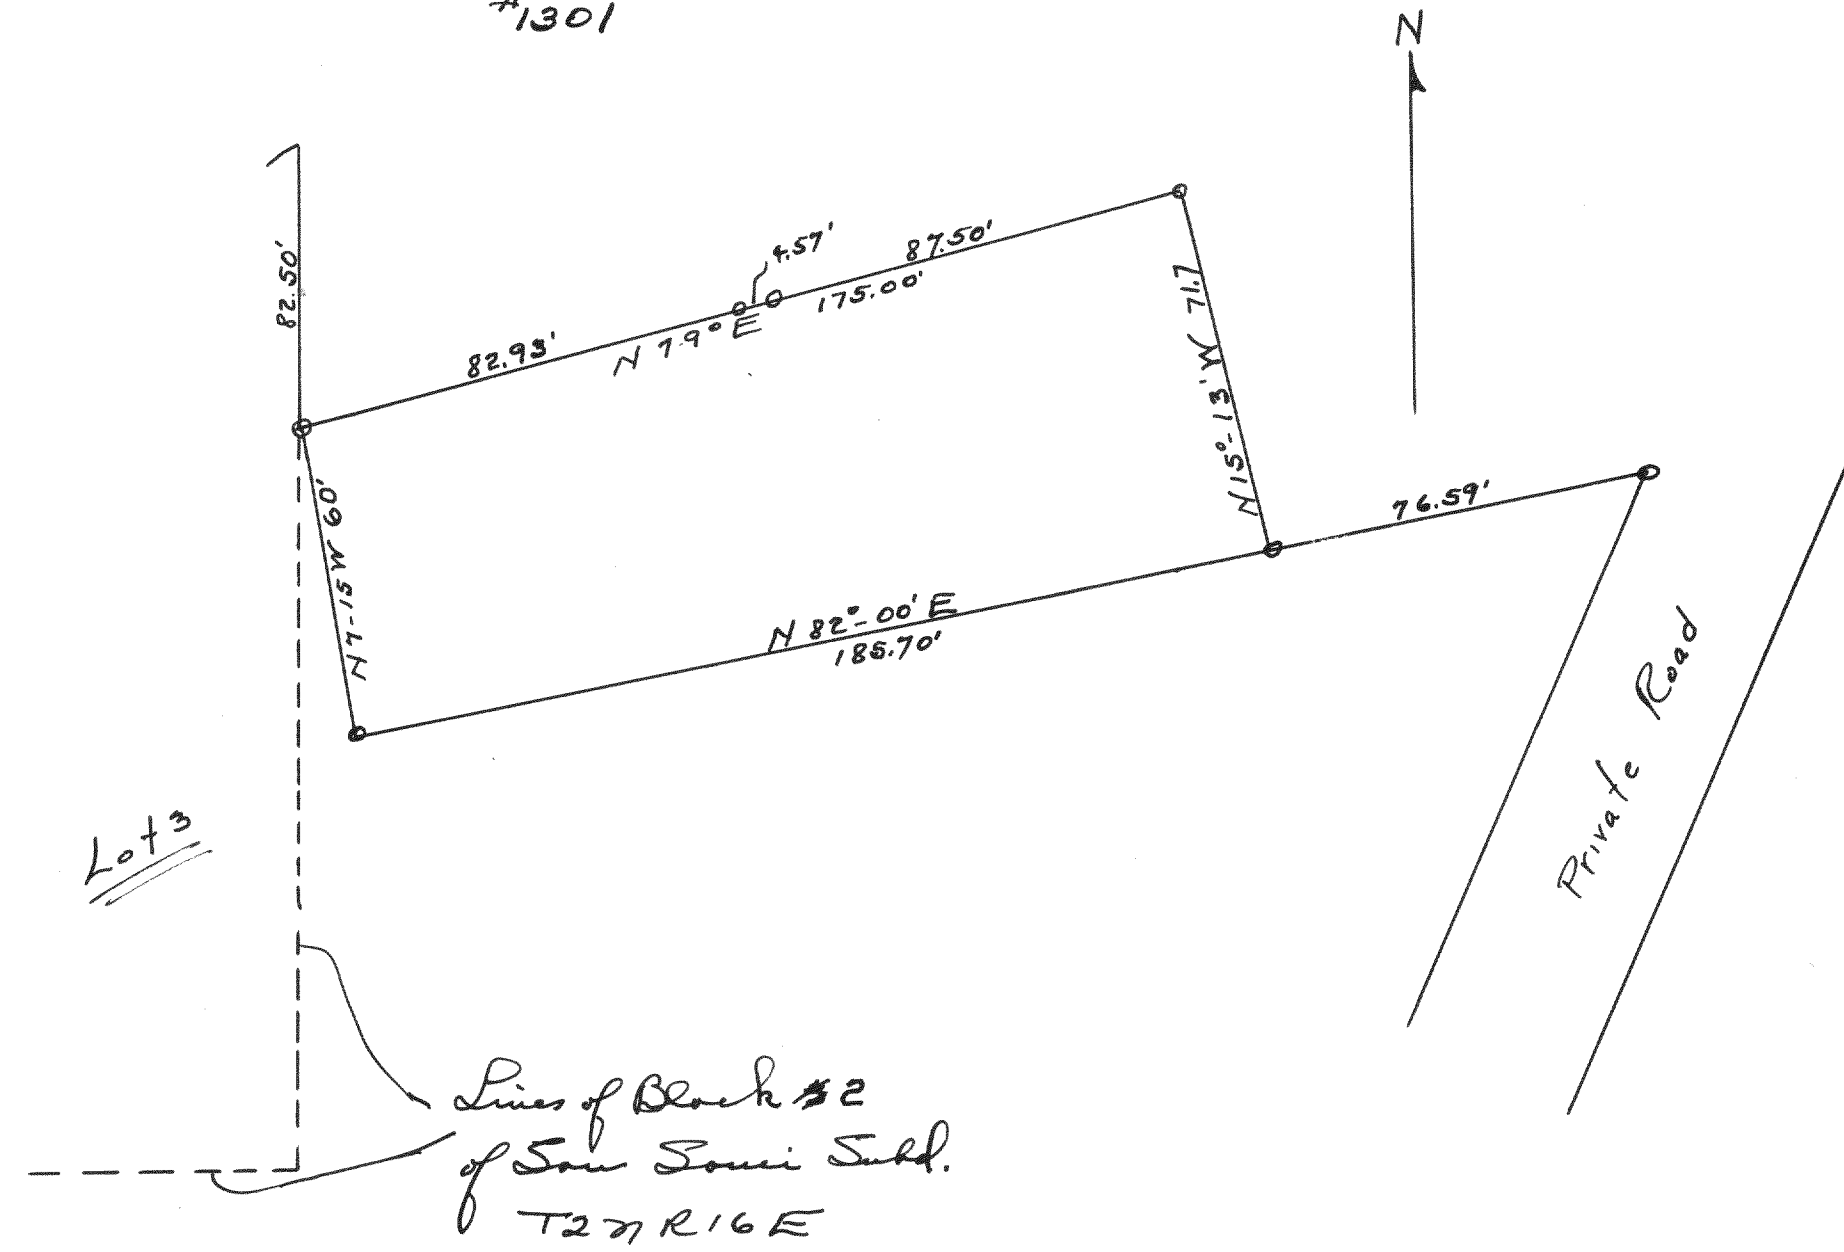


Plot of survey of land purchased
by Mrs. Lillian Andersen in 1942.

Aug. 1942

Lloyd L. Fusan
County Surveyor

#1302

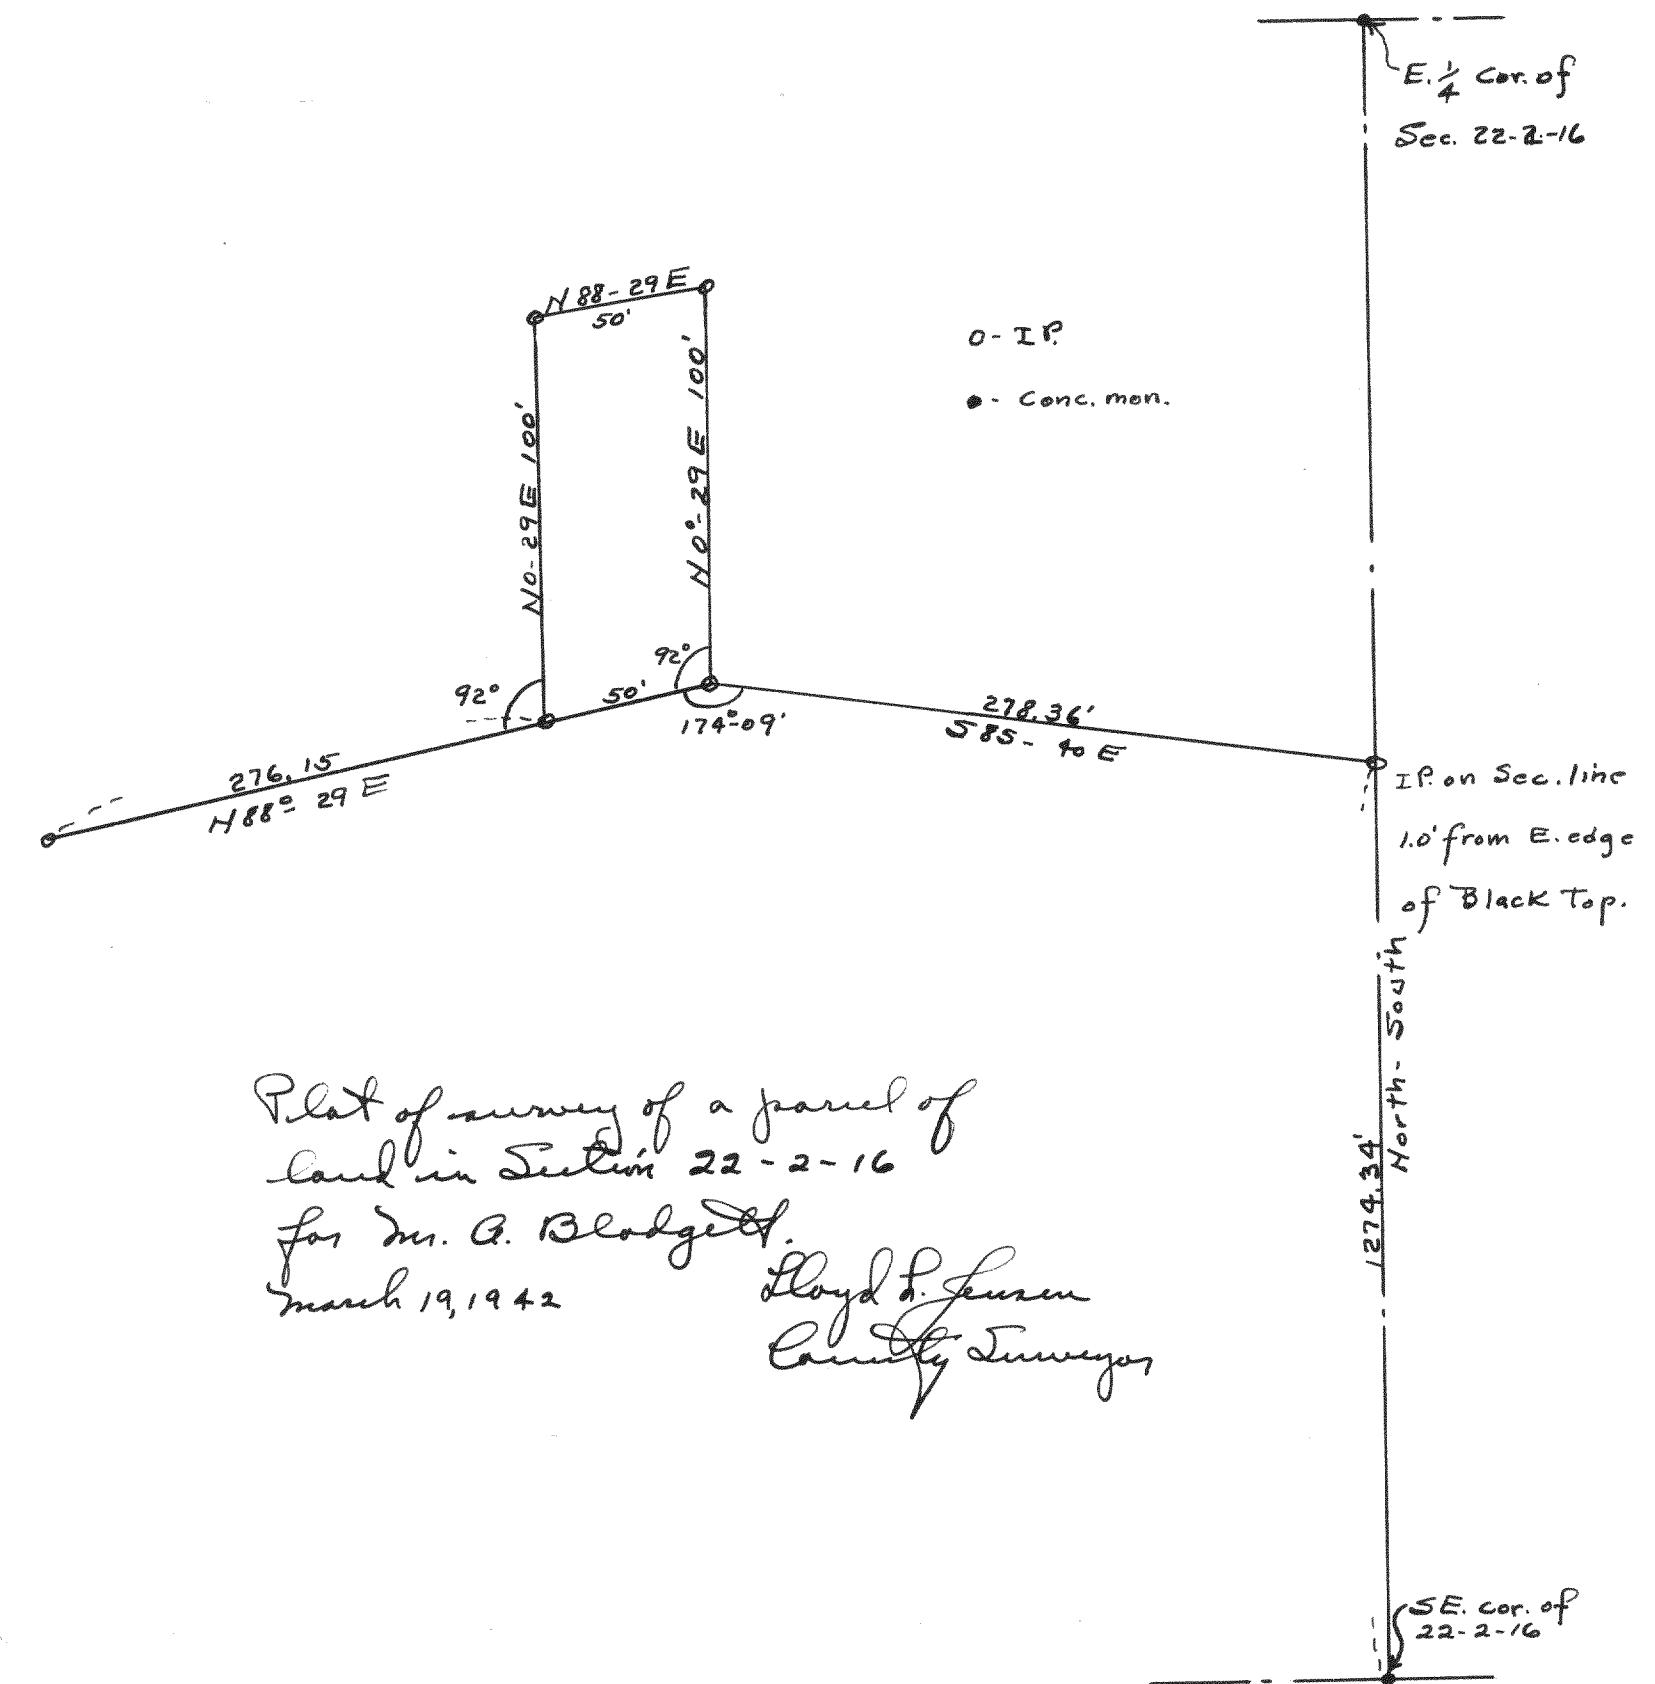

Plot of survey of a parcel of
land in Section 22-2-16
for Mr. C. Blodgett.

March 19, 1942

Lloyd S. Jensen
County Surveyor

E. $\frac{1}{4}$ Cor. of
Sec. 22-2-16

I.P. on Sec. line
1.0' from E. edge
of Black Top.

(SE. cor. of
22-2-16