


#1303

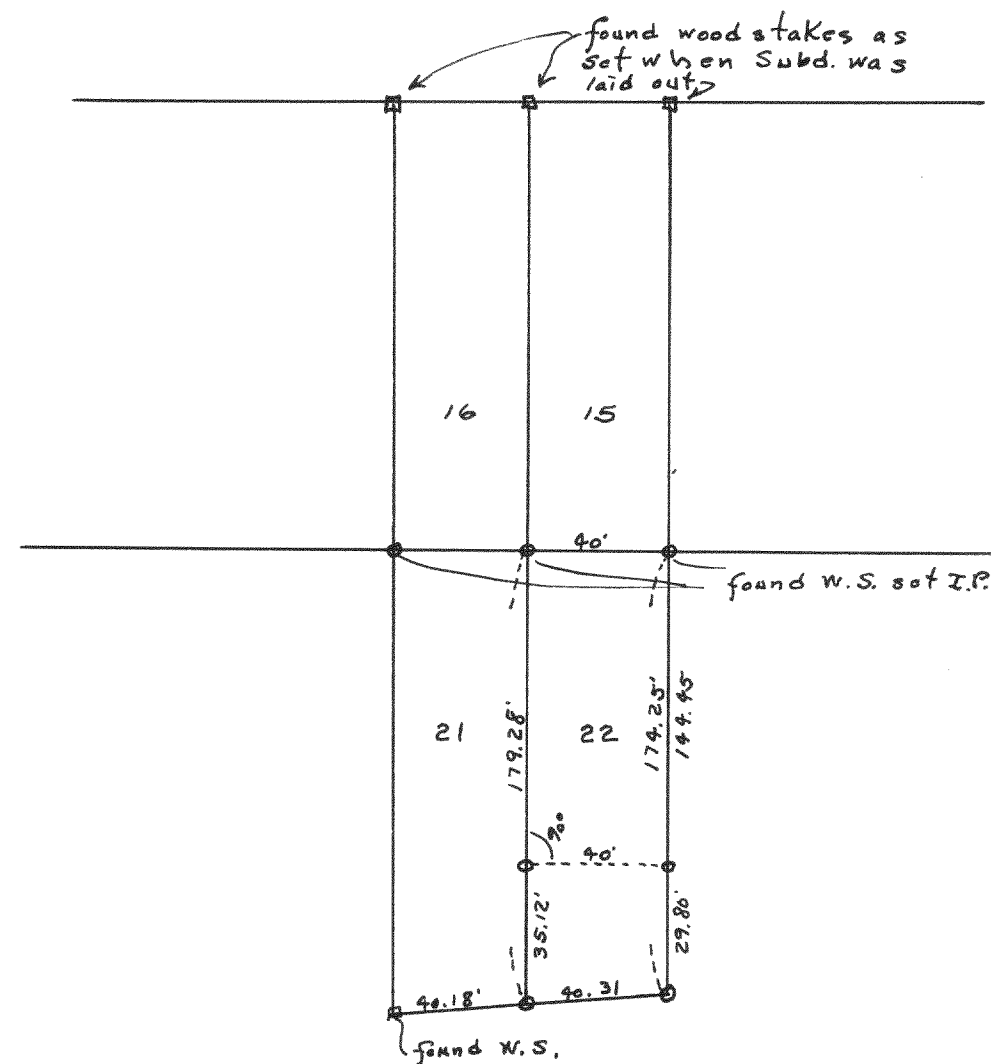


Plot of survey of Lot 22 - Blk. 19
of McLean Lakeview East
Subdivision for Mrs. Louis Mack
5016 N. Calif. Ave., Chicago, Ill.

June 27, 1942

Lloyd L. Jensen
County Surveyor.

#1304

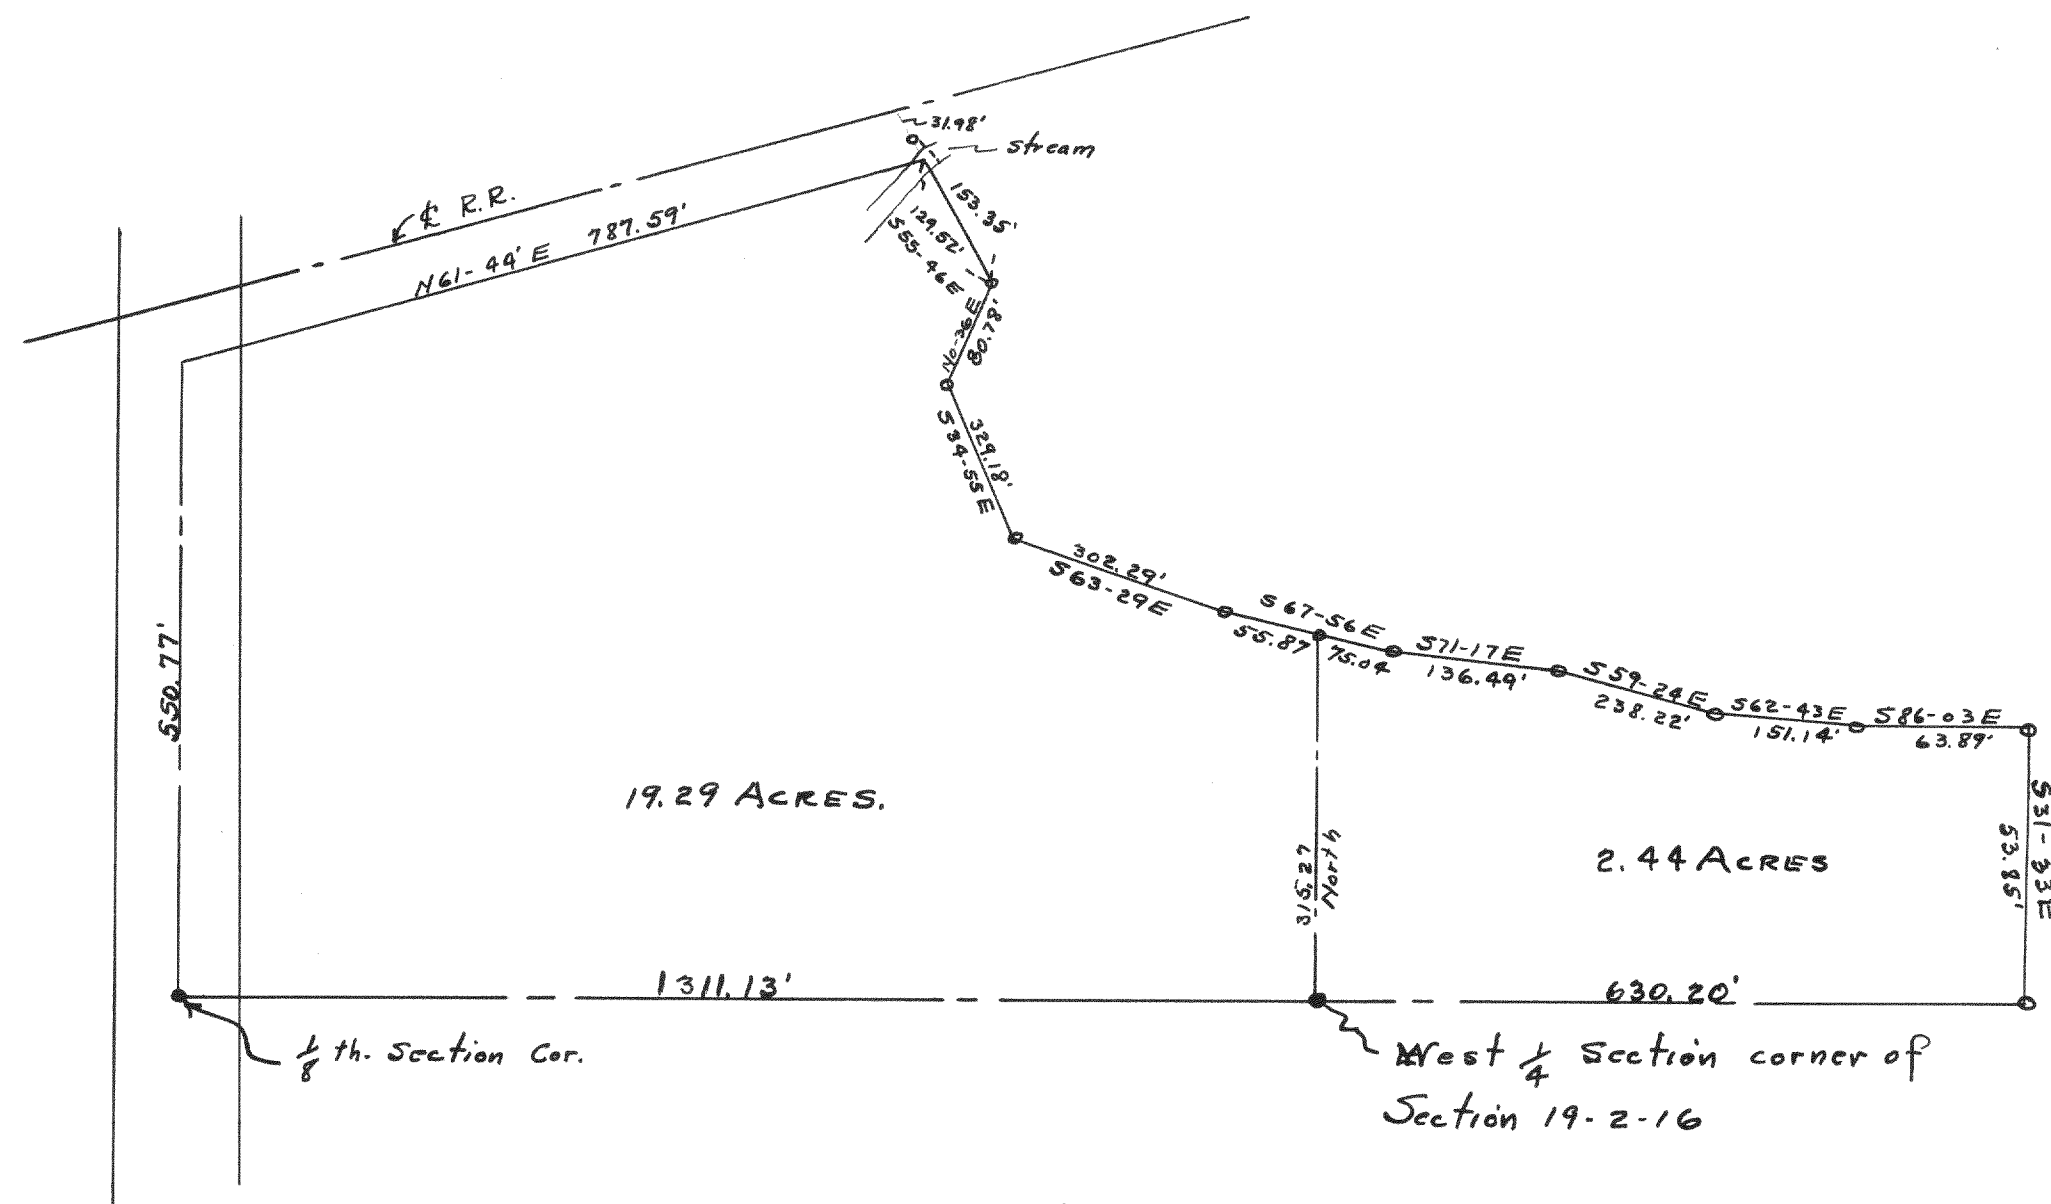

Plot of survey of land located in Section 19,
T27N R16E and Section 24, T27N R15E of Walworth
County Wisconsin

Aug. 1942

Lloyd L. Jensen
County Surveyor