


#1314

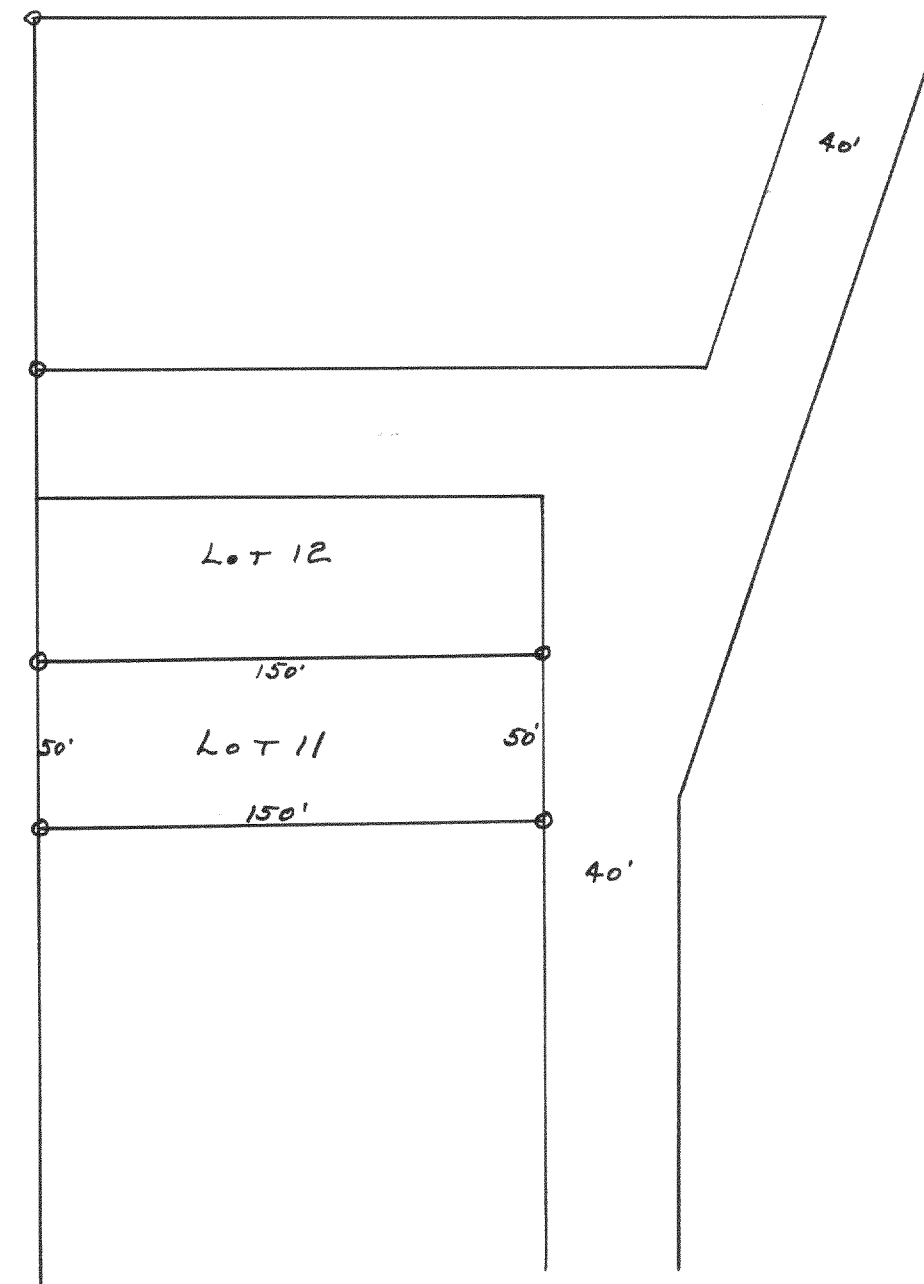


Plot of survey of Lot 11 of Block 8
of Sunset Hills Subdivision.

May 1942

Lloyd L. Jensen
County Surveyor

#1315

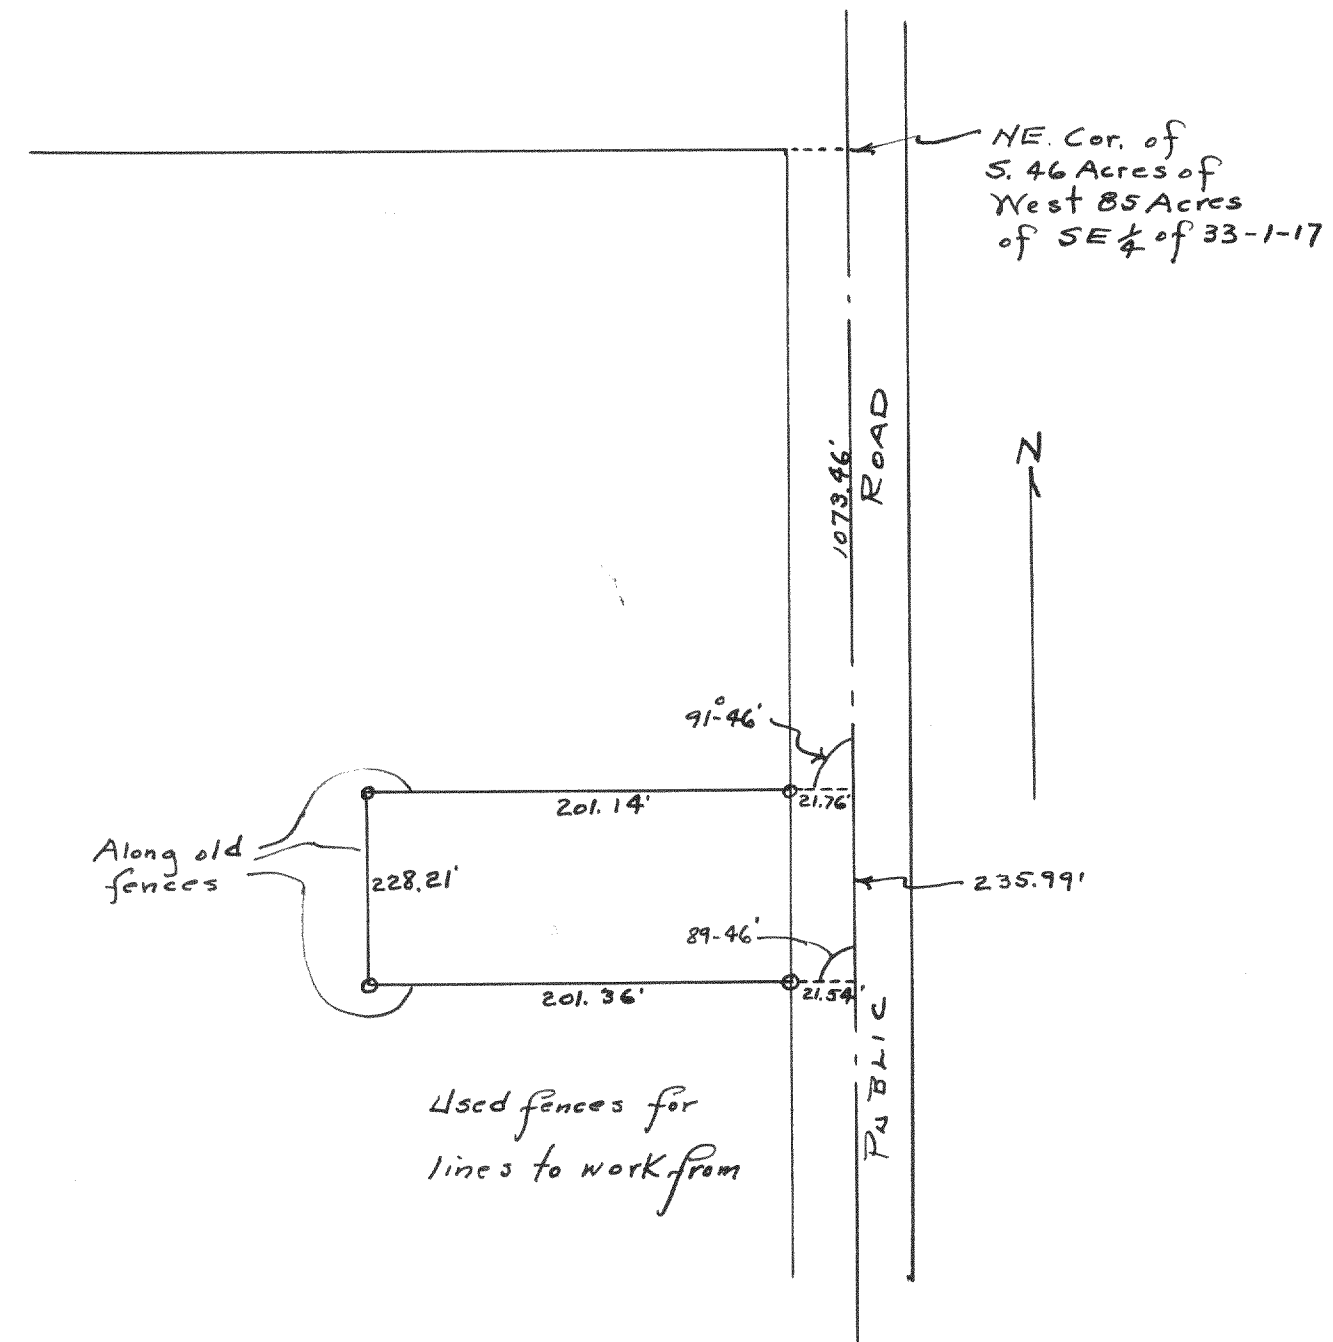

Plot of survey of land in Section 33,
T19N R17E to locate lines of house
lot for R.J. Publ.

Aug. 24, 1942

Lloyd L. Jensen
County Surveyor