


#1321

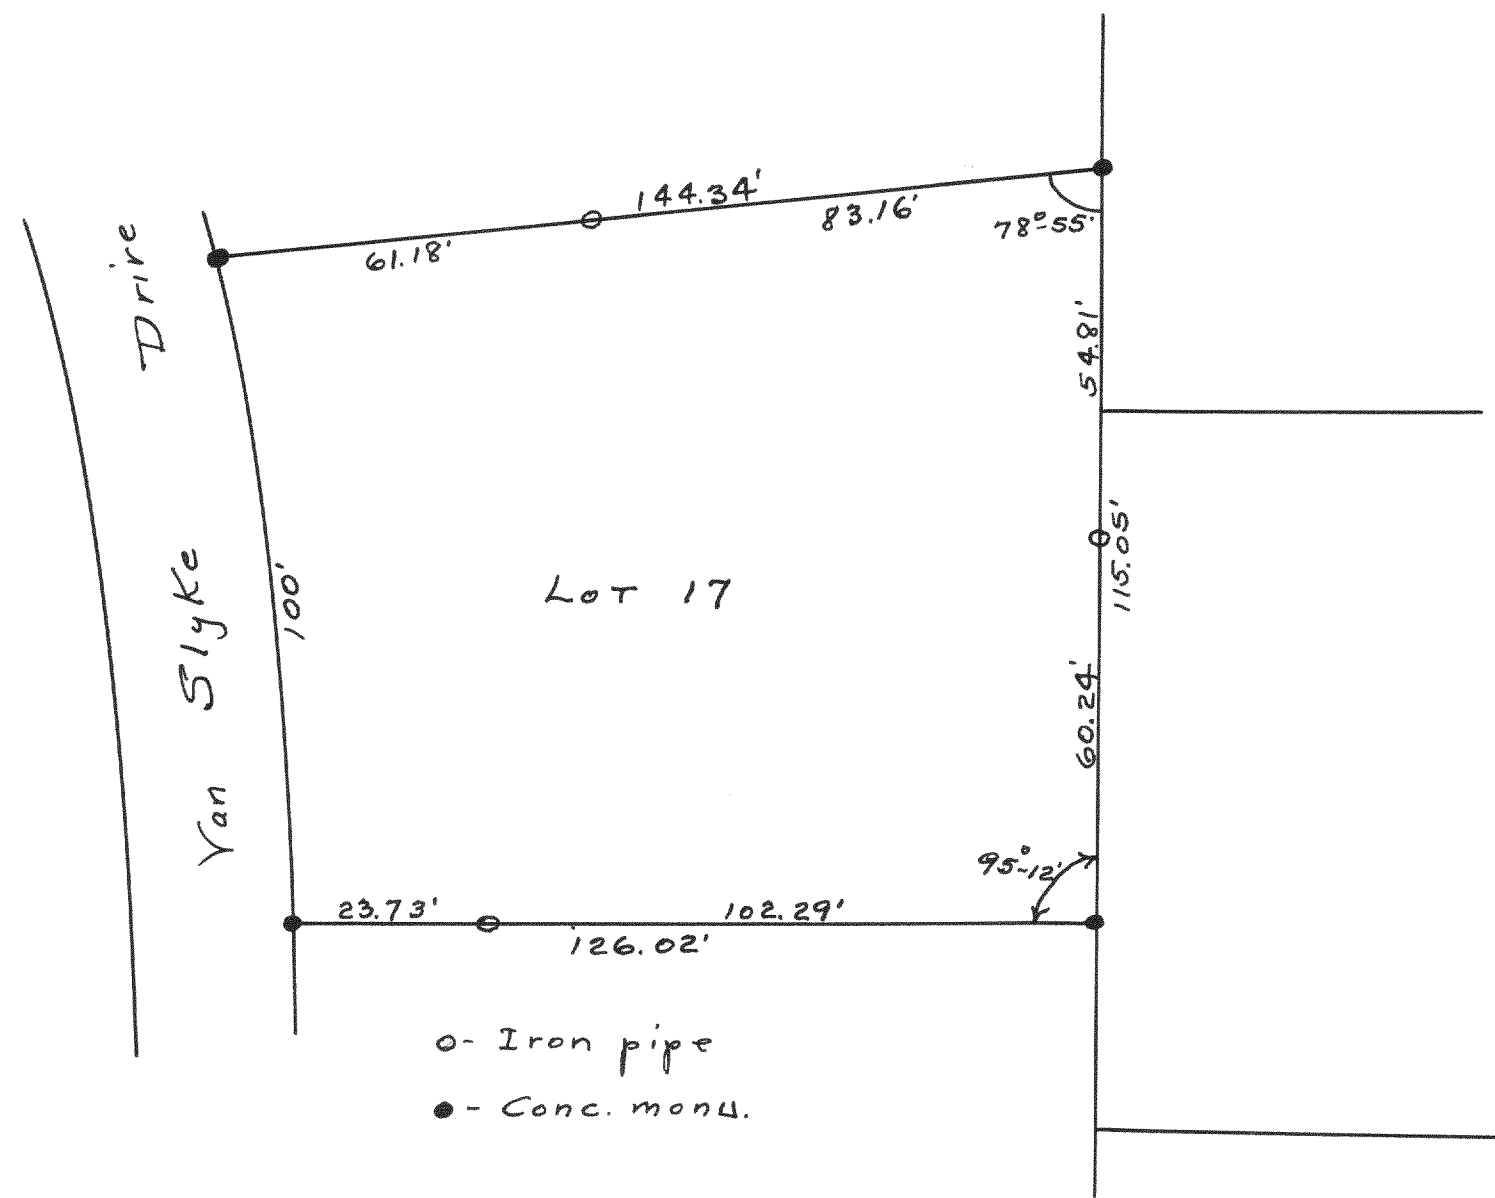


Plot of survey of Lot 17 of Block E
of Unit 3 of the Country Club Est.
Fontana.

June 1942

Lloyd L. Jensen
County Surveyor

#1322

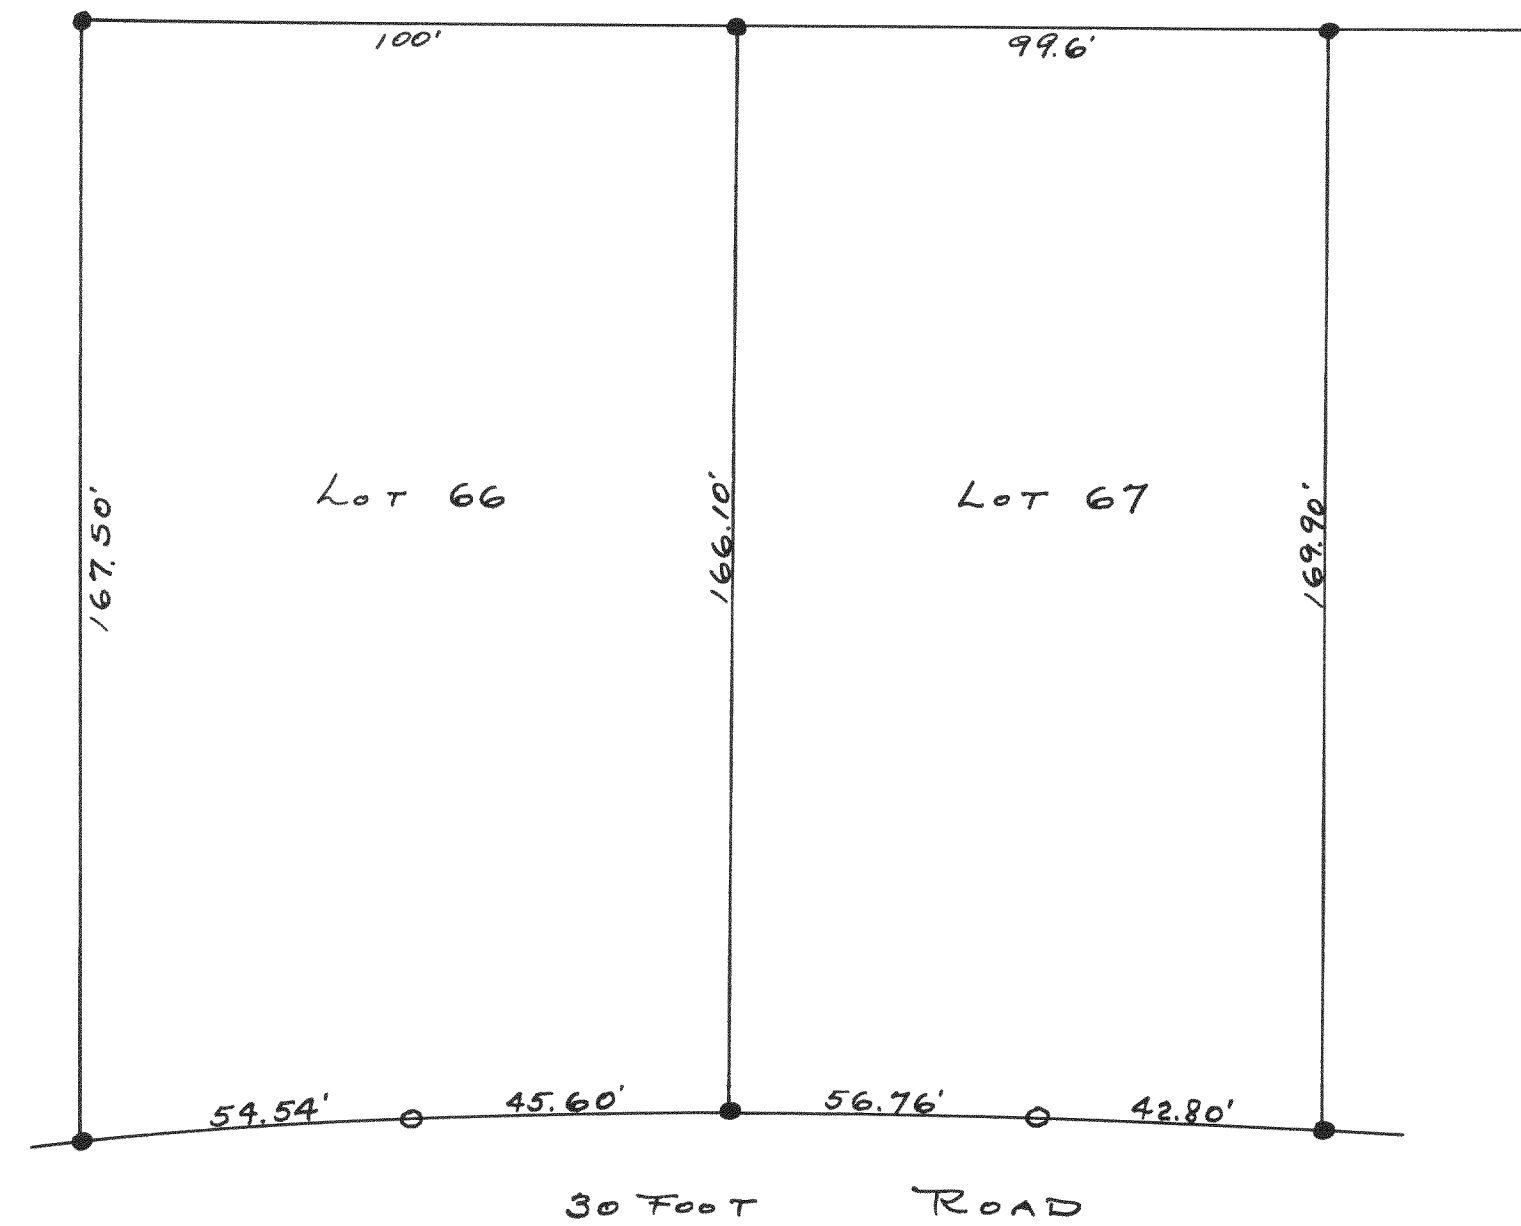

Plot of survey of Lots 66 and 67 of Unit No. 2
of Country Club Estates, Fontana.

June 1942

Lloyd L. Jensen
County Surveyor