


#1323

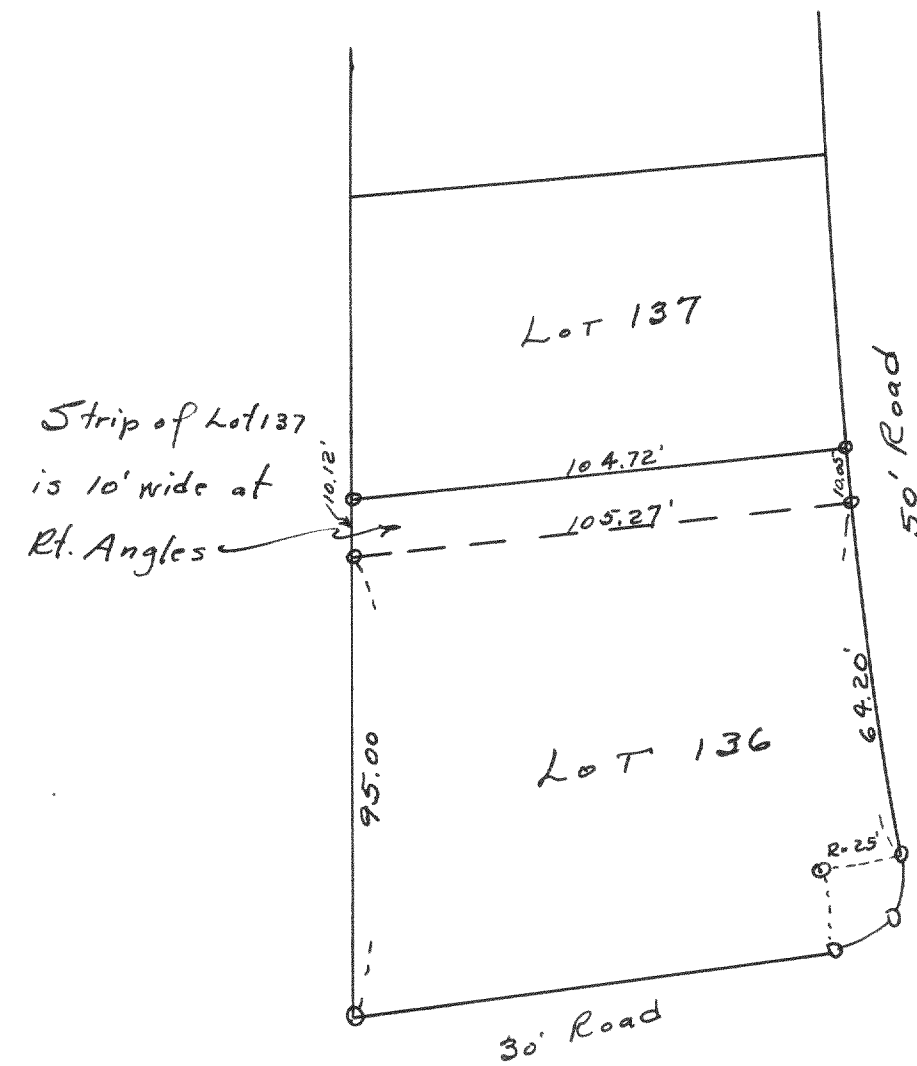


Plot of survey of Lot 136 and
the South 10 feet of Lot 137
of Unit No. 2 of the Country
Club Estates, Fontana.

April 1942

Lloyd L. Jensen
County Surveyor

#1324

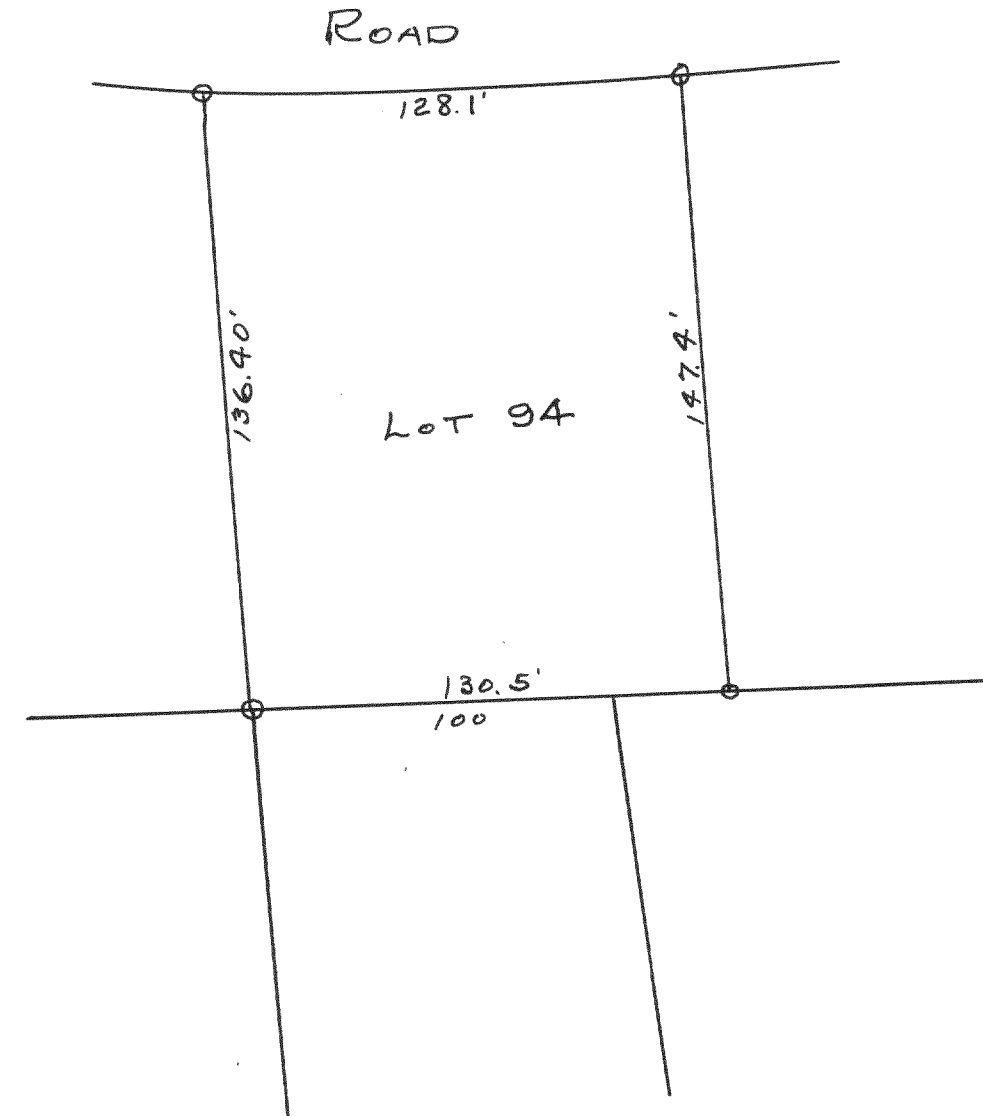

Plot of survey of Lot 94 of Unit 2
of Country Club Estates, Fontana.

1941

Lloyd L. Jensen
County Surveyor