


#1327

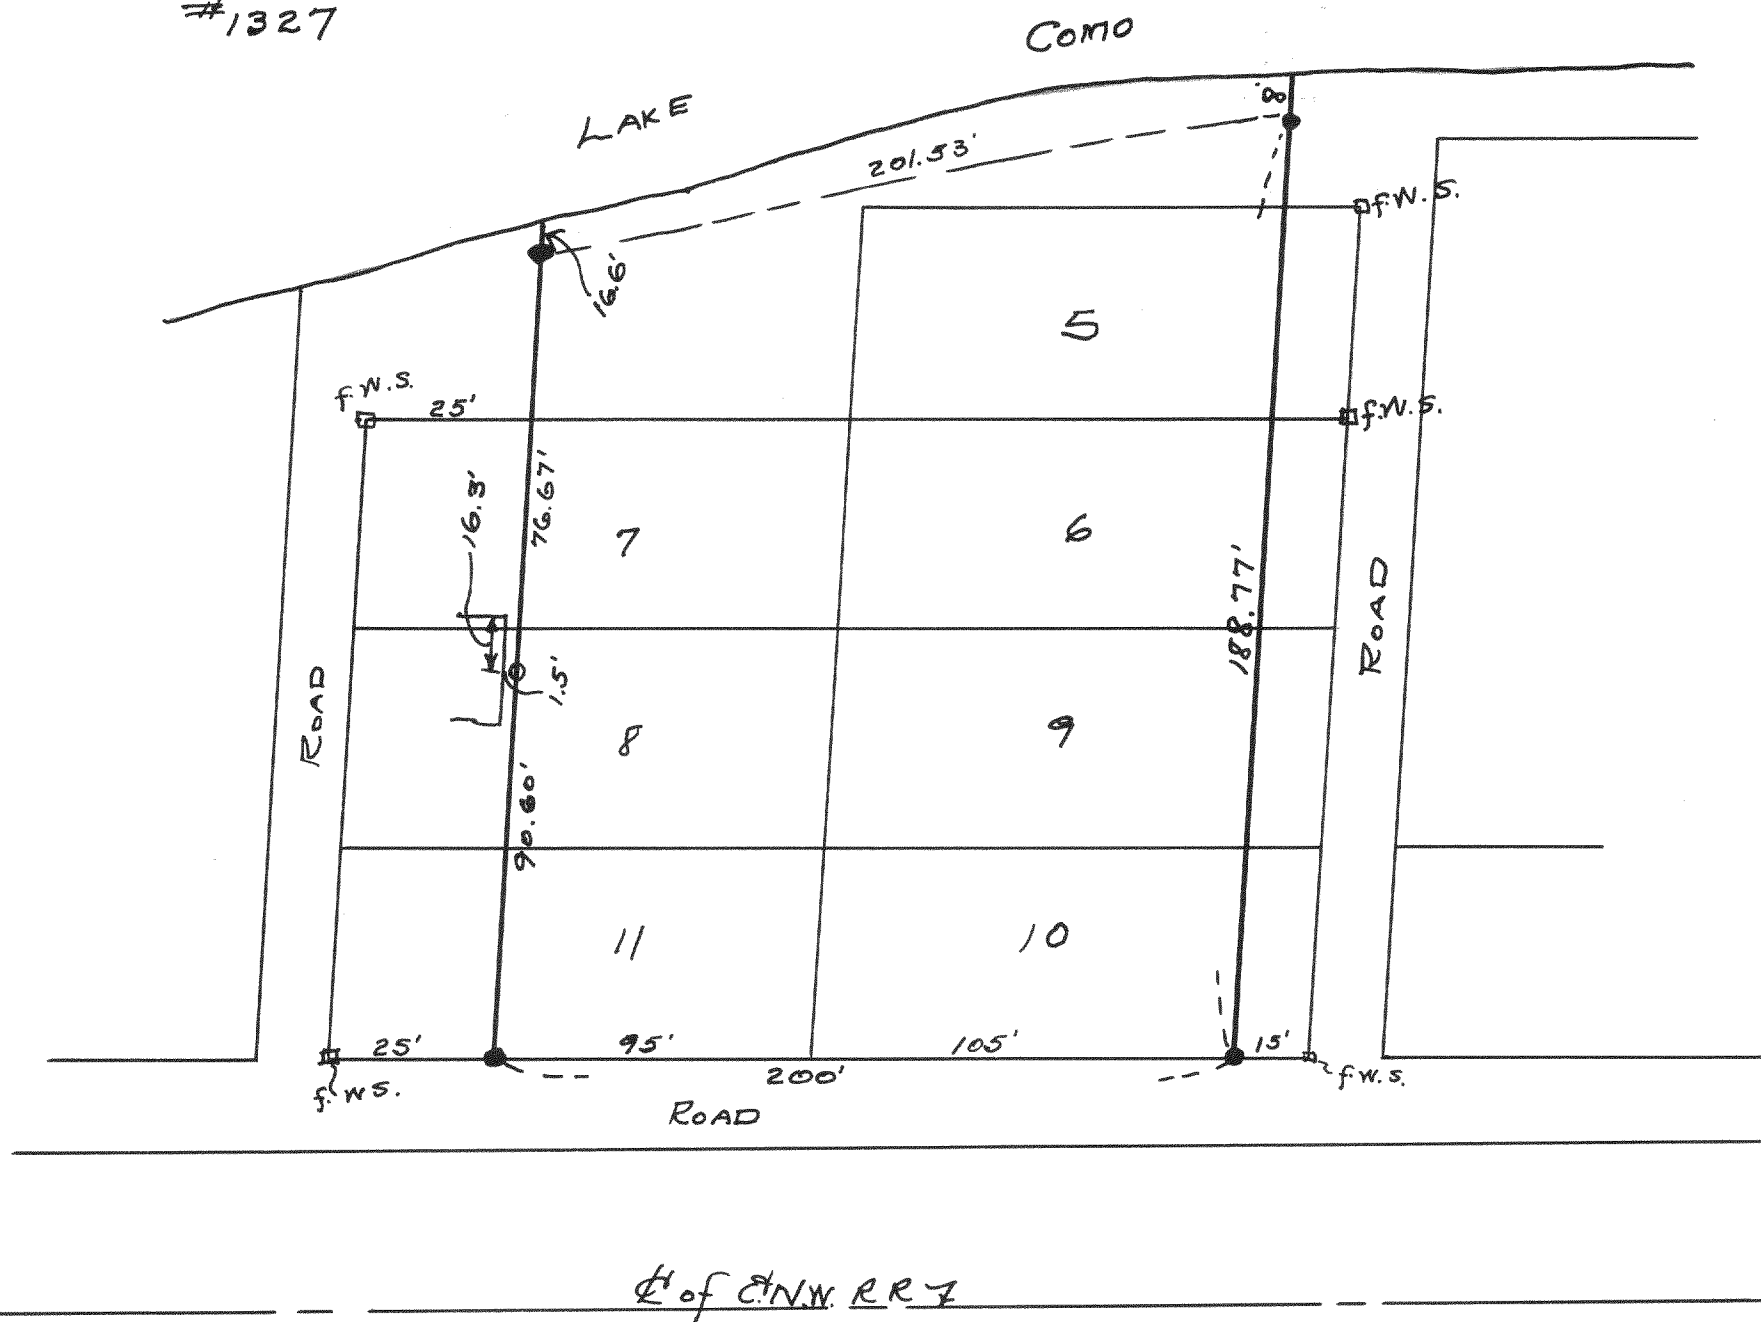


- - Conc. mound
- - Iron Pipe
- - wood Stake

Plot of survey of part of lots 5, 6, 7, 8,
9, 10 & 11 of Lackey-Johnson Subd.

July 7, 1942

Lloyd L. Jensen
County Surveyor

#1328

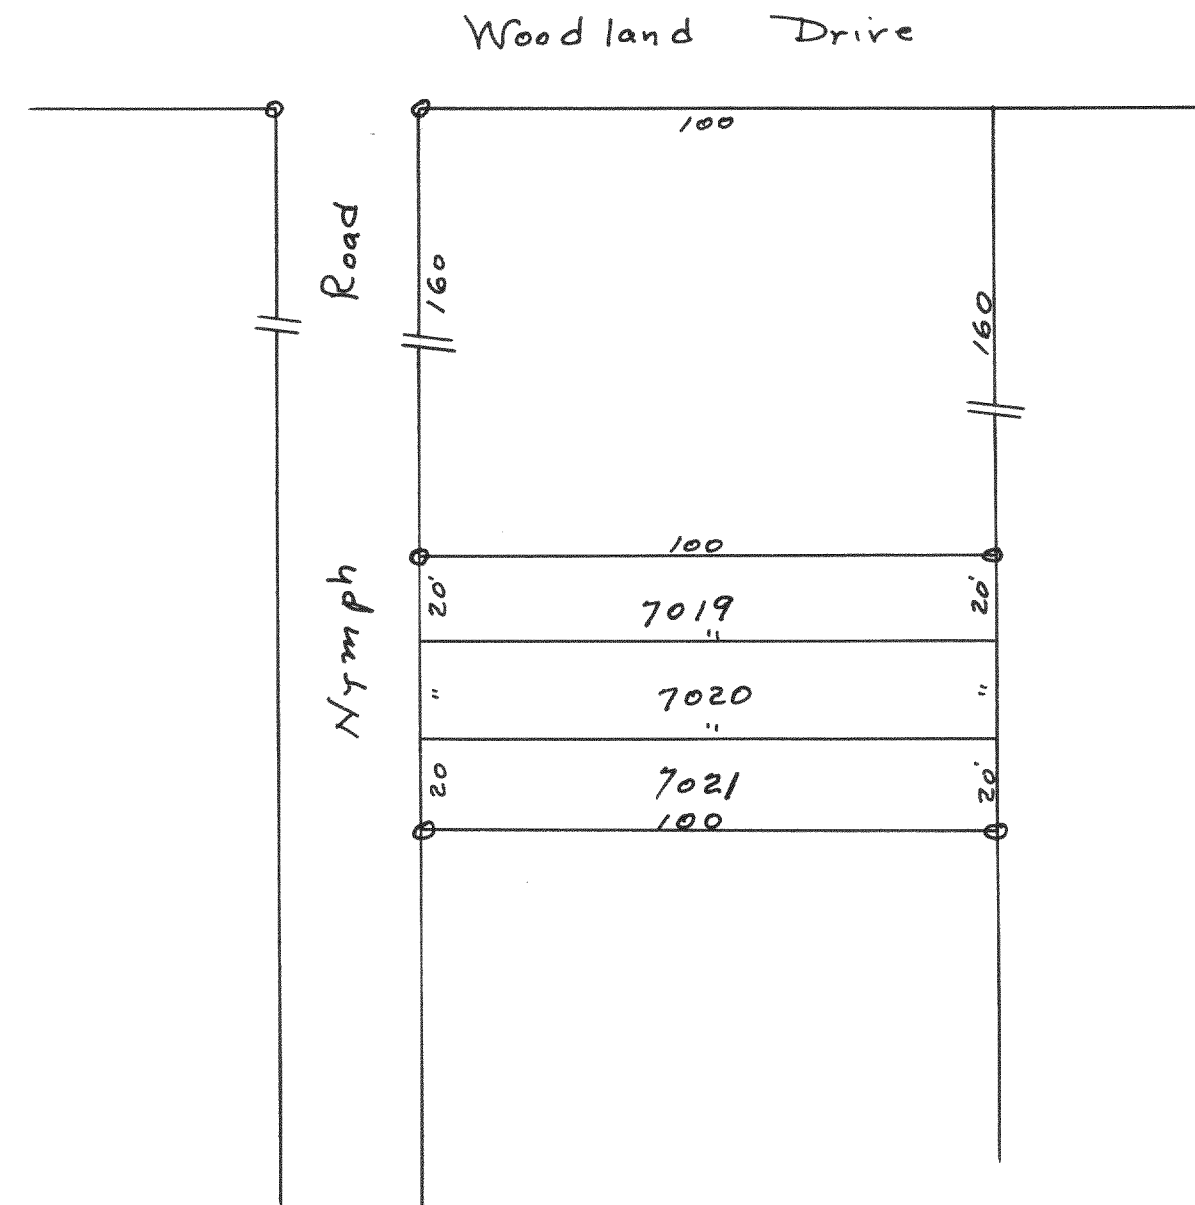

Plot of survey of lots 7019, 7020 &
7021 of Lake Como Beach Subd.

July 16, 1942

Lloyd L. Jensen
County Surveyor