


#1341

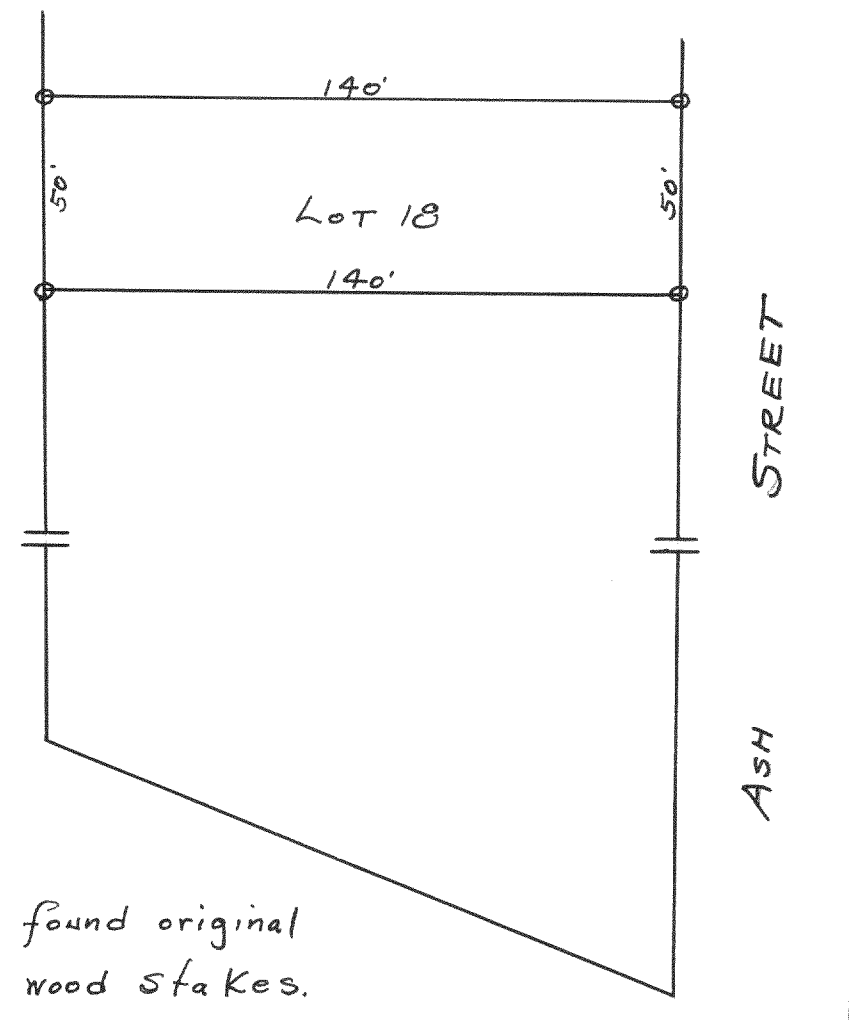


Note: found original
wood stakes.

Plot of survey of Lot 18 of
Block 8 of Miramar Subd.
located in Sections 10 and 11
T47N R18E.

Aug. 1942 Lloyd L. Jensen
County Surveyor

#1342

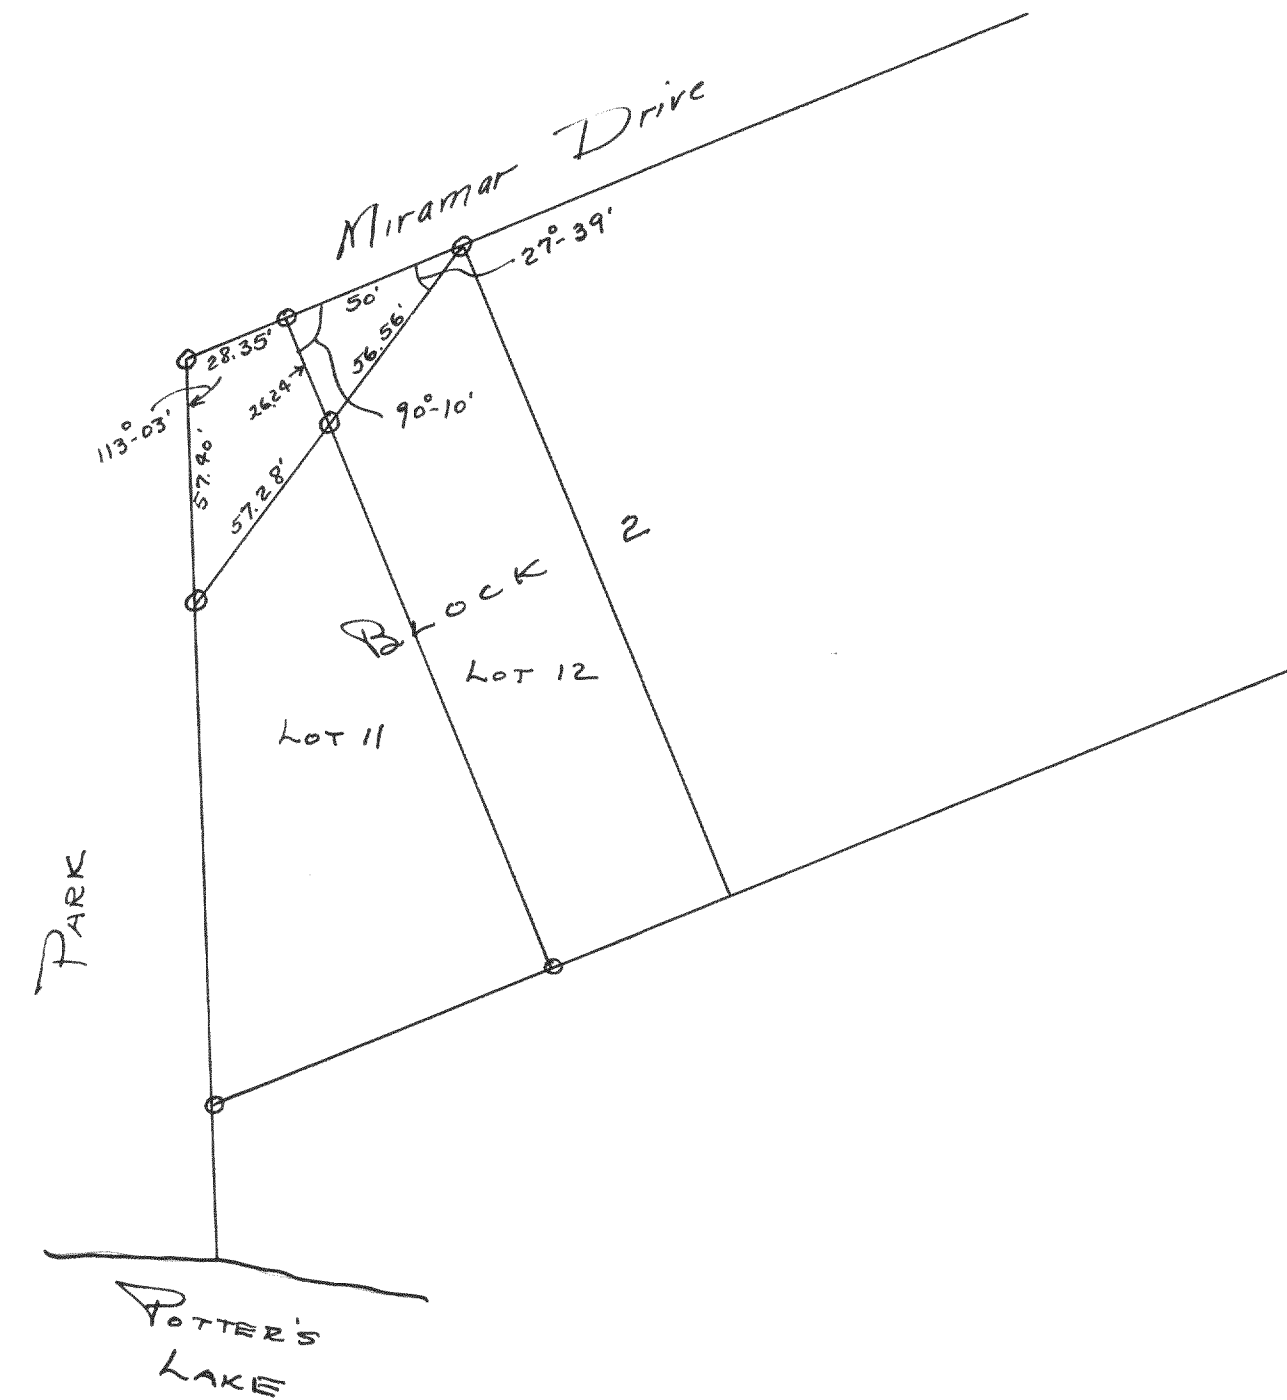

Plot of survey of part of Lot 11
and 12 of Block 2 of Miramar
Subd., located in Sections 10 and
11, T47N R18E.

Aug. 1942 Lloyd L. Jensen
County Surveyor