


#1379

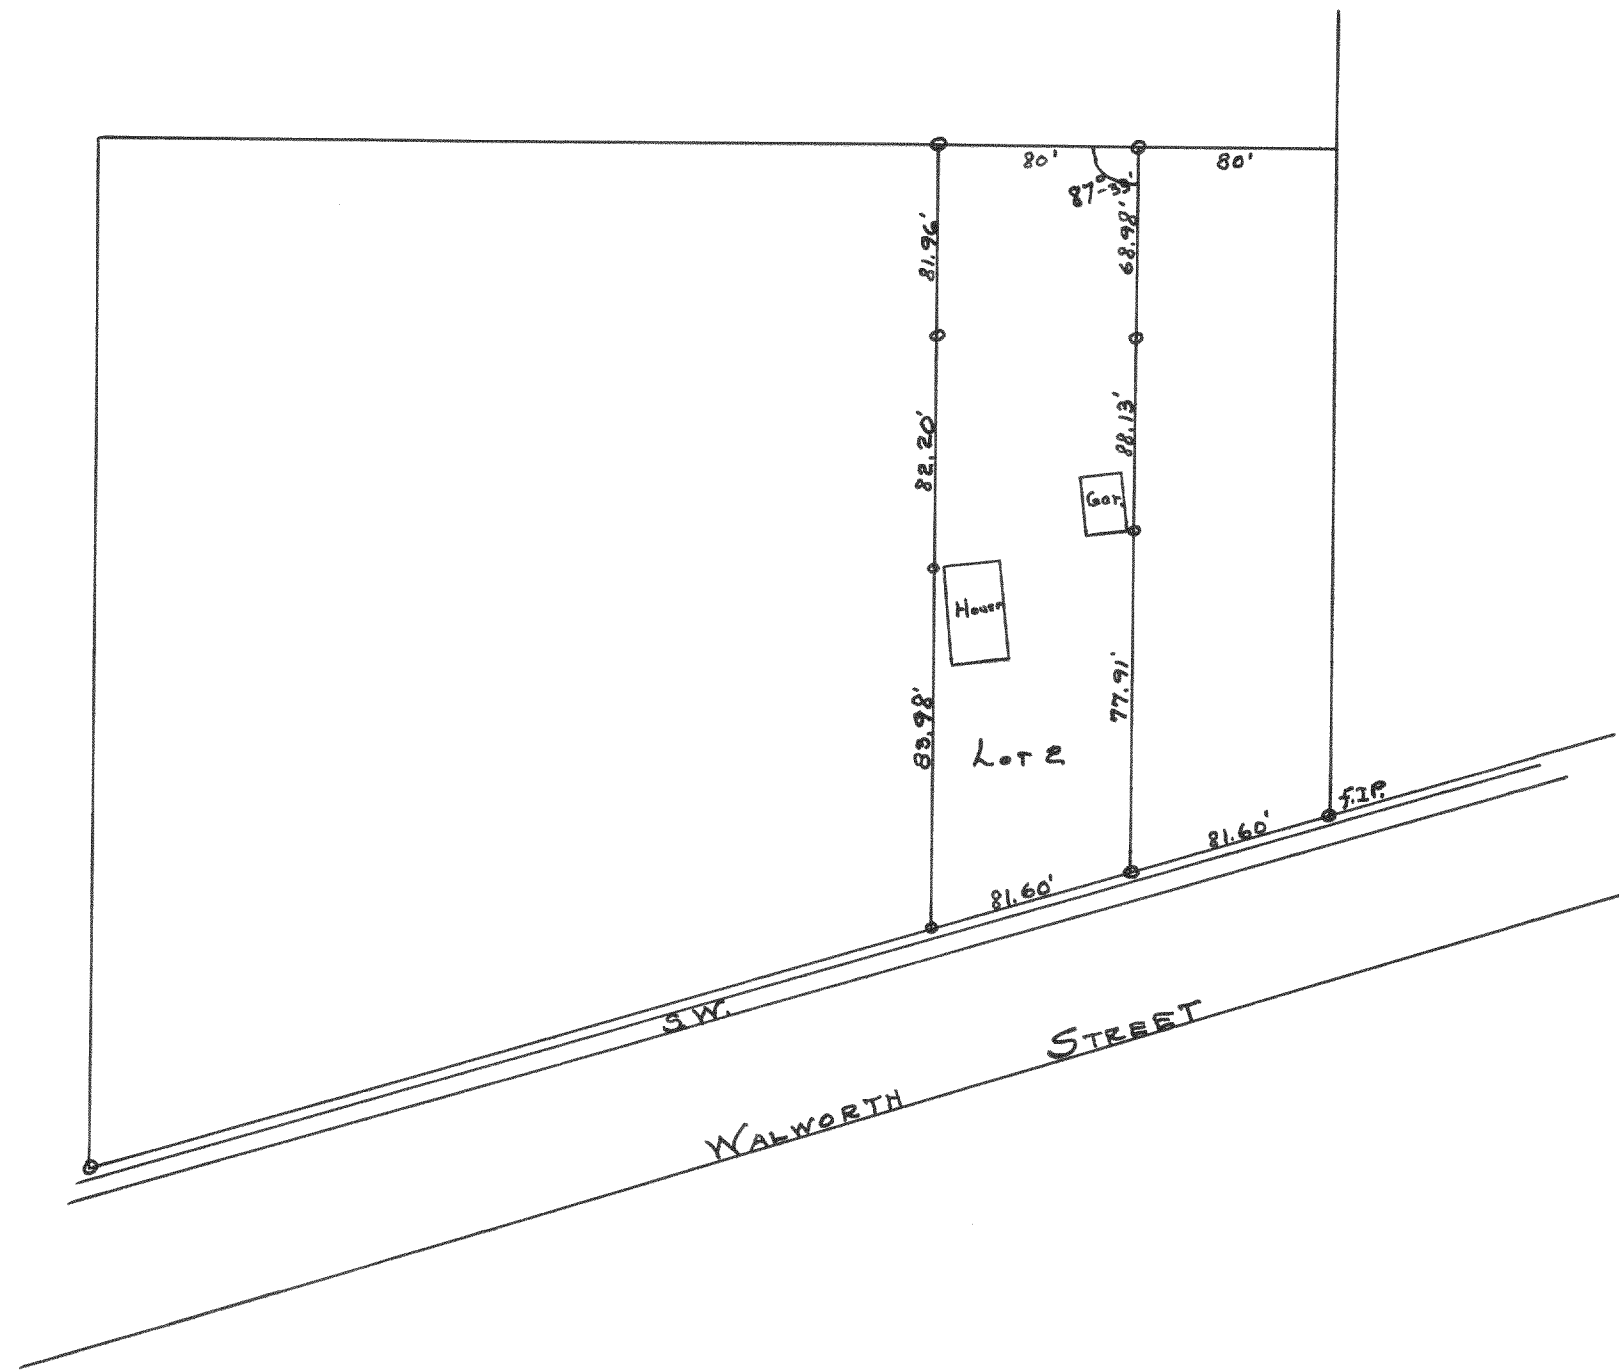


Plot of survey of Lot 2 of Ciccia Ogden's Subd. in the City of Elkhorn, Wis.

Apr. 26, 1943

Lloyd S. Jensen
County Surveyor

#1380

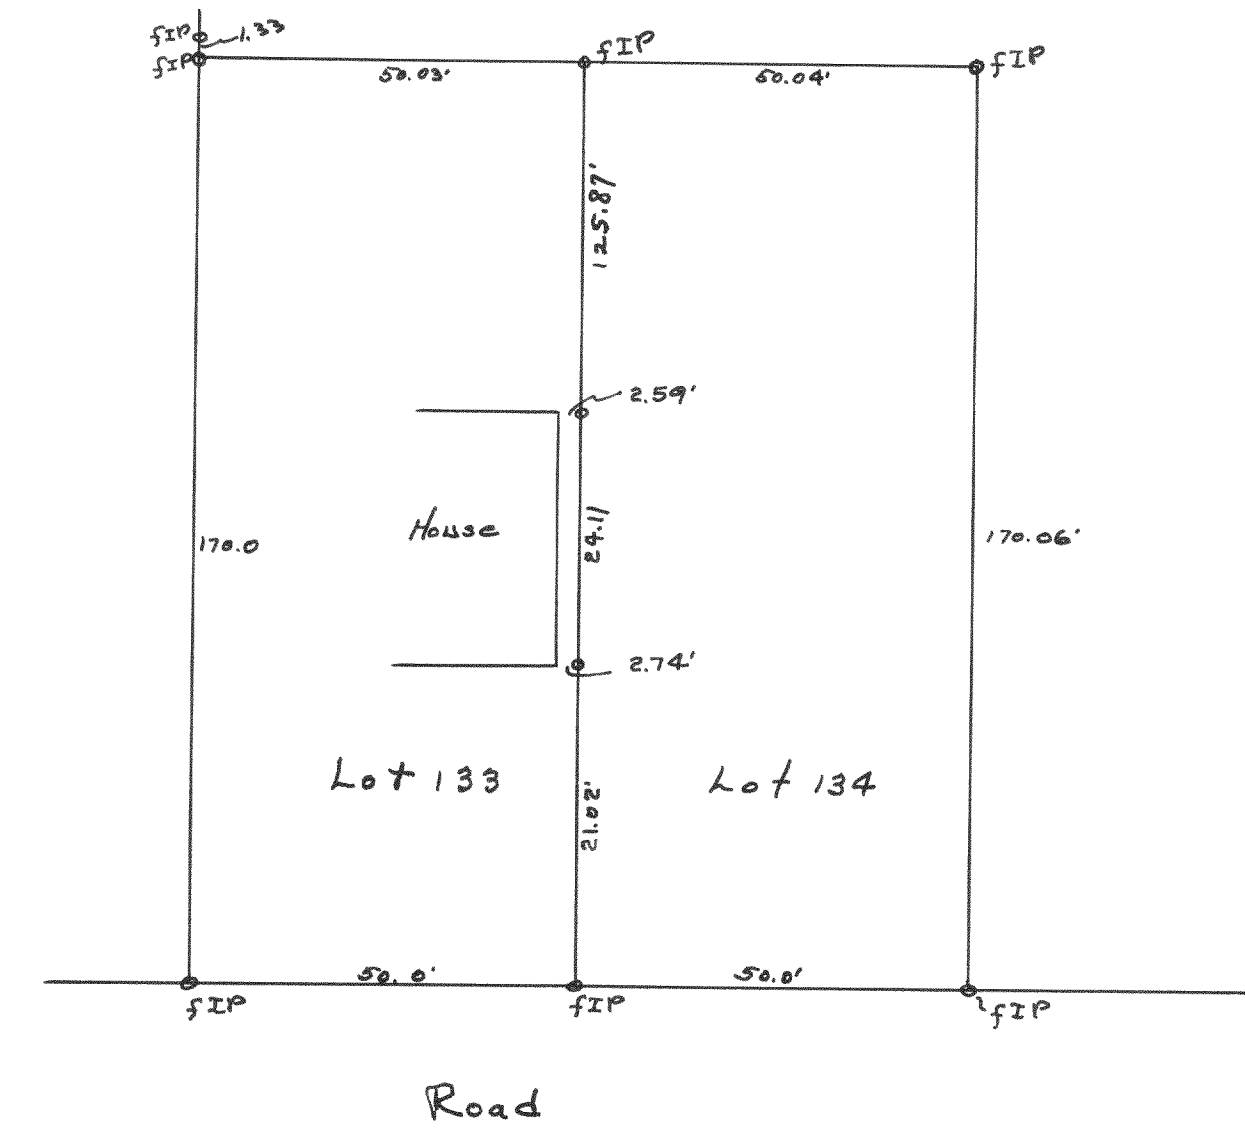

Plot of survey of Lot 133 of Lake Geneva Beach Subd. in Section 11, T14N R17E.

July 29, 1943

Lloyd S. Jensen
County Surveyor