



#1418

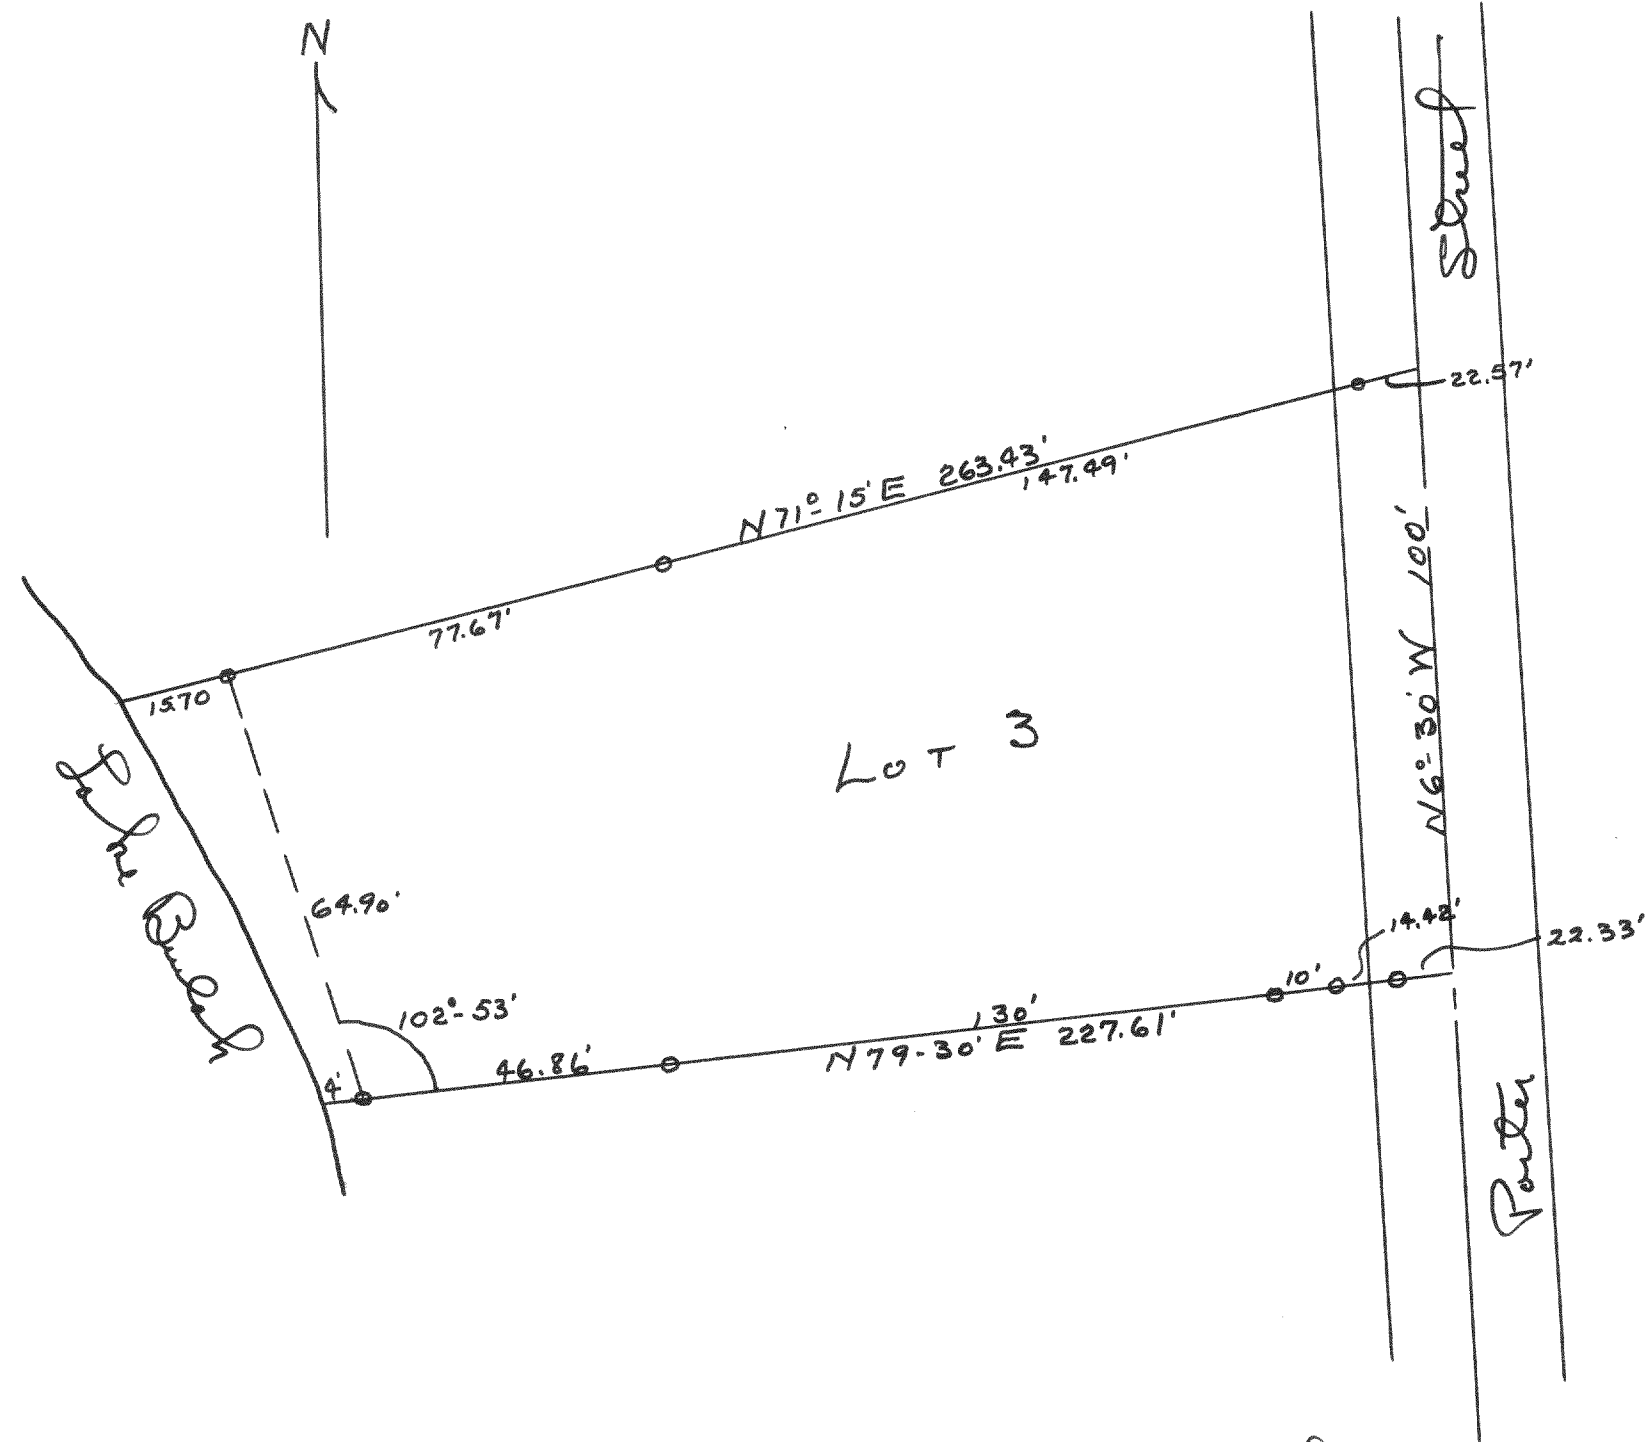

#1419

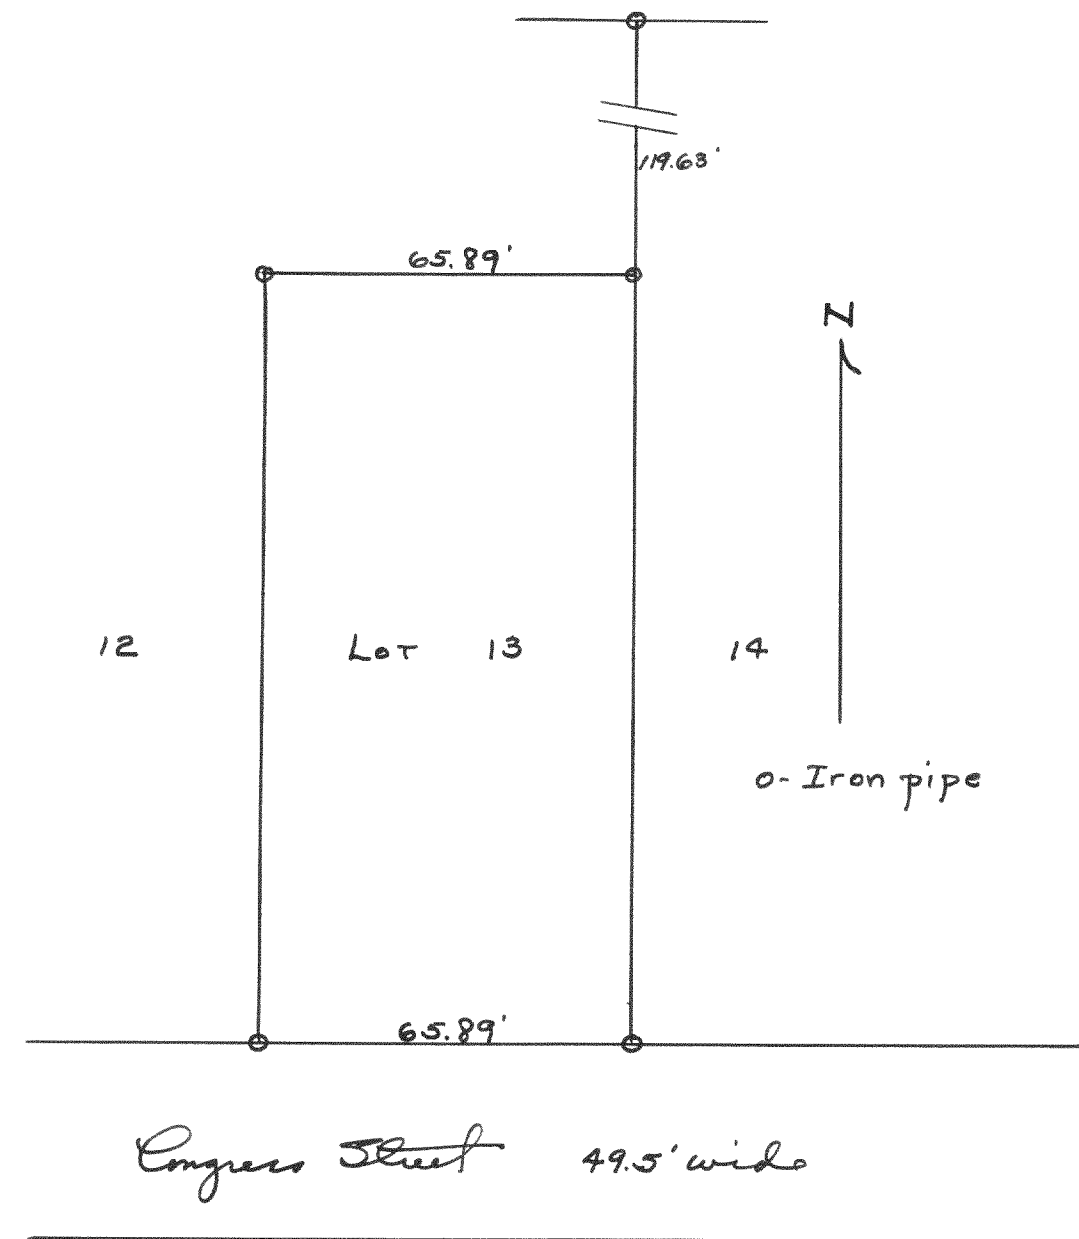

Plat of survey of Lot 3 of Block 2 of Freed Park, Section 4, T47N R18E.

Nov. 1943

Lloyd S. Jensen
County Surveyor

Plat of the survey of Lot 13 of Johnson's Add. to the Village of Wm Bay.

Aug. 1943

Lloyd S. Jensen
County Surveyor