


226

1609

226
1609
The lot is
the same as

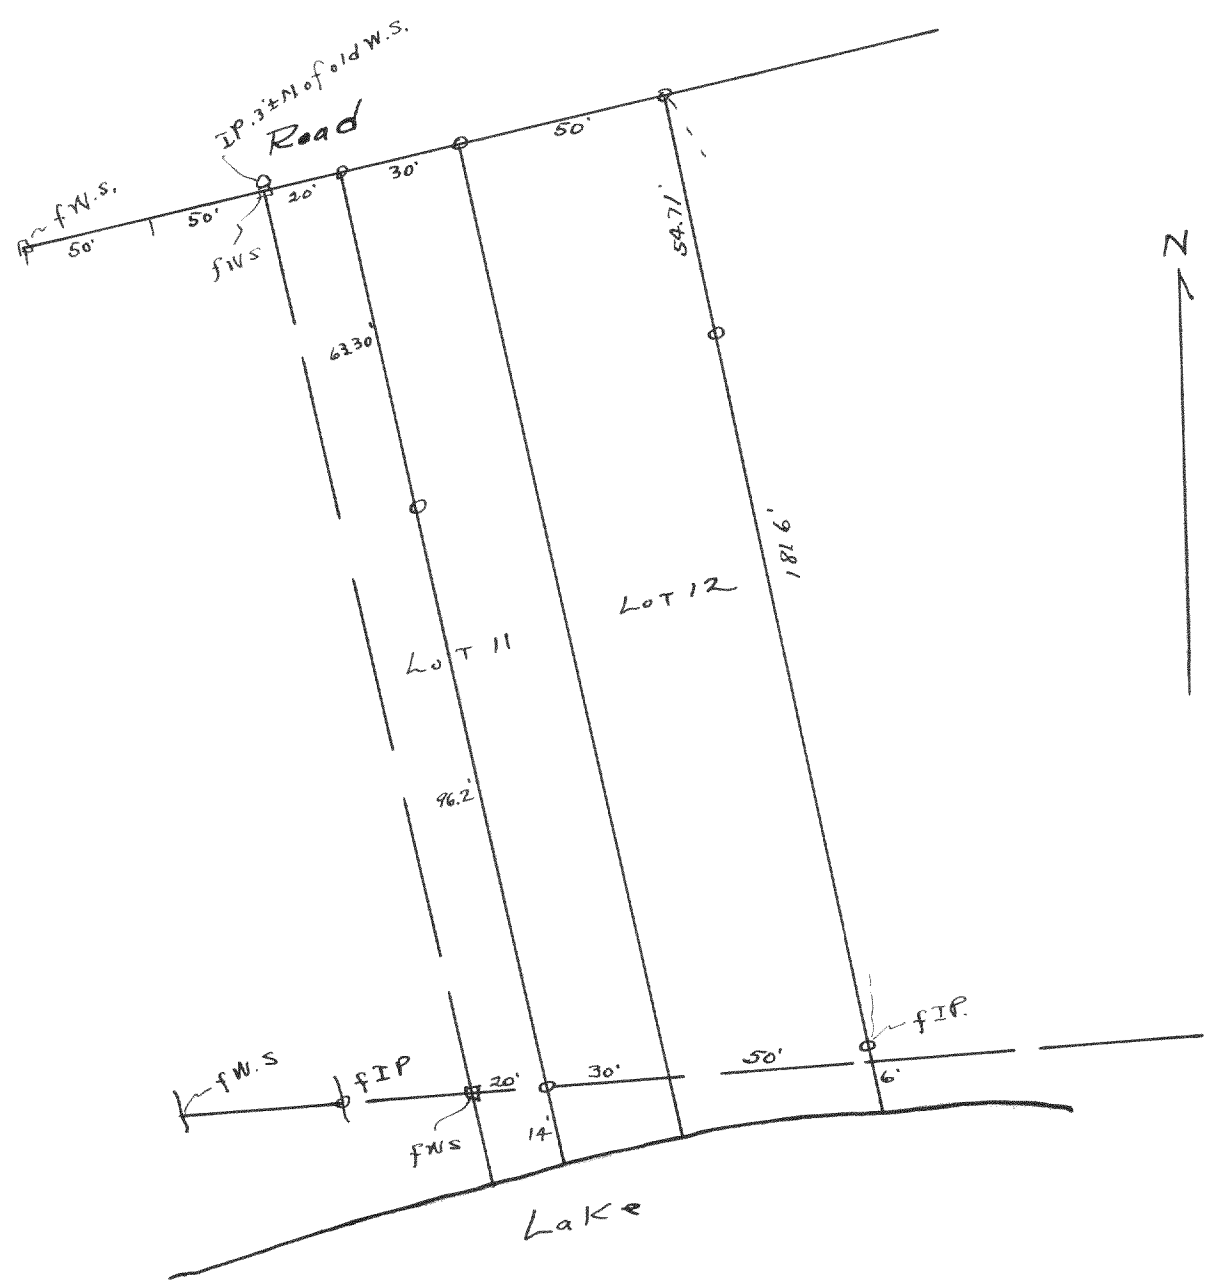


Plot of survey of Lot 12 and the
E. 30' of Lot 11 of the 1st. Add. to
Sundance Park.

June 1945

Lloyd S. Jensen
County Surveyor

1610

226

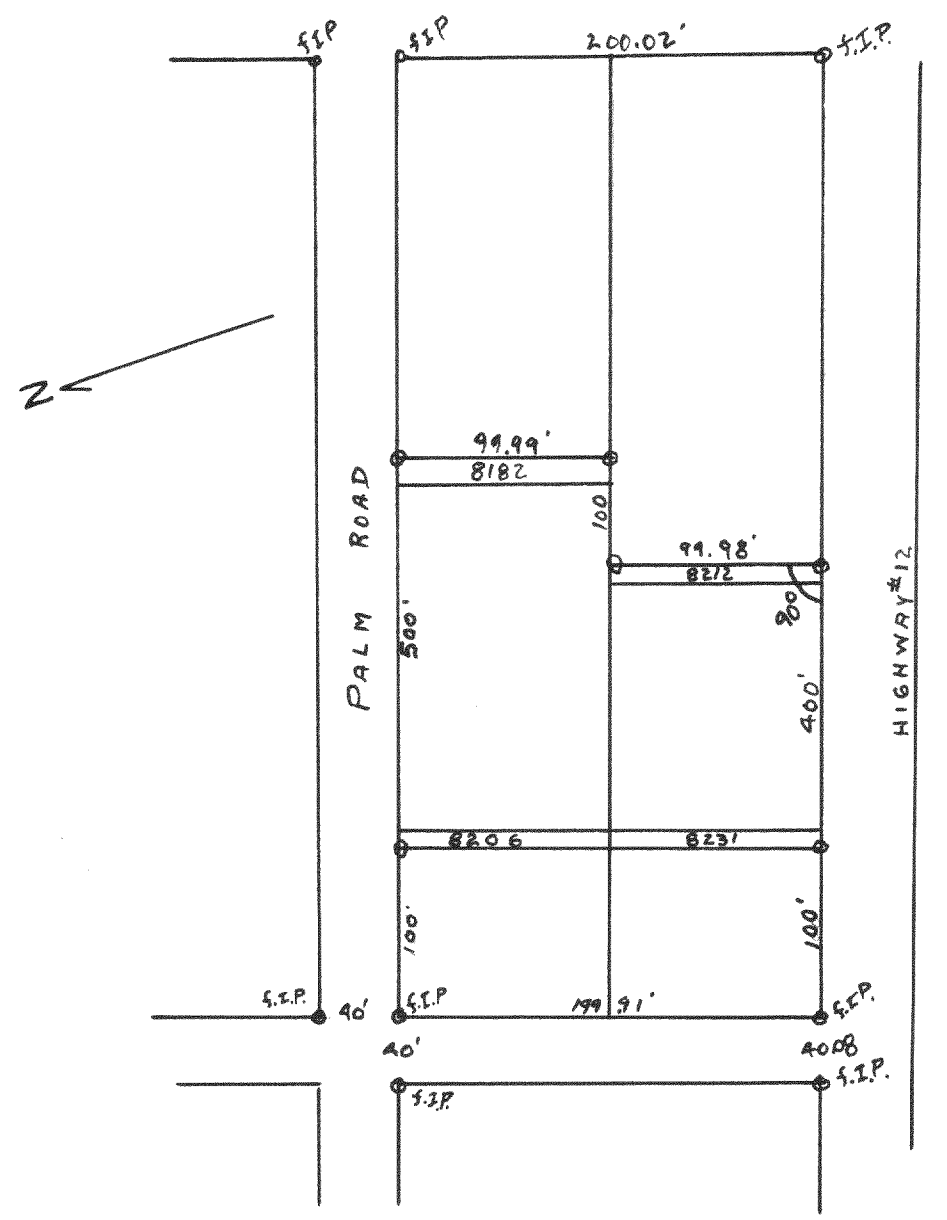

Plot of survey of Lots 8182 to 8206 and
Lots 8212 to 8231 in section 5 of Pell Lake
Subdivisions Walworth County, Wisc.

Oct. 1946

Lloyd Jensen
County Surveyor
G.T.D