



#1635

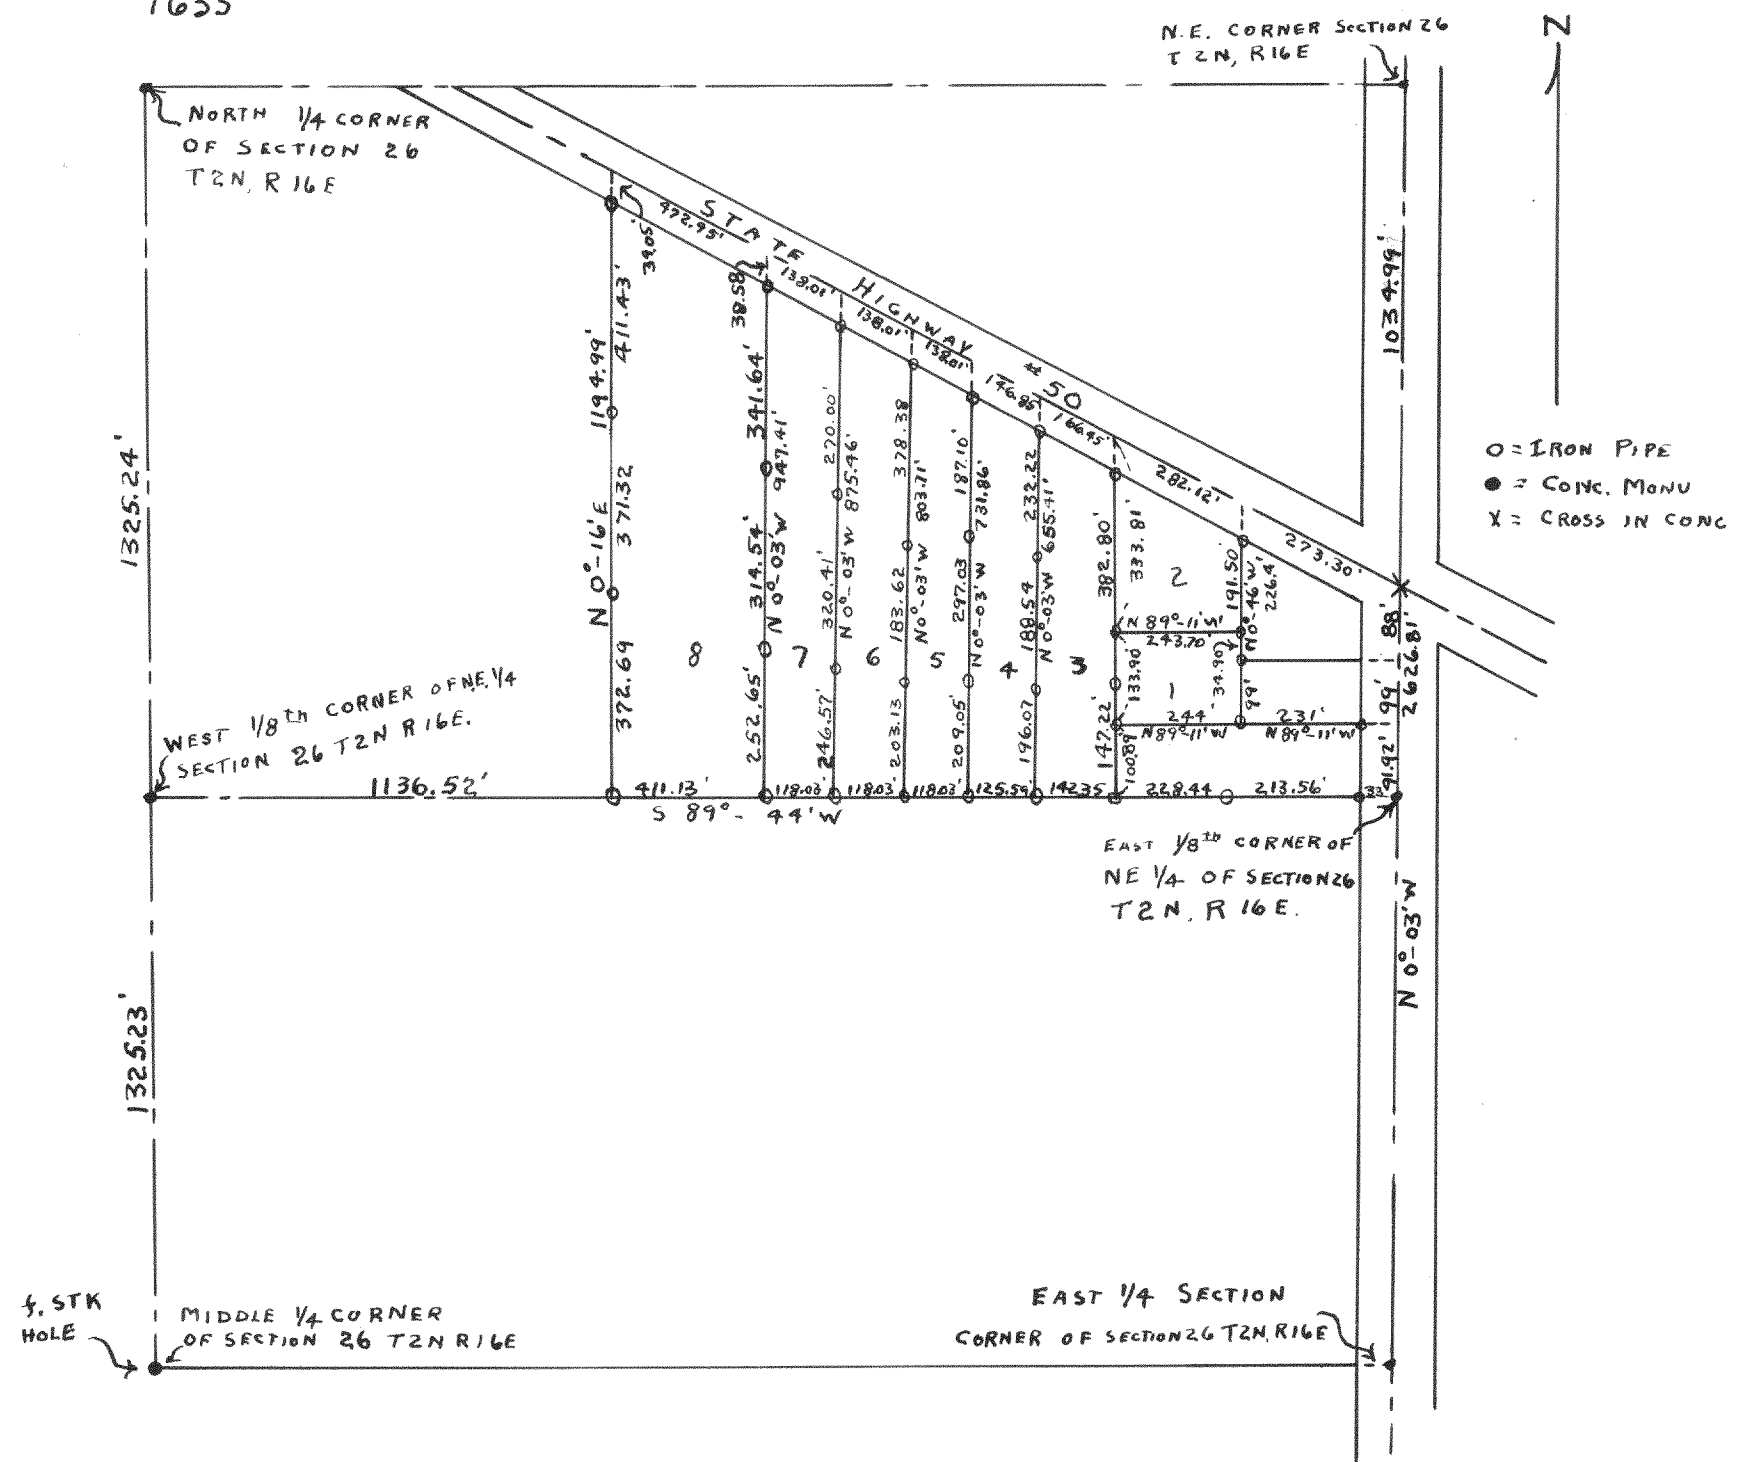

Plot of Survey of Parcels of land 1 to 8 on the Wickstrom Farm located in the NE 1/4 of Section 26 T2N, R16E Walworth County Wisconsin
 Lloyd L Jensen
 County Surveyor
 Oct 1946
 G.T.D.

#1636

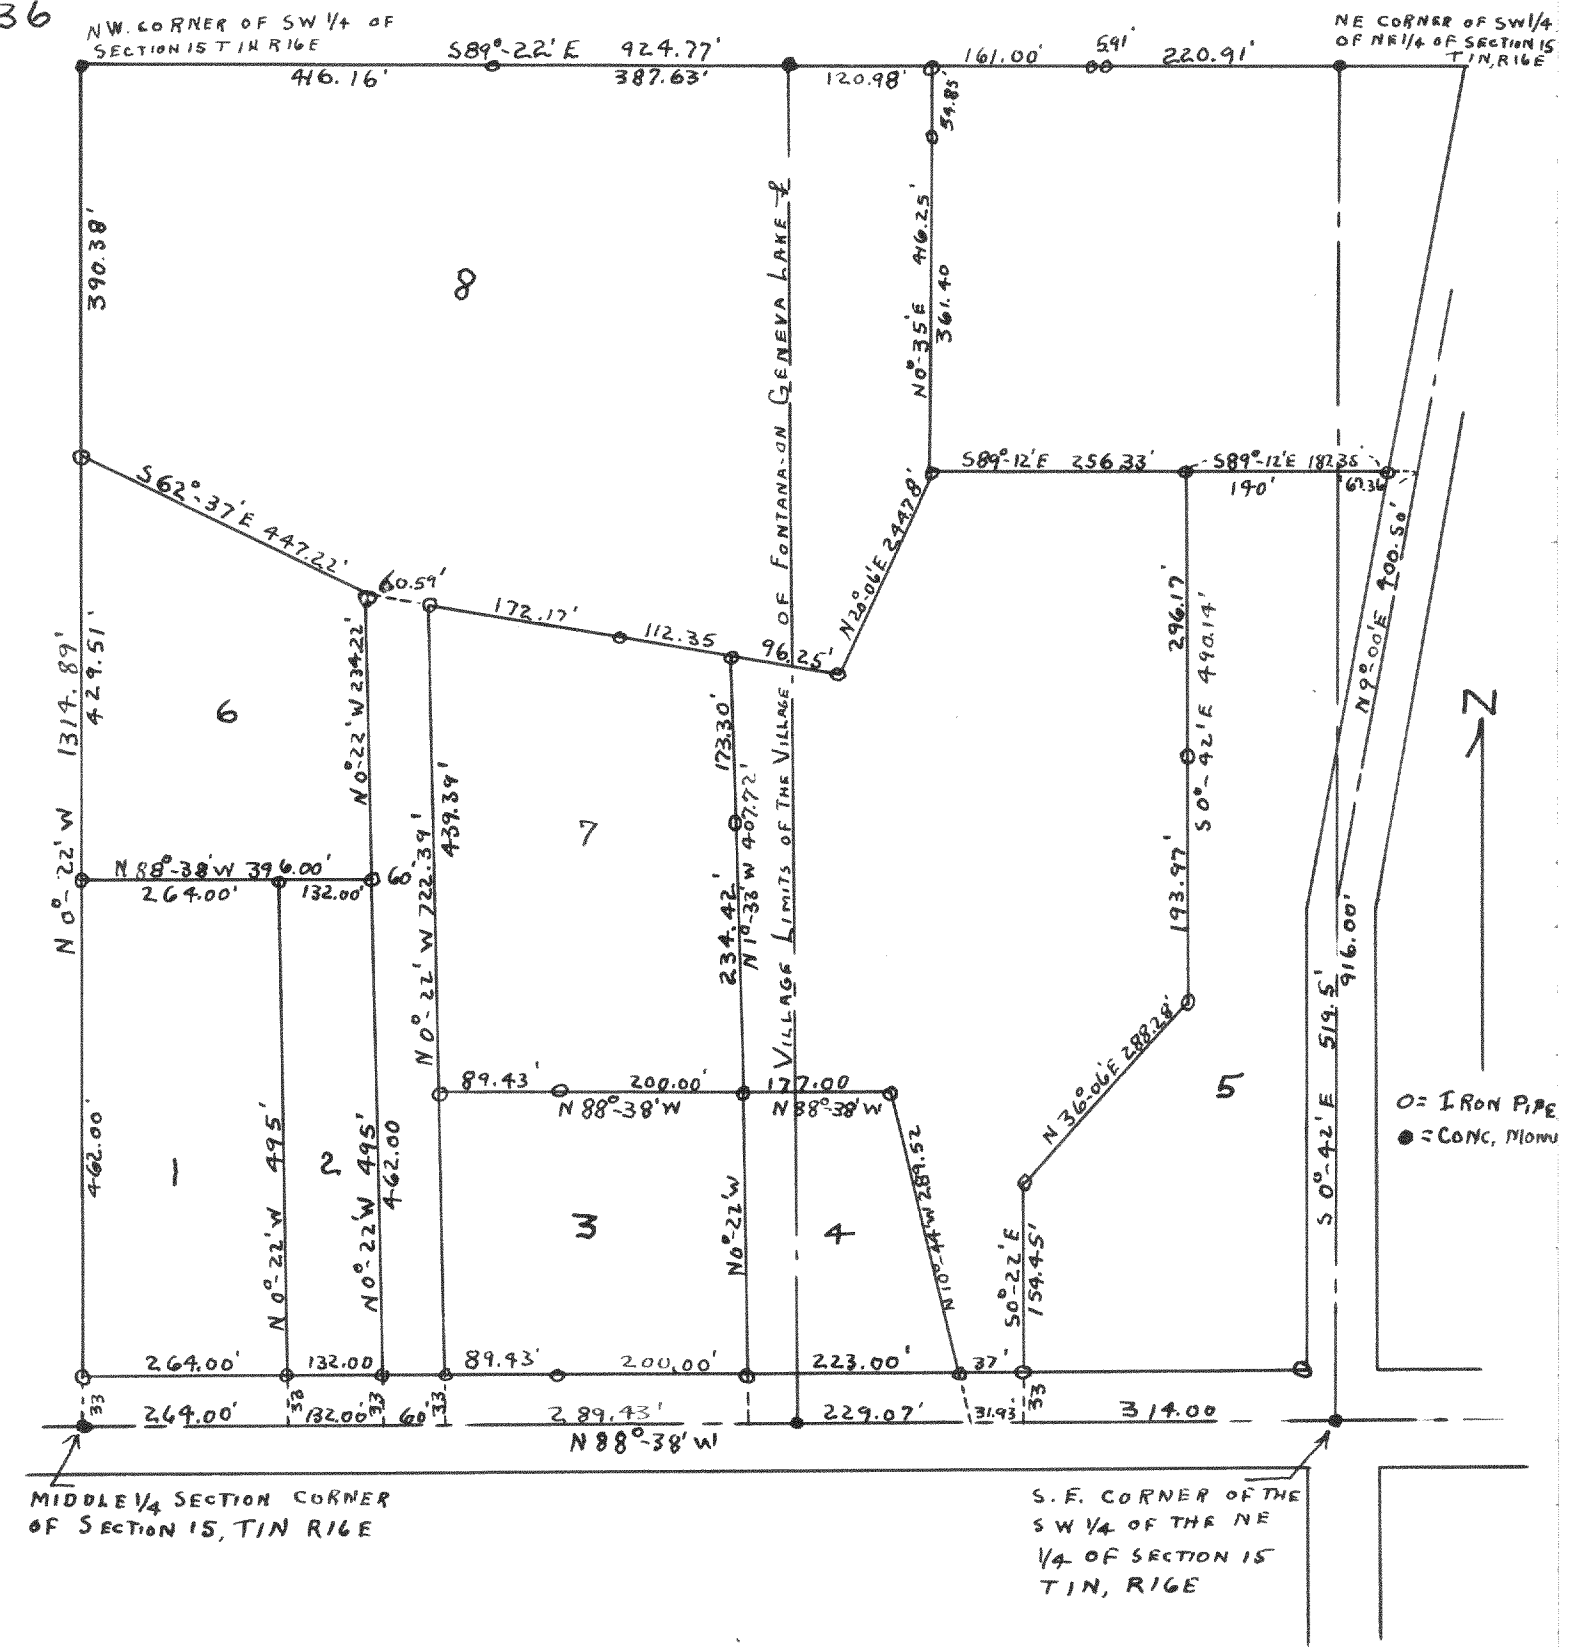

Plot of Survey of land located in the SW 1/4 of the NE 1/4 of section 15 T1N R16E part of which is known as Outlot 18 of Assessor's Plot No. 1, C.L. Douglas Addition to the Village of Fontana-on-Geneva Lake Walworth County Wisconsin

Lloyd L Jensen
 County Surveyor
 Feb. 47
 G.T.D.