


#1748

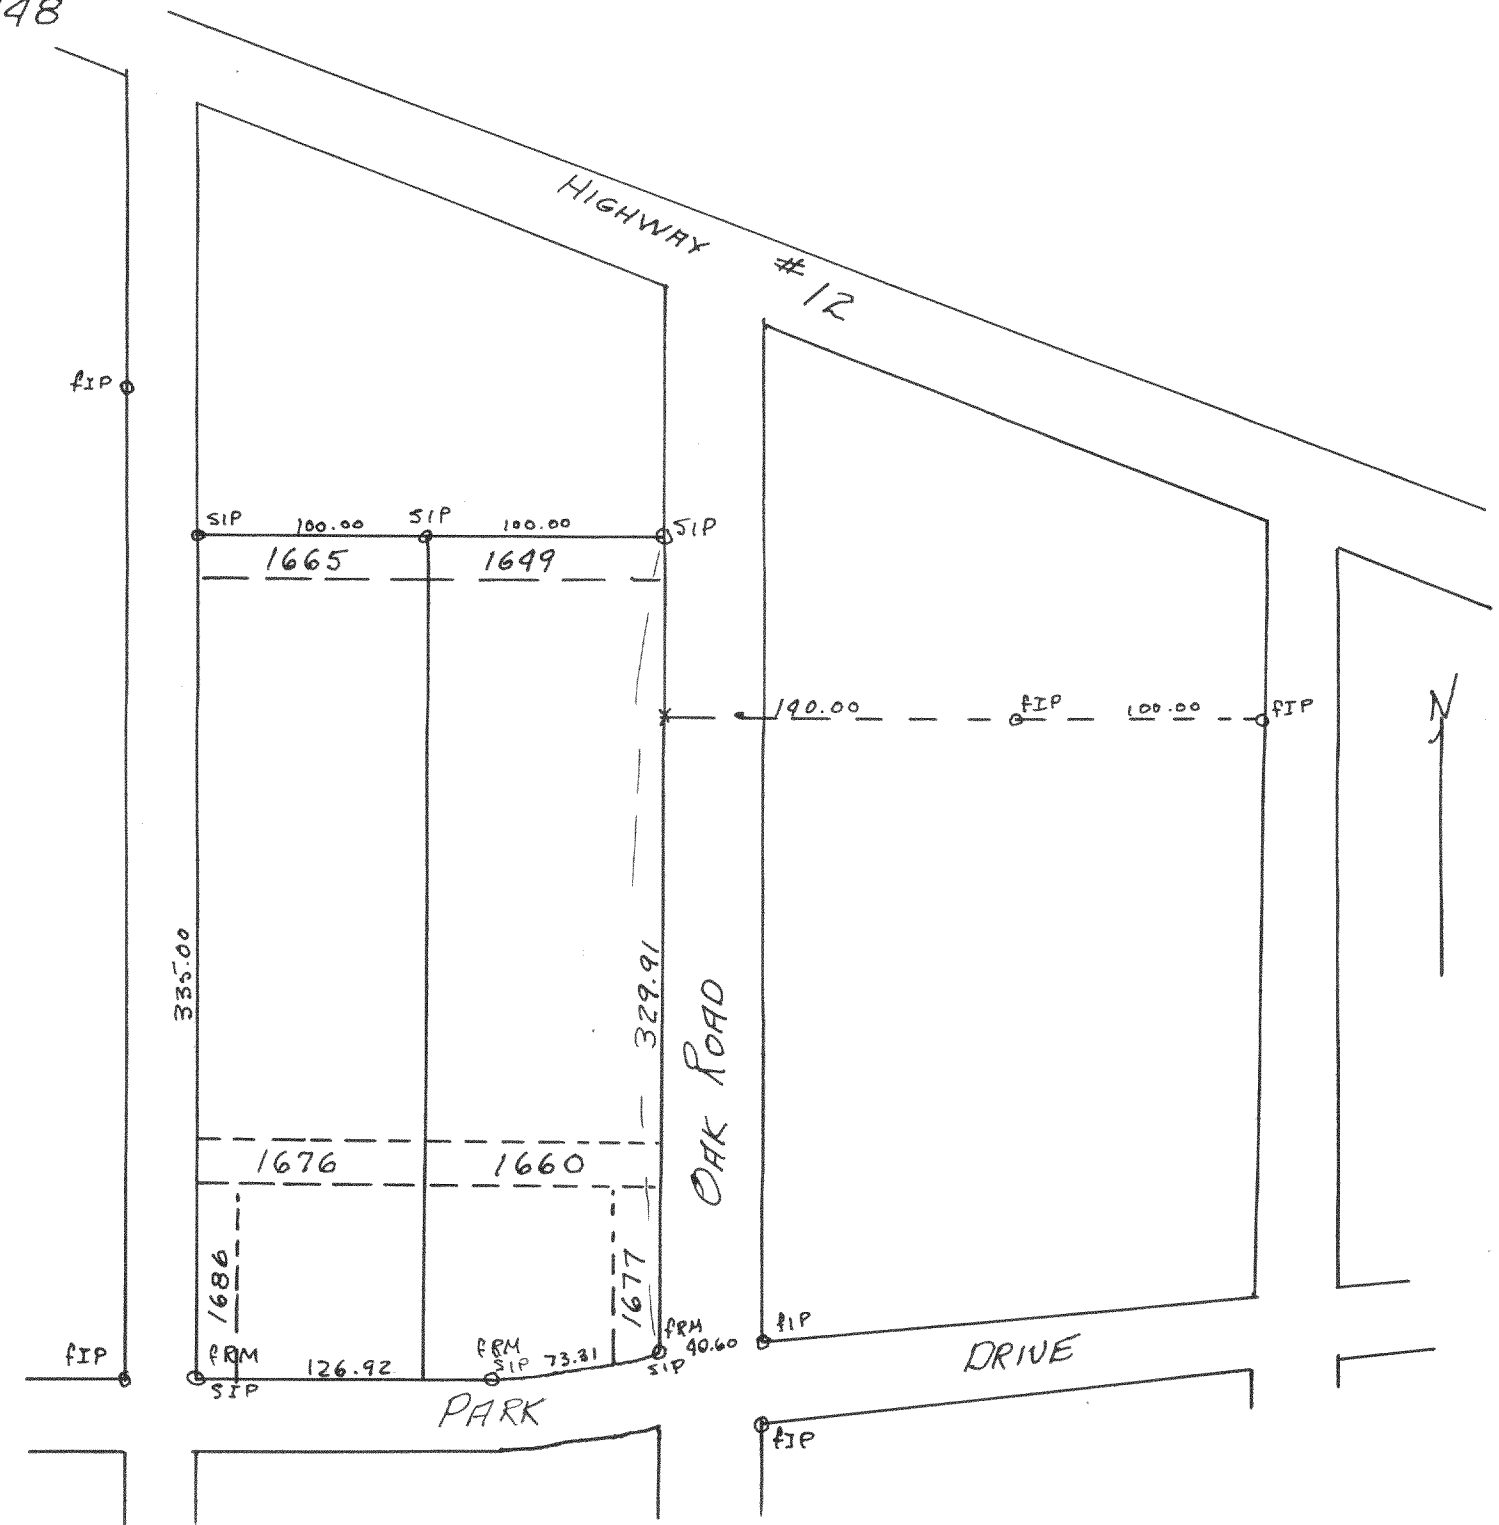


Plot of survey of lots 1499-1460, 1465-1480 Lake Como Beach
 subdivision, Malworth County Wisconsin

May 26, 1947

Lloyd & Jensen
 County Surveyor
 LJS

#1749

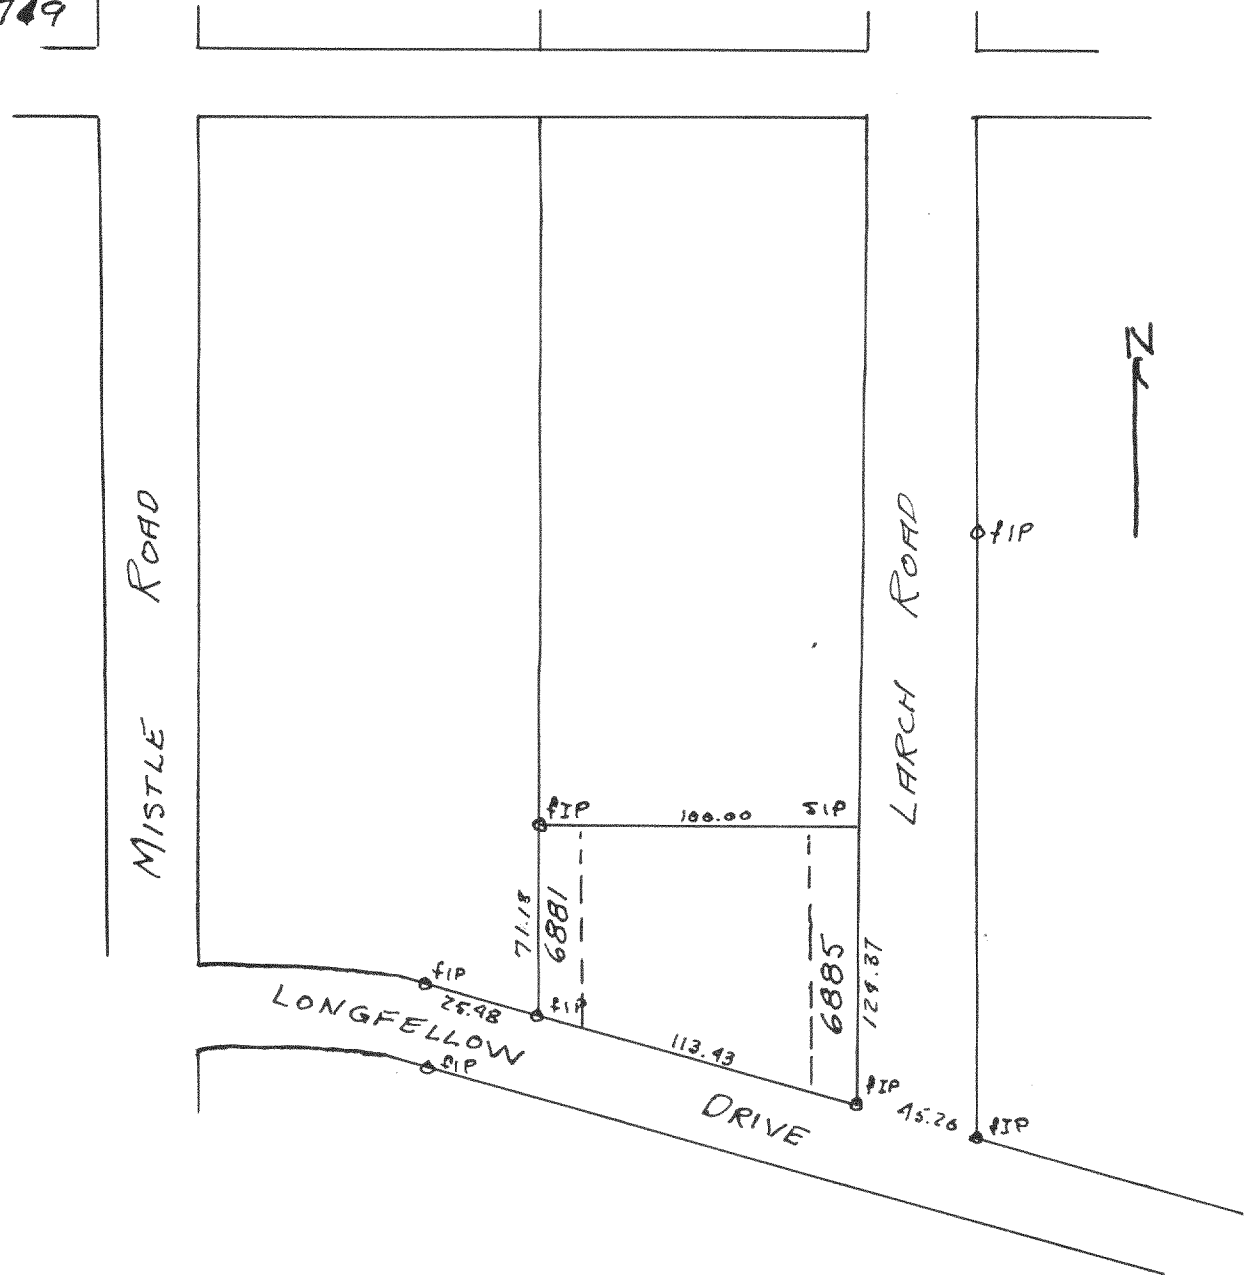

Plot of survey of lots 6881-6885 Lake Como Beach
 subdivision, Malworth County Wisconsin

May 26, 1947

Lloyd & Jensen
 County Surveyor
 LJS