


1805

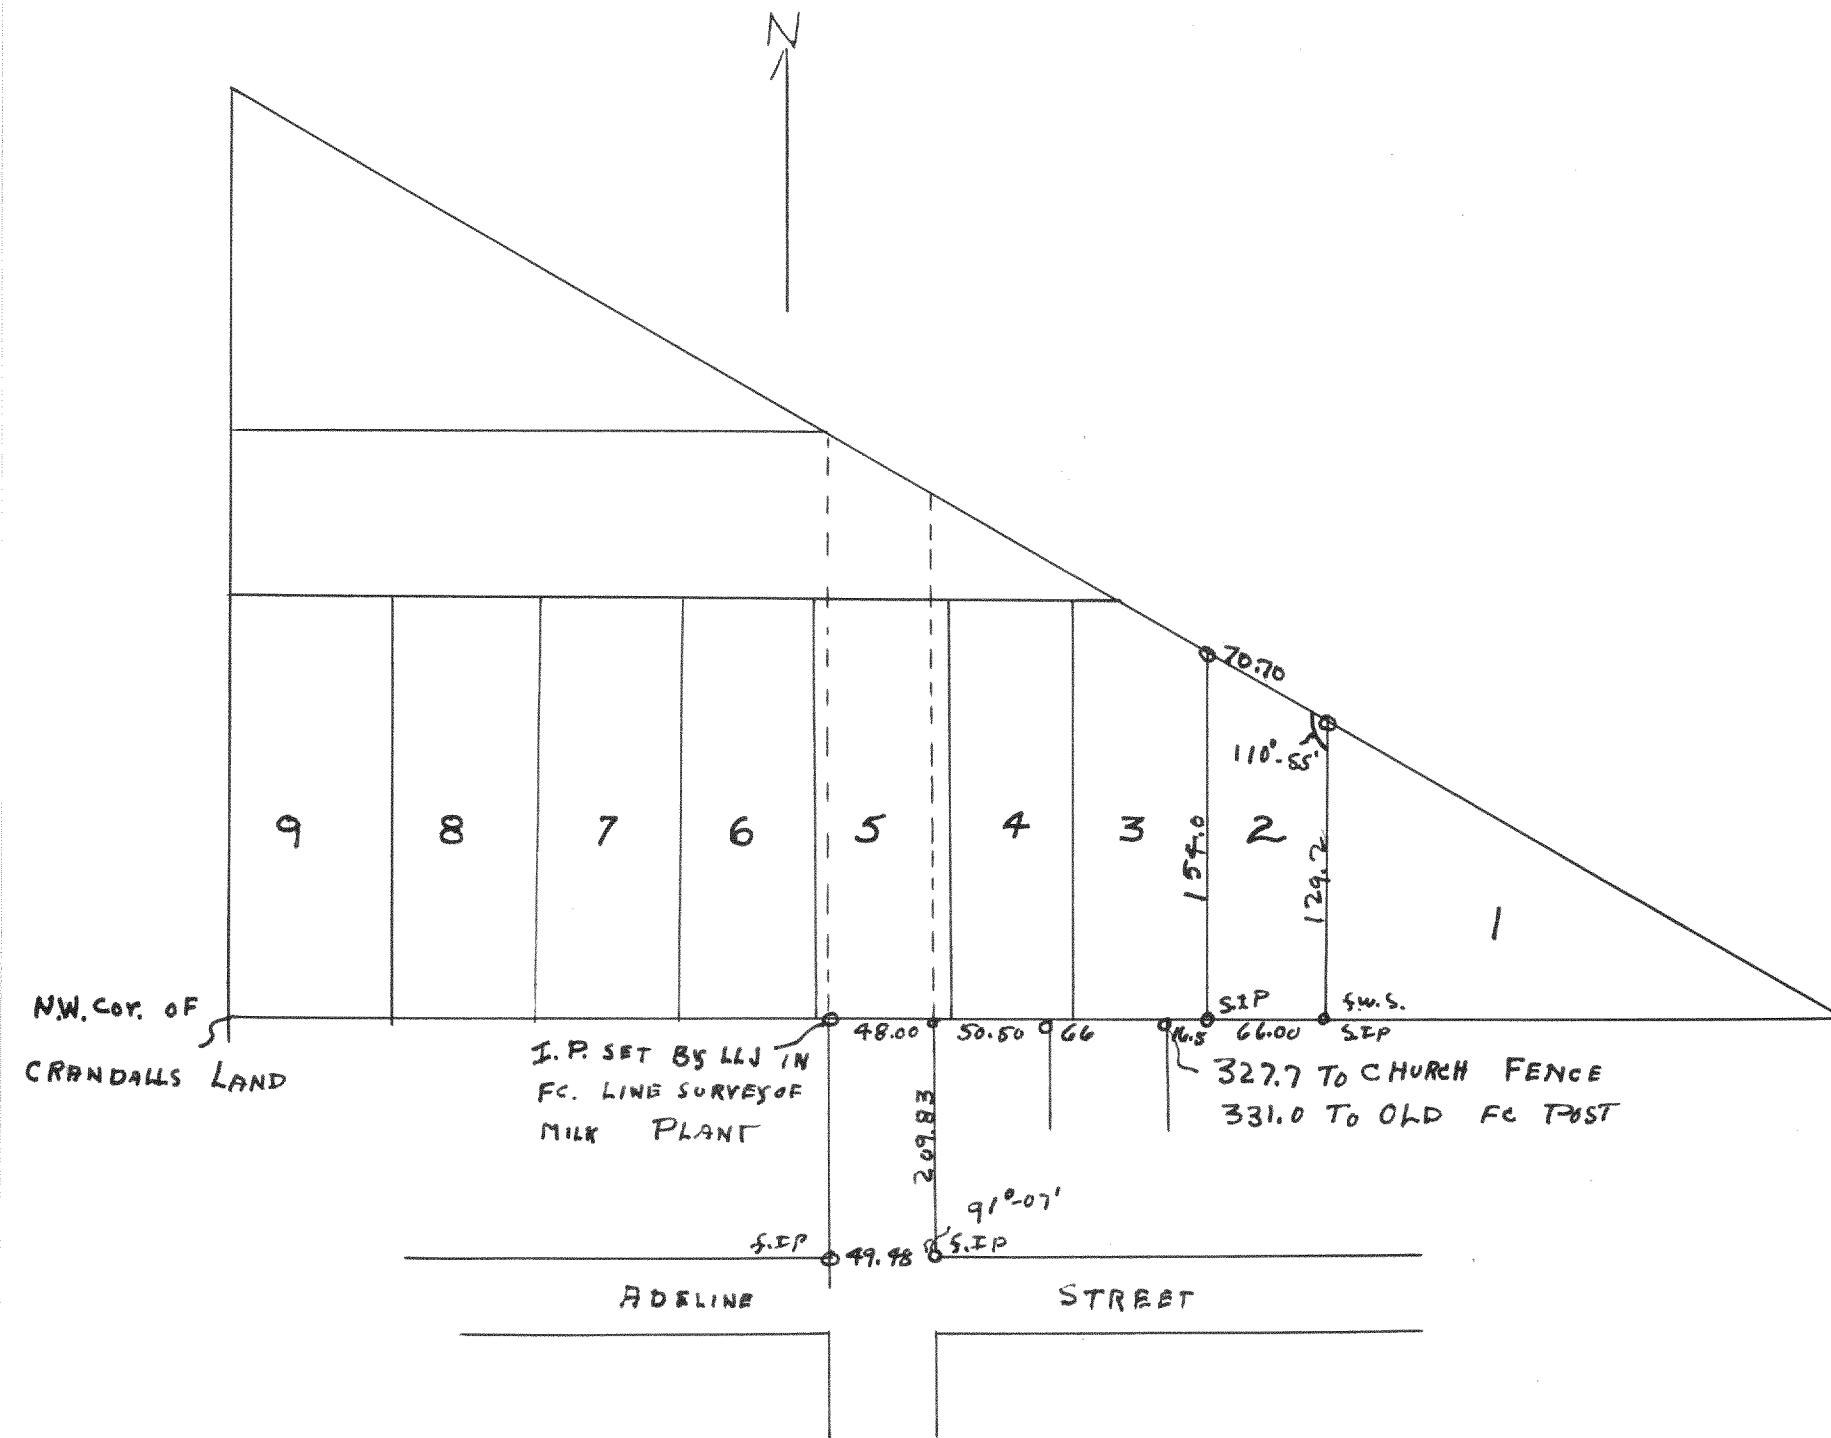


Plot of survey of Lot 2 of Longworth's Subdivision located in the village of Malworth, Malworth County, Wisconsin

Sept 5, 1947

Lloyd & Jensen
County Surveyors

1806

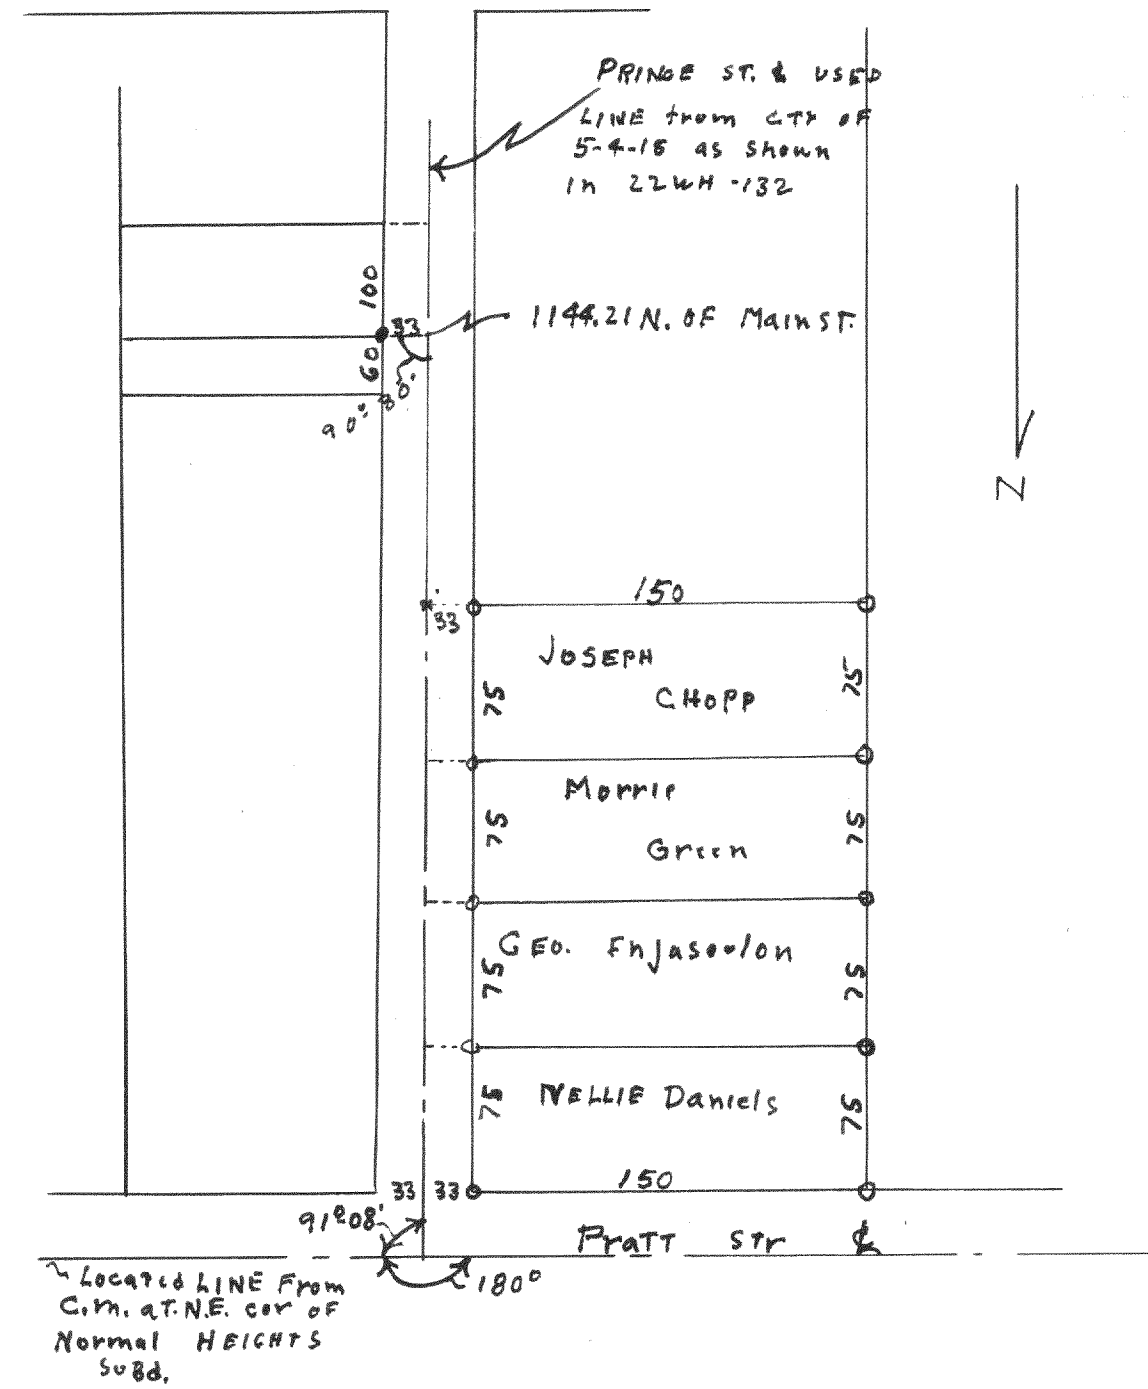

Plot of survey of parcels of land along Prince Street starting at the corner of Prince and Pratt Street in the City of Whitefish, Malworth County, Wisconsin
April 21, 1947

Lloyd & Jensen
County Surveyors