



N 1818

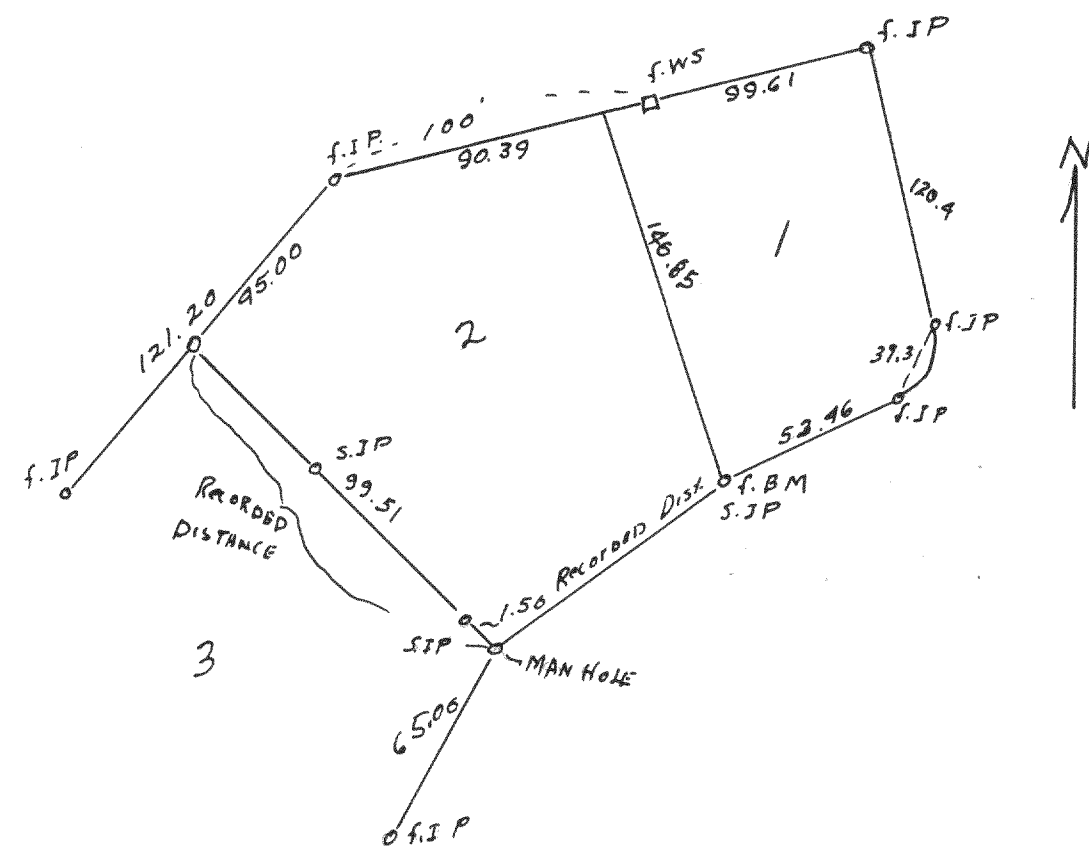

Plat of survey of Lot 2 Block C Country Club Estate in
 the Village of Fontana, Walworth, County
 Dec. 10, 1948
 Lloyd L. Jensen
 County Surveyor.
 C.S.

N 1819

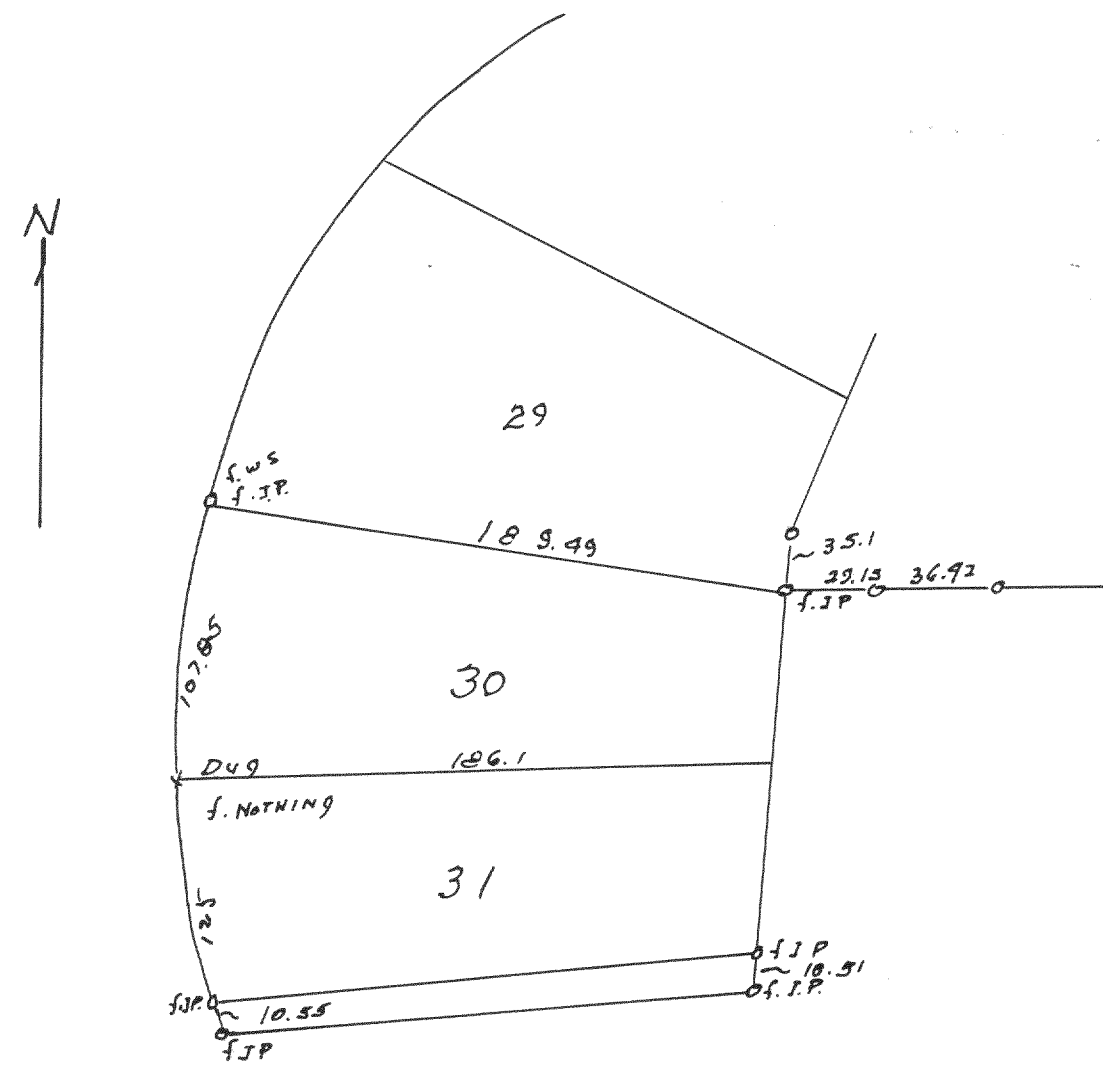

PLAT of Survey of lots 30 + 31 Unit 1 Country Club Estate
 in the Village of Fontana Walworth, County
 Dec 21, 1948
 Lloyd L. Jensen
 County Surveyor.
 C.S.