



394

1964

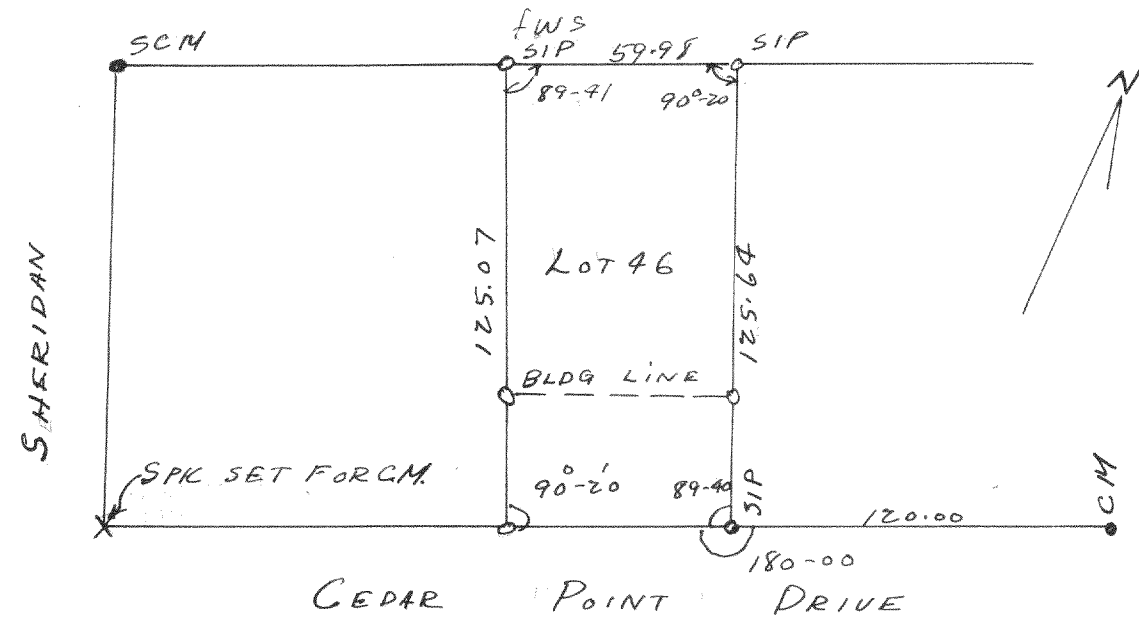


Plot of Survey of Lot 46 Cedar Point Park
 Village of Williams Bay, Walworth County
 1948
 Floyd L. Jensen
 CWT

1965

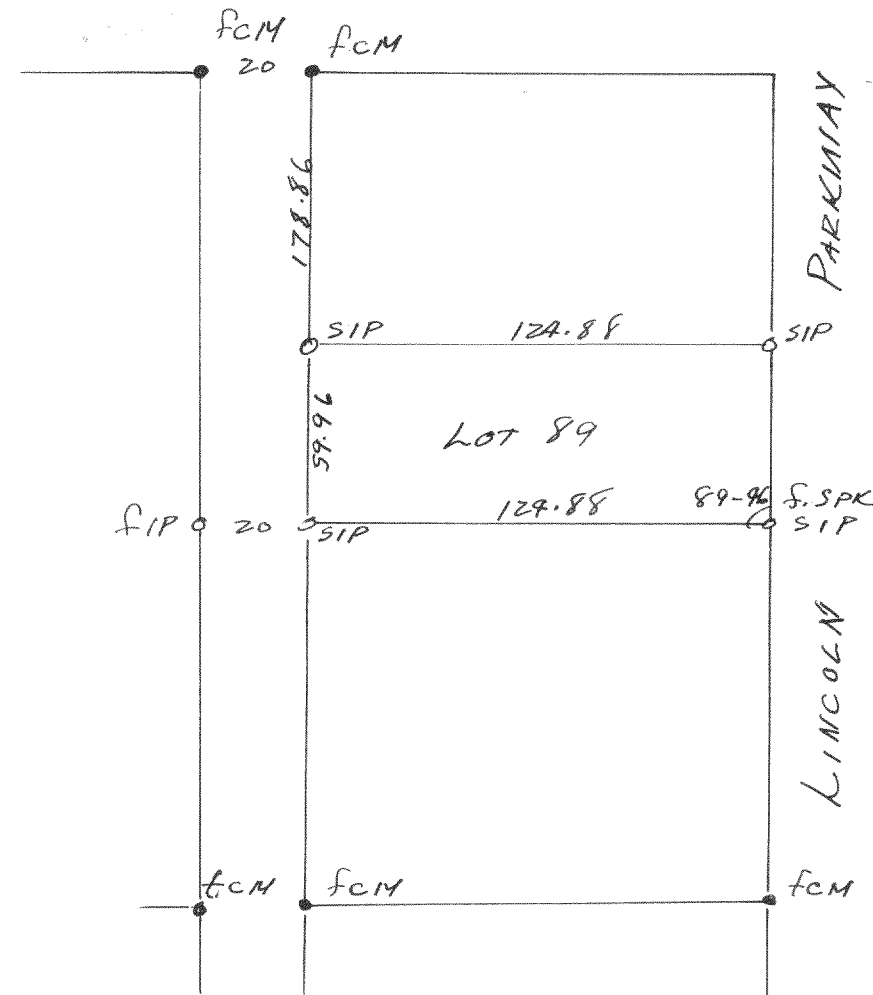


Plot of Survey of Lot 89, Cedar Point Park,
 Village of Williams Bay, Walworth County
 June 1948
 Floyd L. Jensen
 CWT

1966

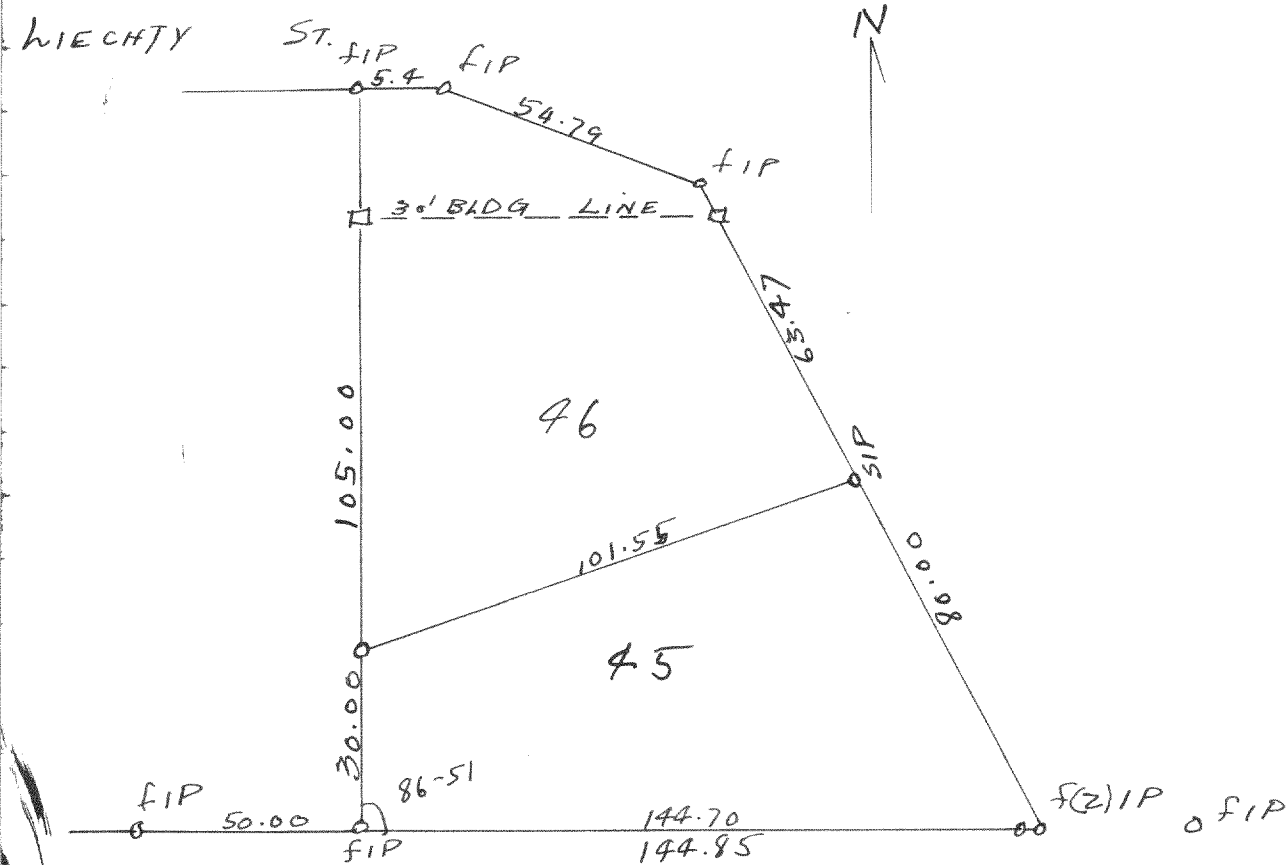

Plot of Survey of Lots 45 & 46 Summer Haven Subd
 Village of Williams Bay, Walworth County
 1948
 Floyd L. Jensen
 CWT

1967

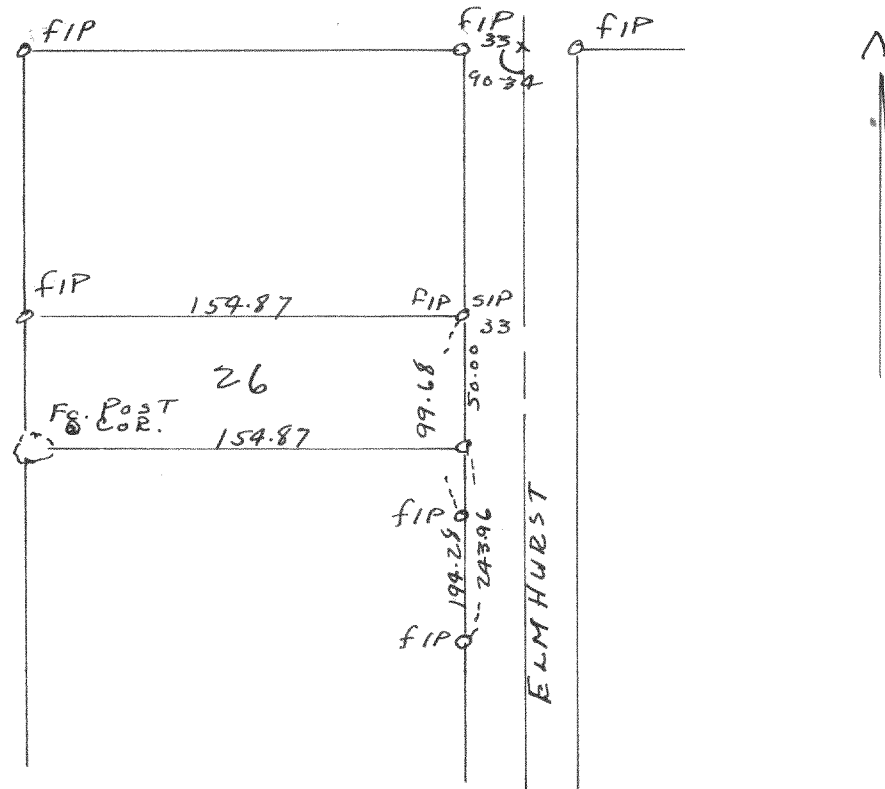

Plot of Survey of Lot 26 Block 1 of Stokes Subdivision
 Village of Williams Bay, Walworth County
 1948
 Floyd L. Jensen
 CWT