



1980

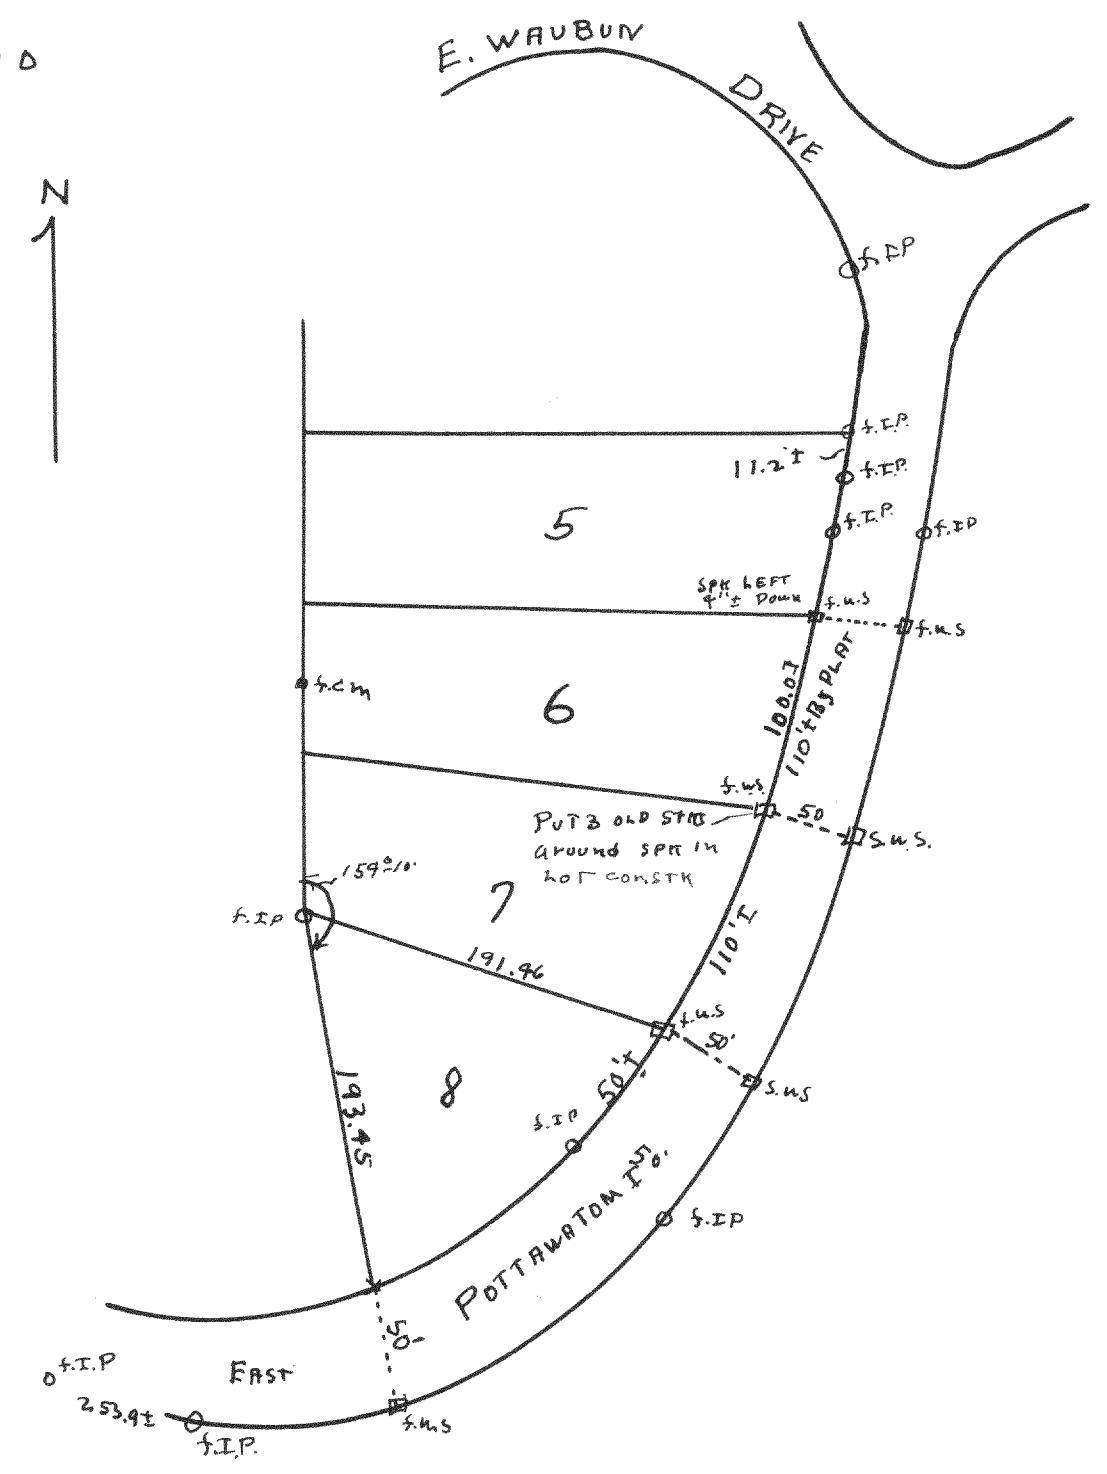

Plot of survey of East Pottawatomie Roadlines
 located in Country Club Estates in the Village of
 Fontana, Walworth County Wisconsin
 May 19, 1978
 Floyd L Jensen
 County Surveyor
 FLS

1981

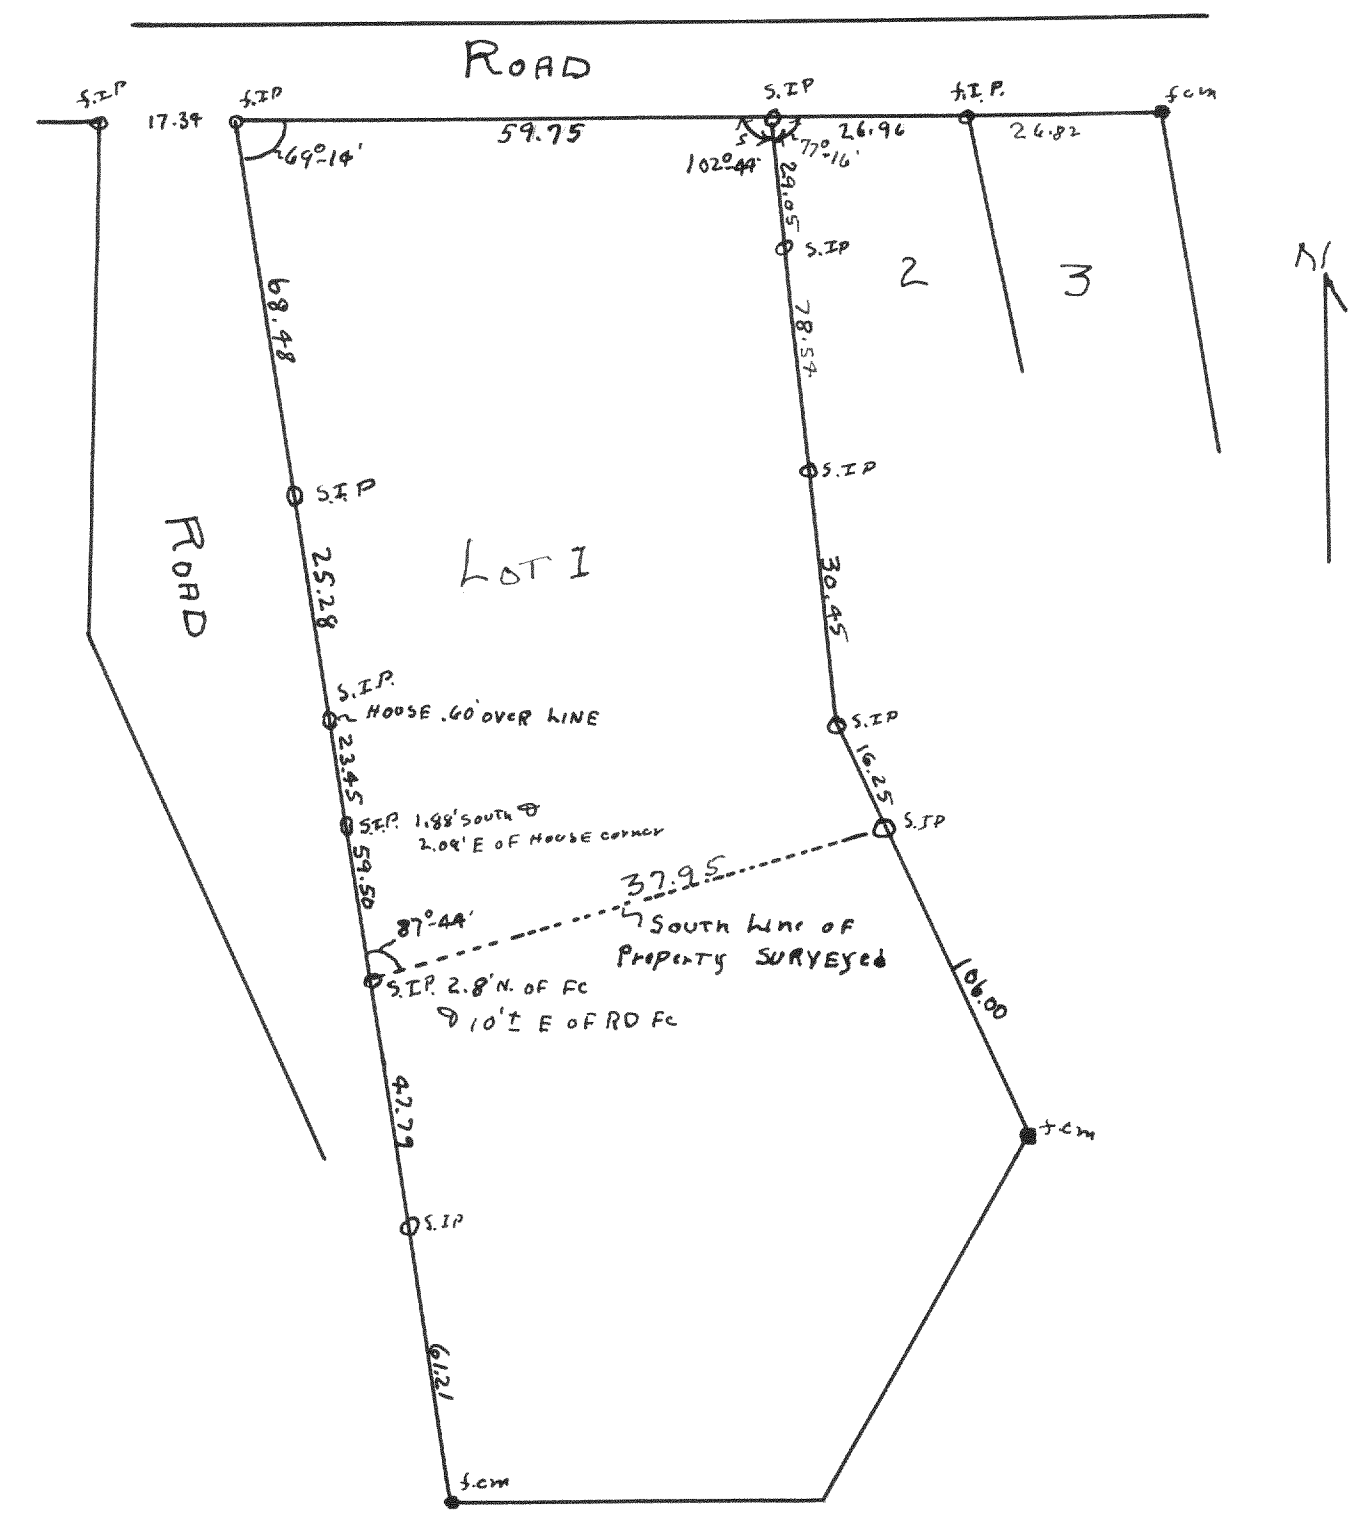

Plot of survey of part of lot 1 of Yellow Point Park Addition
 located in the SE 1/4 of section 29, T2N R16E of Walworth County Wisconsin
 Aug. 24, 1978
 Floyd L Jensen
 County Surveyor
 FLS