



2333

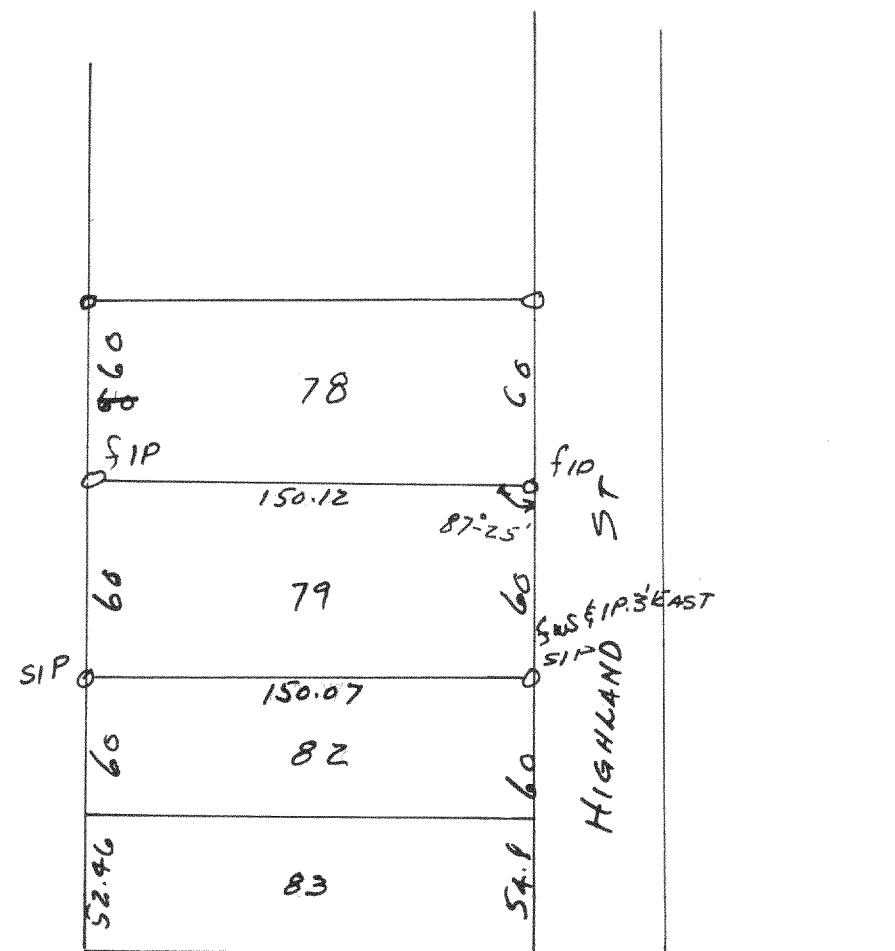


WOOD ST
 Plot of survey of lot 79 of Bay View Subd.
 located in the SE 1/4 of Sec 1 T19 R16 E Village of Williams Bay
 Walworth County, Wis. Lloyd L. Jensen (CWS)
 July 7, 1950 County Surveyor

2334

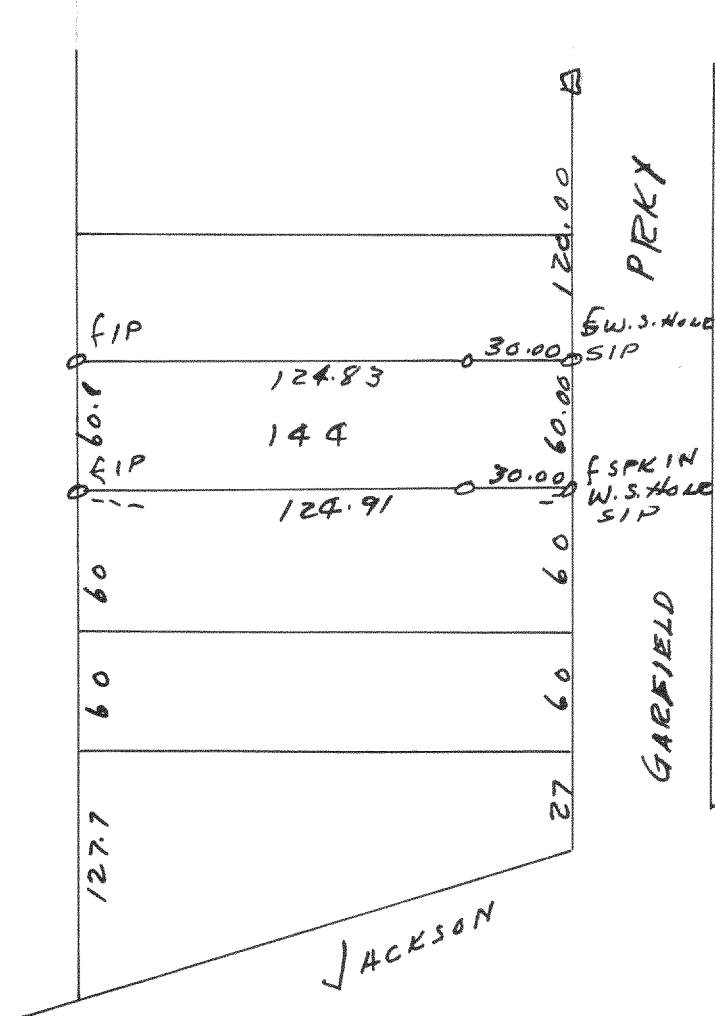


Plot of survey of lot 144 of Cedar Point Park Original Subd
 located in SE 1/4 of Sec 6 T19 R16 E, Village of
 Williams Bay, Walworth County, Wis.
 July 14, 1950 Lloyd L. Jensen (CWS)
 County Surveyor

2335

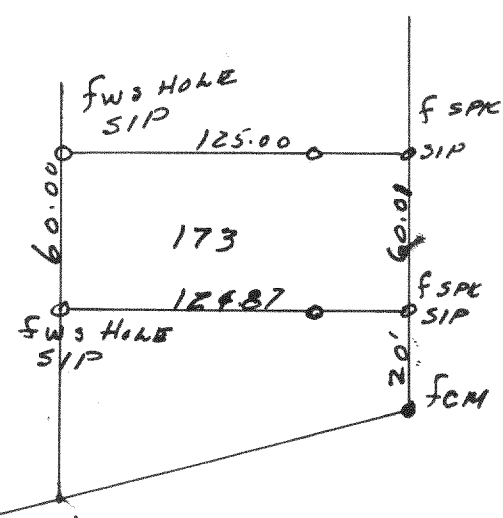

Plot of survey of lot 173 of Cedar Point Park Original Subd
 located in the SE 1/4 of Sec 6 T19 R16 E, Village of Williams Bay
 Walworth County Wis.
 July 31, 1950 Lloyd L. Jensen (CWS)
 County Surveyor

2336

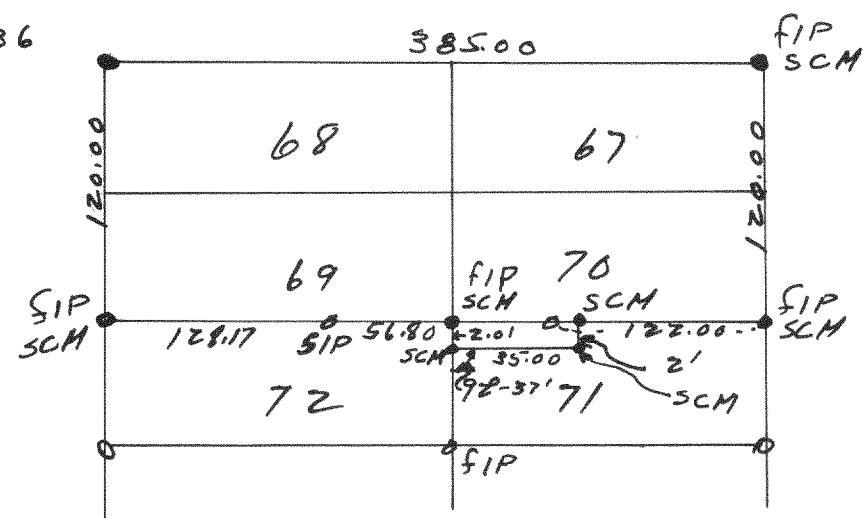

Plot of survey of lots 67, 68, 69, & 70 of Bay View Subd located in the
 SE 1/4 of Sec 1 T19 R16 E Village of Williams Bay, Walworth County, Wis.
 Aug 1, 1950 Lloyd L. Jensen (CWS)
 County Surveyor