


#1428

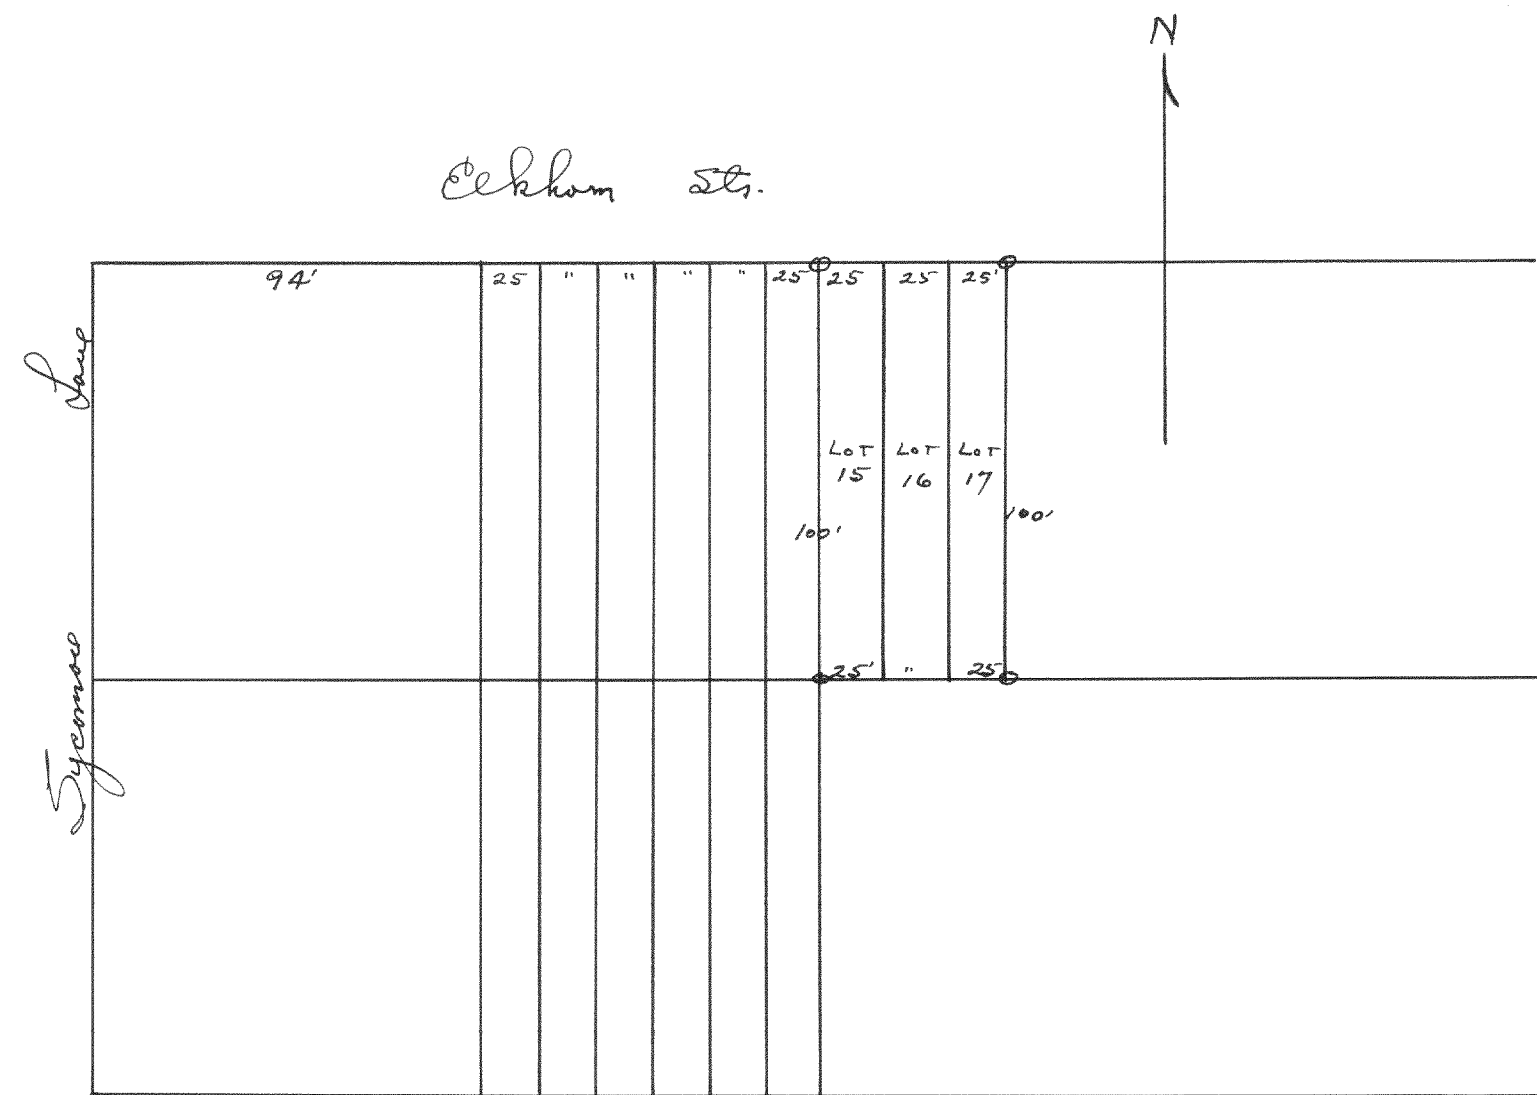


Plat of survey of Lots 15-16 & 17 of Block 87
of Lake Waukegan Subd.

Sept. 1943

Lloyd L. Jensen
County Surveyor

#1429

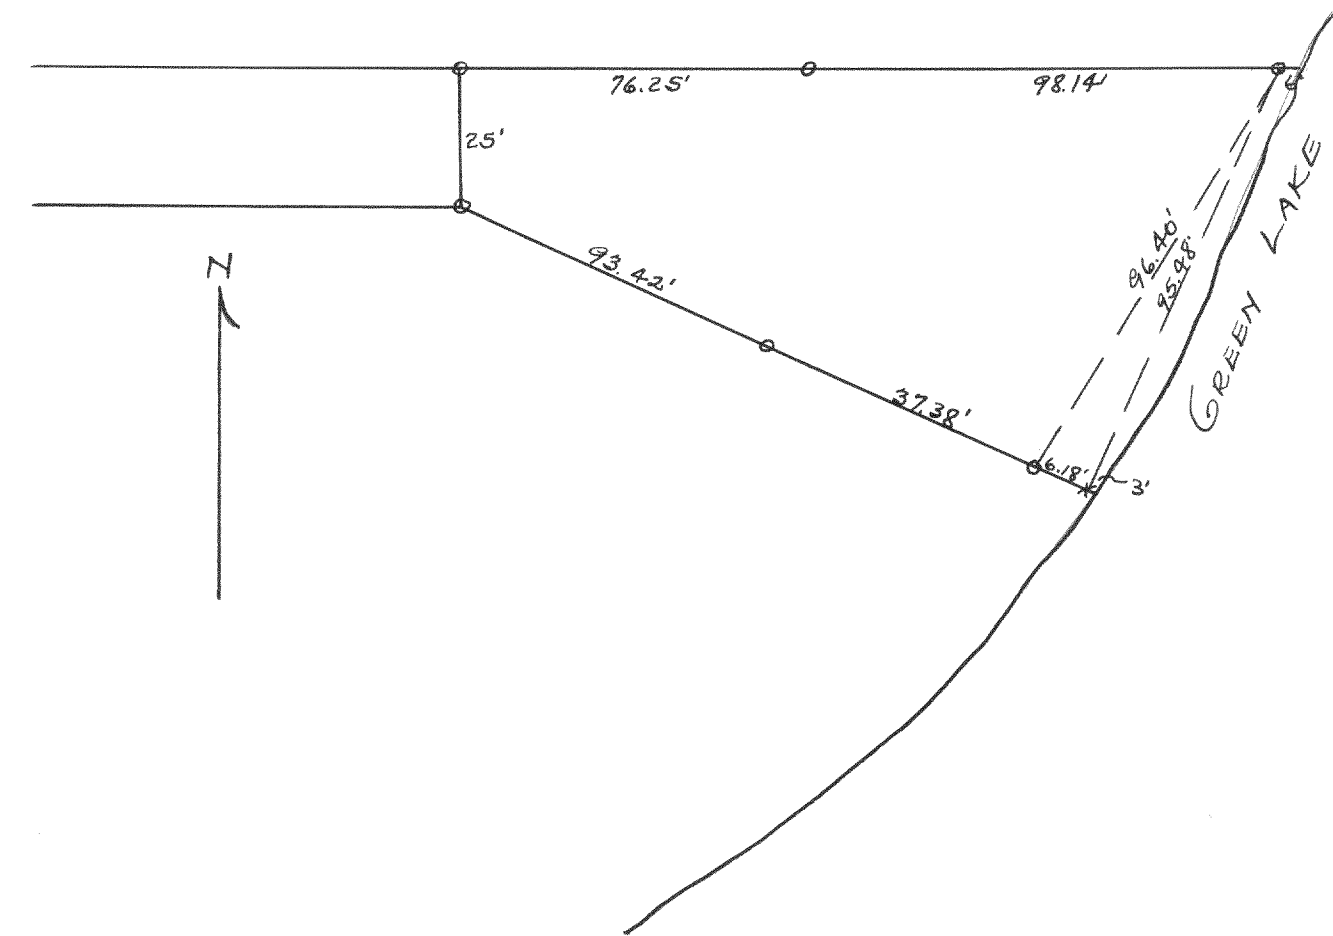

Plat of survey of Lot 1 of Froelich's
Green Lake Park Subd - Section 26,
T4N R16E
Sept. 1943

Lloyd L. Jensen
County Surveyor