


#1433

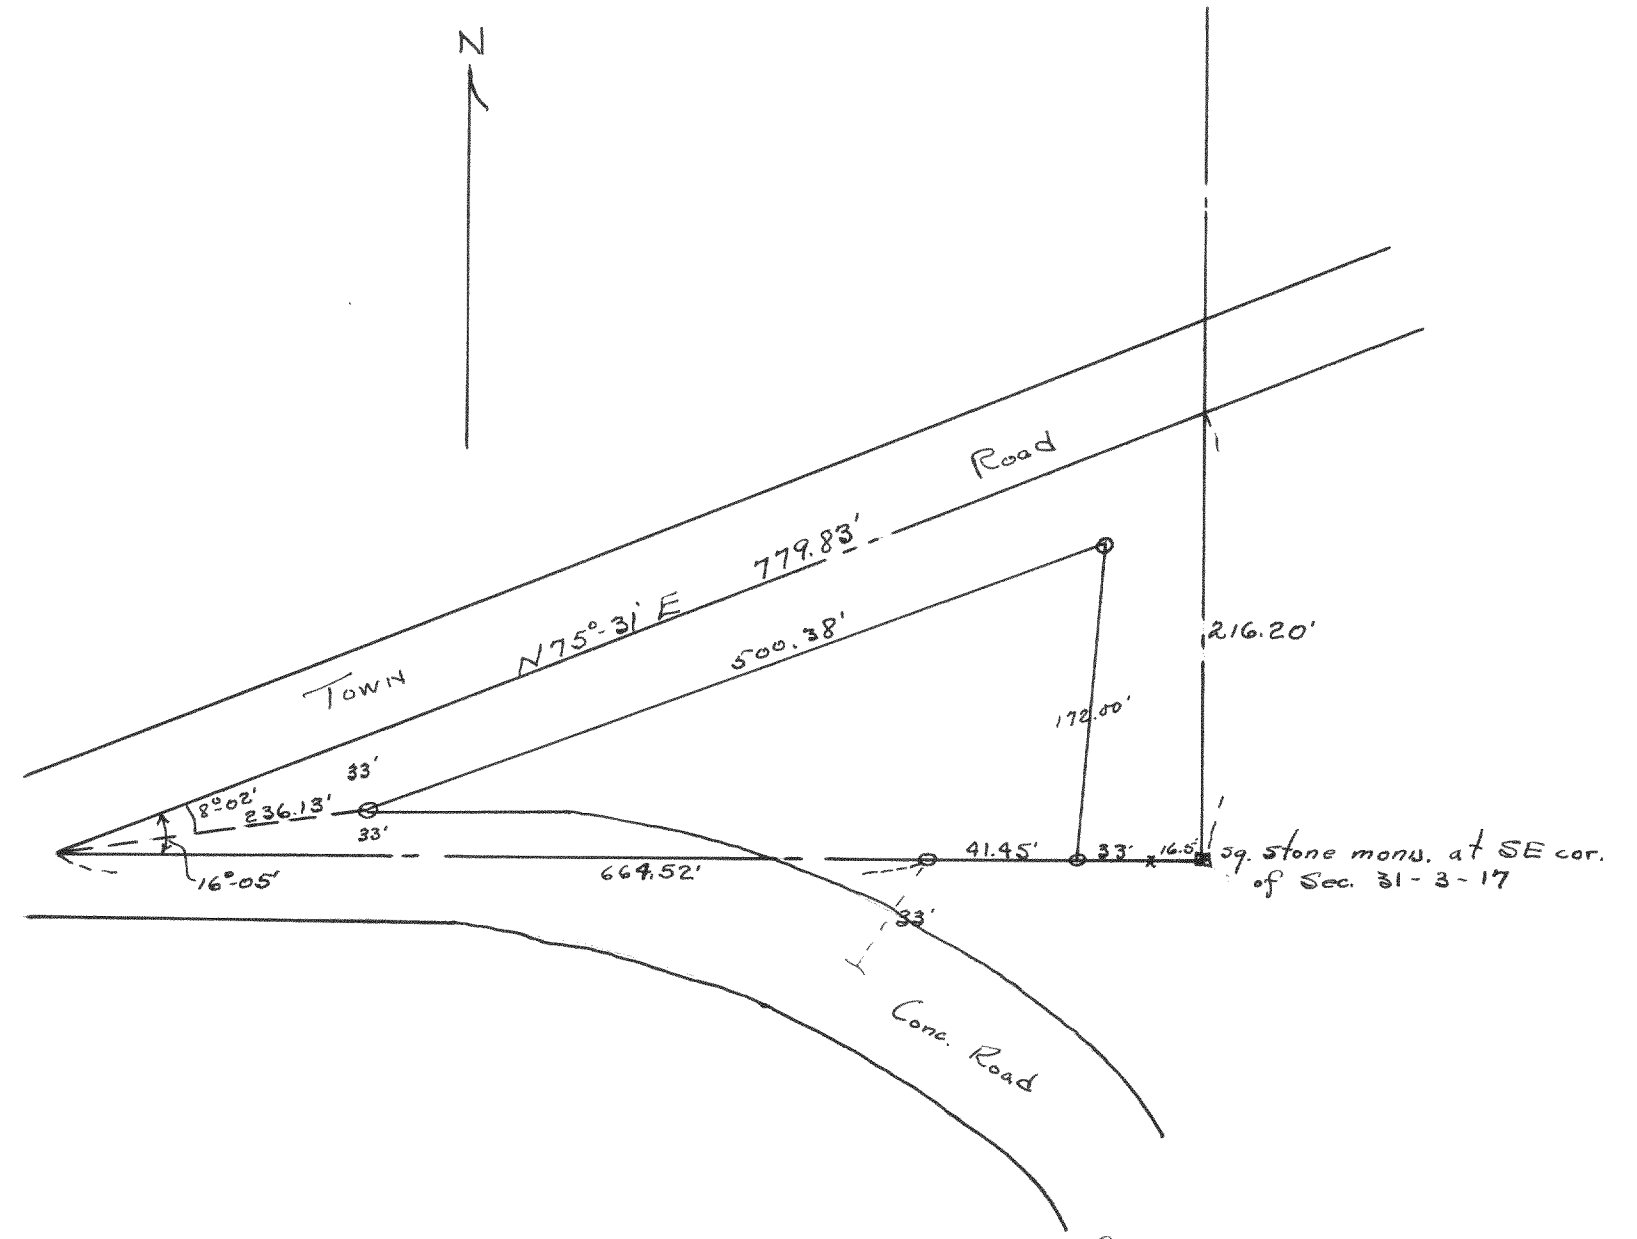


Parcel of land located in the Southeast corner of Sec. 31, T37R17E.

Aug. 1943

Lloyd S. Jensen
County Surveyor.

#1434

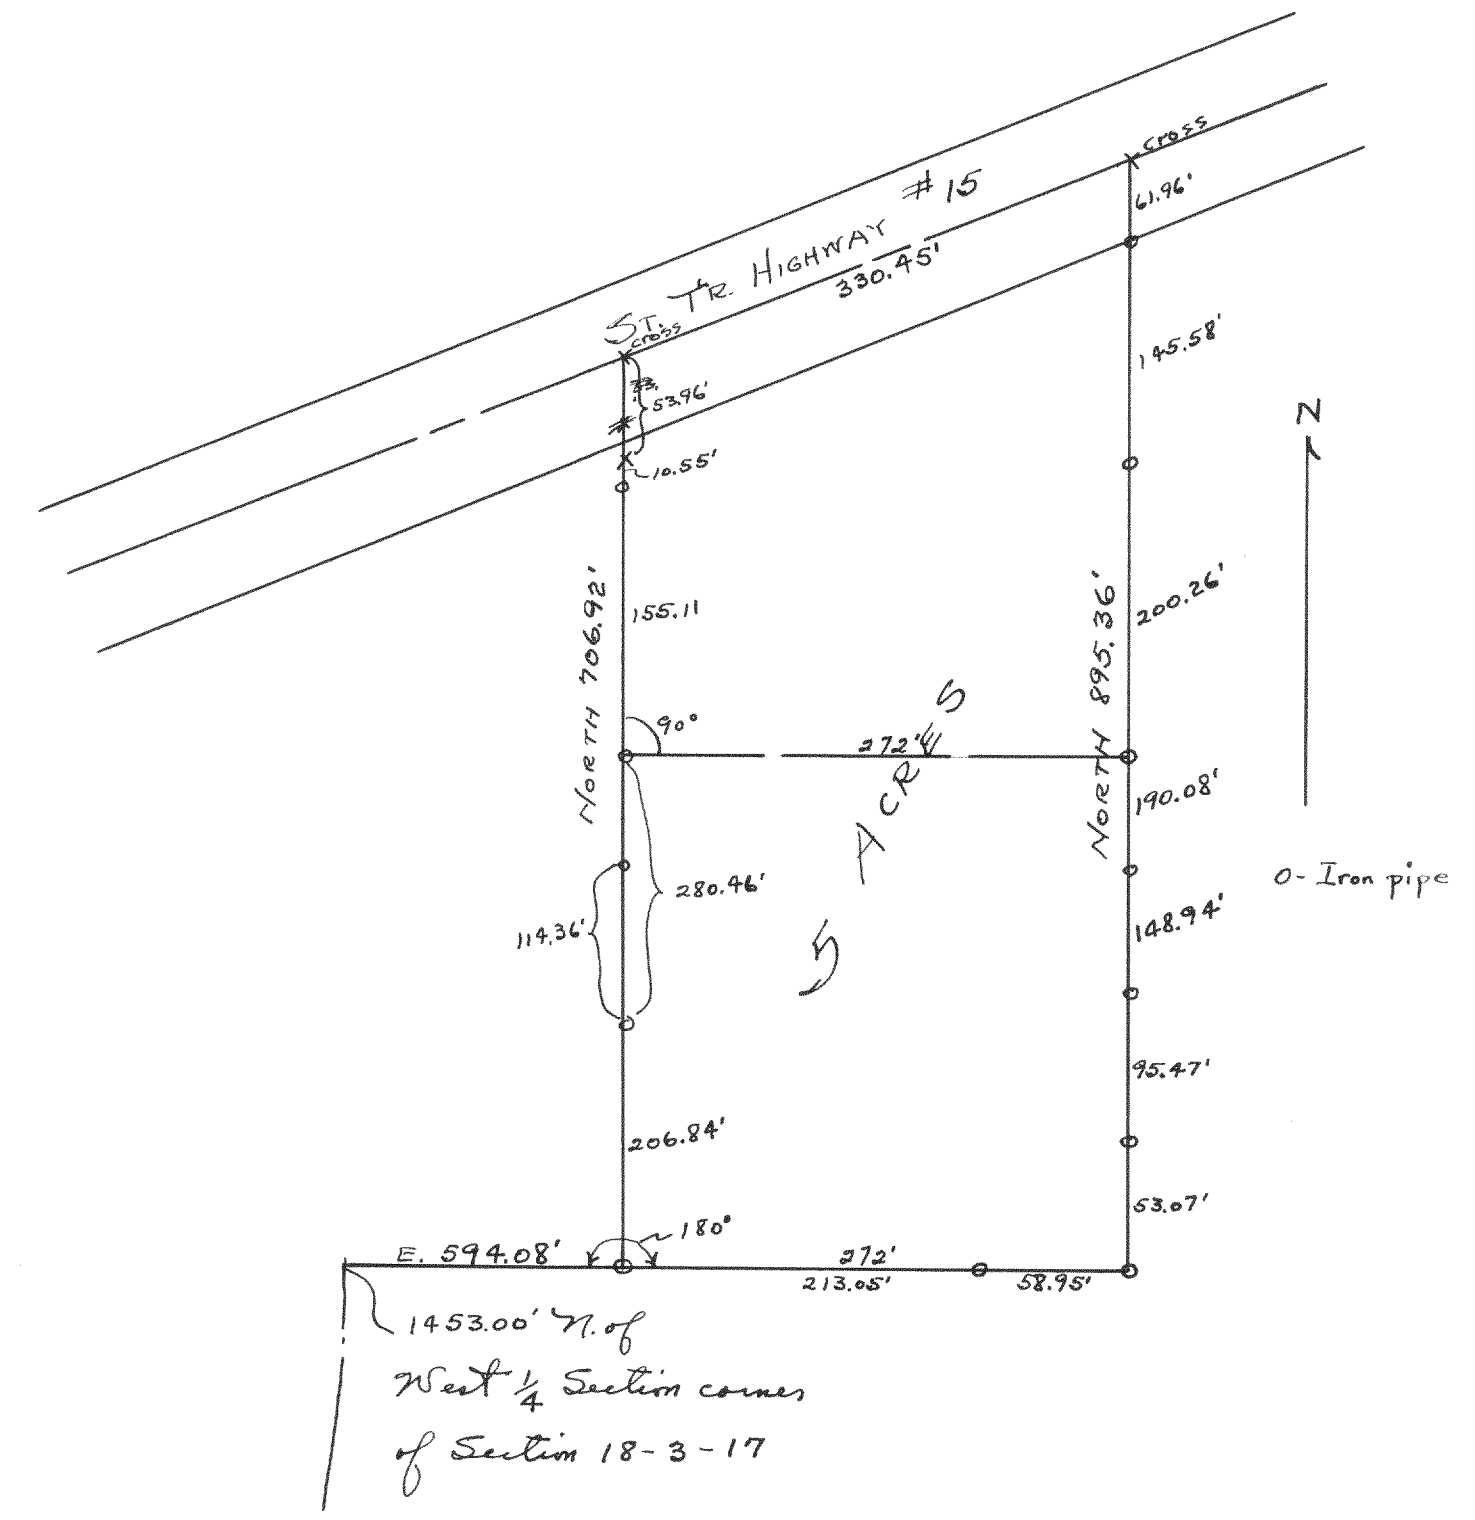

Plot of survey of land located in the Northwest 1/4 of Section 18, T37R17E.

Nov. 1943

Lloyd S. Jensen
County Surveyor.