


#1457

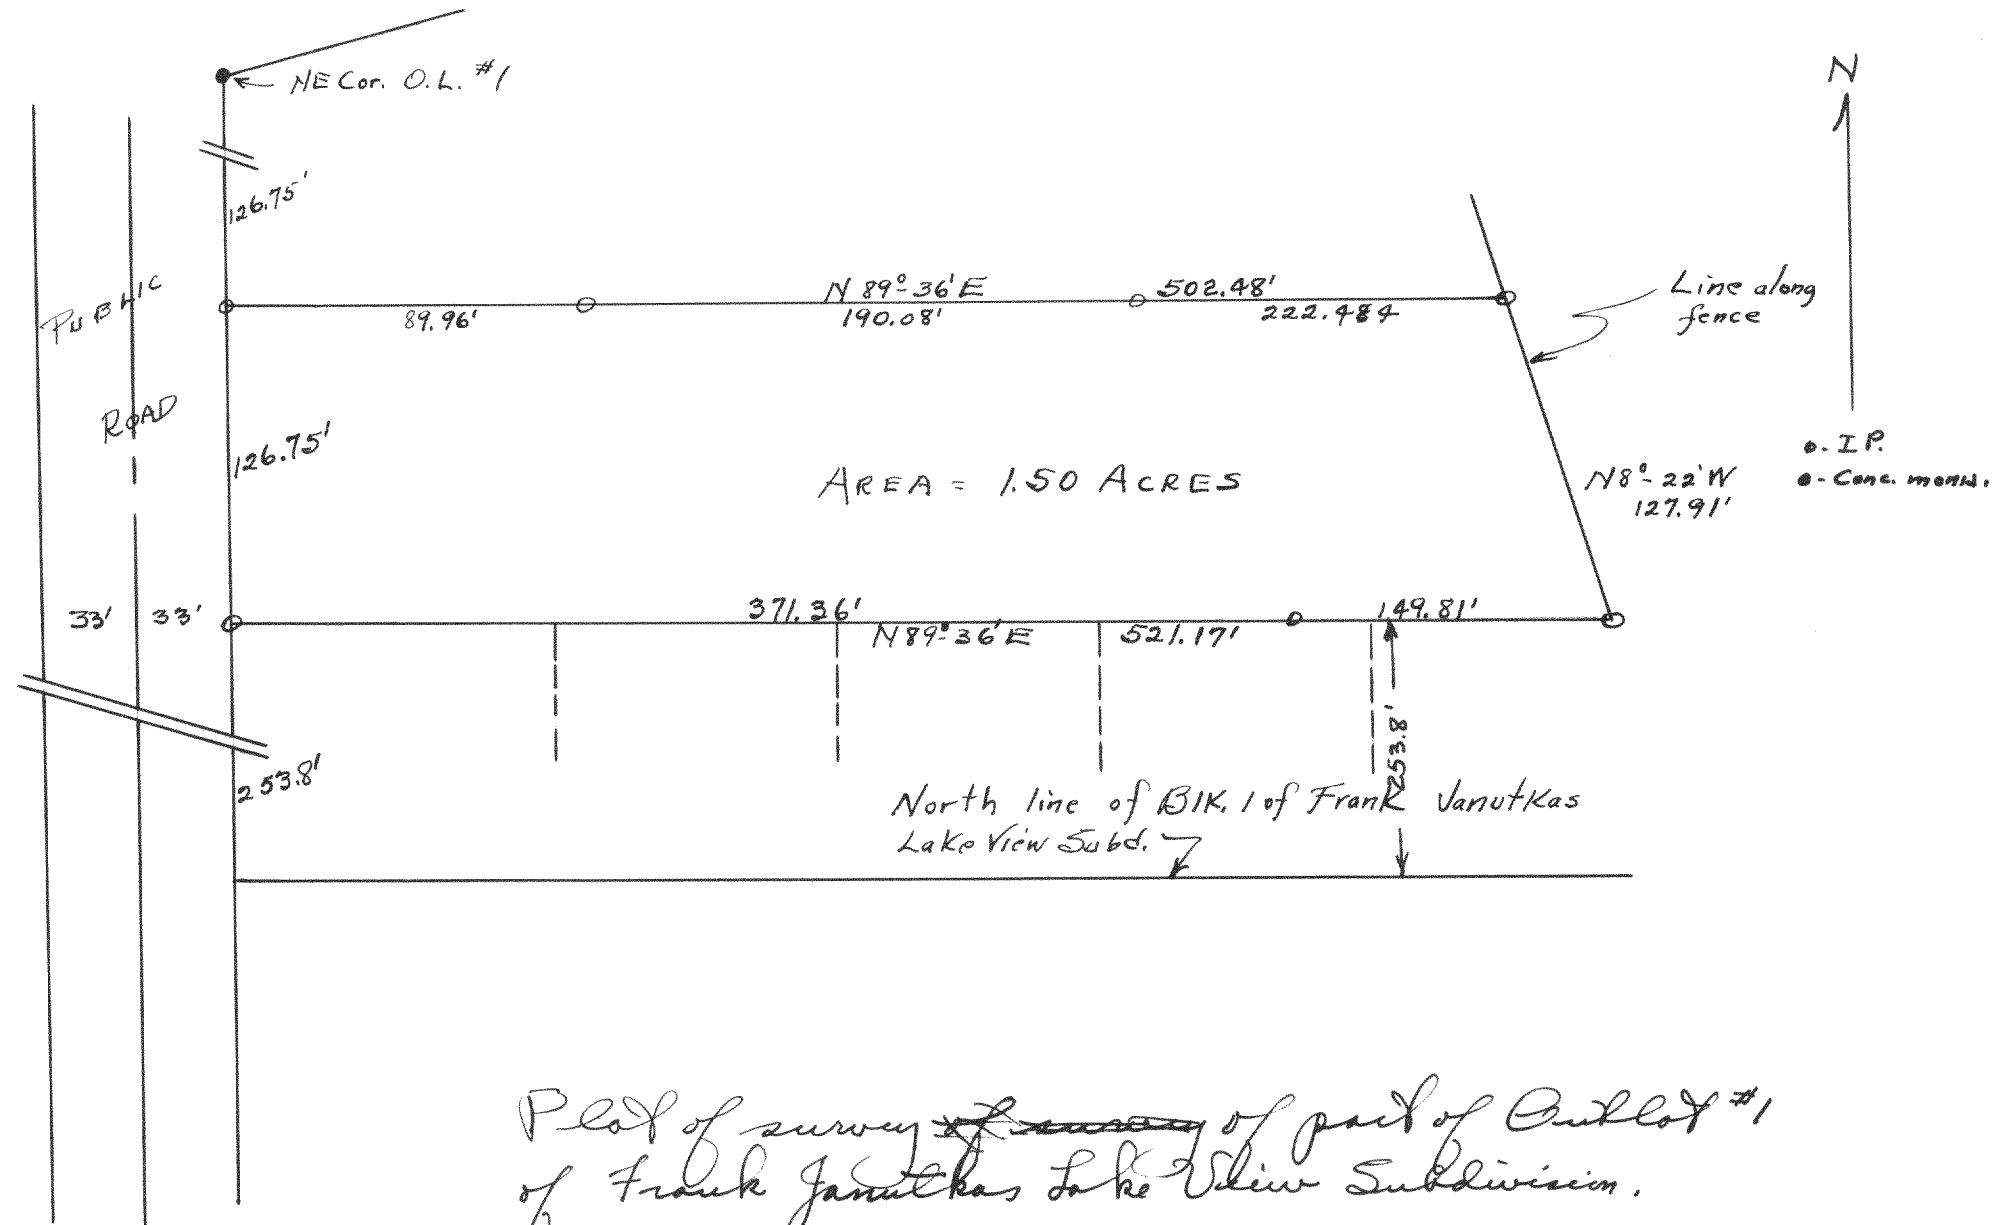


Plot of survey of ~~survey~~ part of Outlet #1
of Frank Janutkas Lake View Subdivision.

Nov. 1944

Lloyd S. Jensen
County Surveyor

#1458

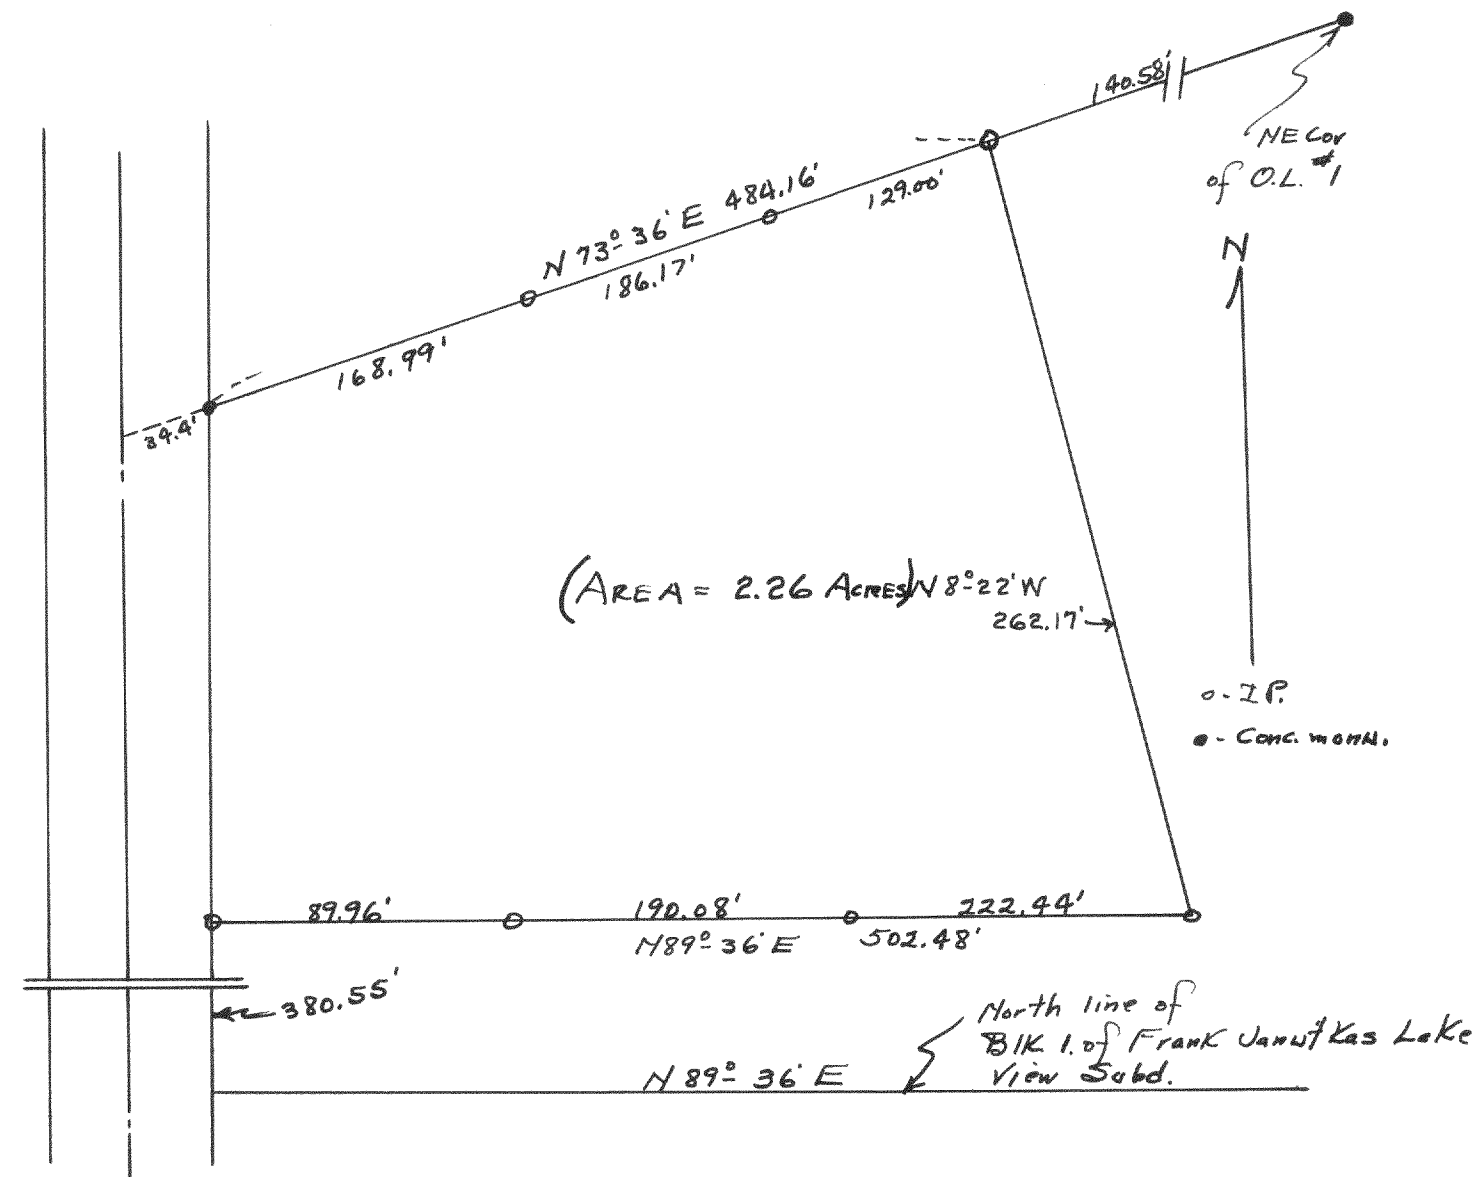

Plot of survey of part of Outlet #1
of Frank Janutkas Lake View Subdivision.

Nov. 1944

Lloyd S. Jensen
County Surveyor