


#1594

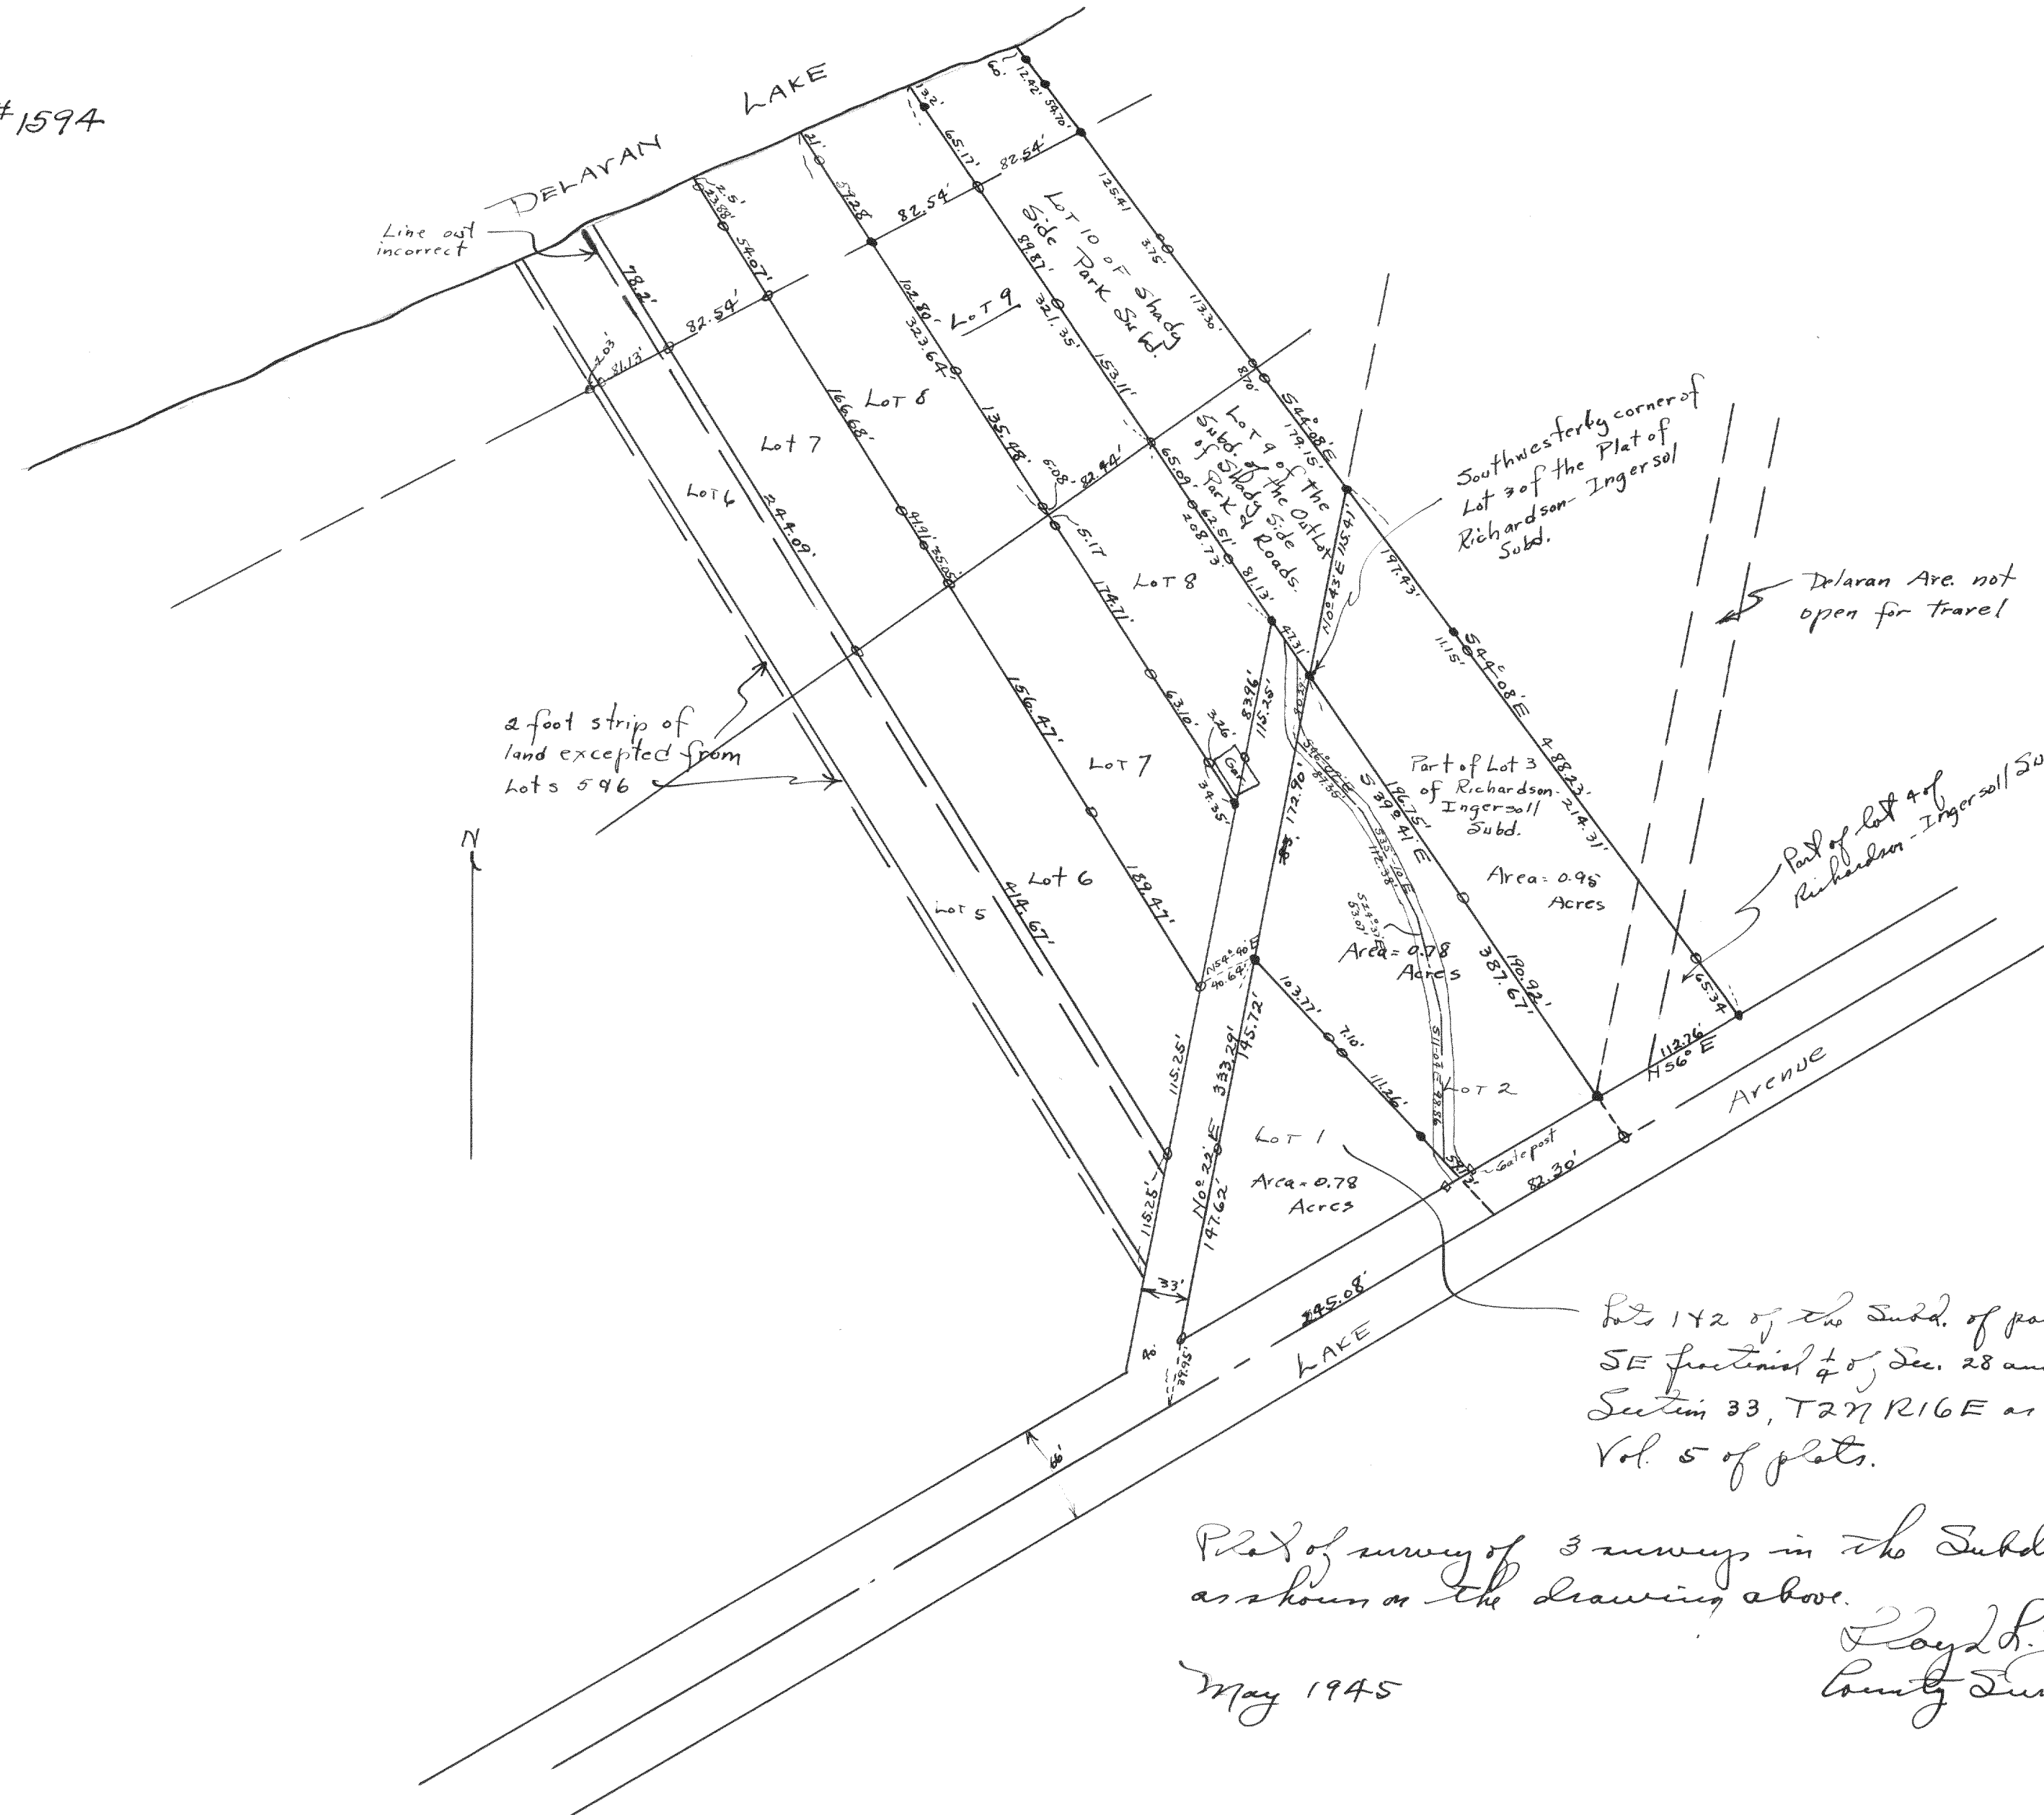

Lots 1 & 2 of the Subd. of part of Plat 14 in "Map of the SE fractional $\frac{1}{4}$ of Sec. 28 and the NE fractional $\frac{1}{4}$ of Section 33, T27N R16E as shown on page 300 of Vol. 5 of plats.

Plat of survey of 3 surveys in the Subdivisions as shown on the drawing above.
 Lloyd S. Jensen
 County Surveyor
 May 1945