


#1595

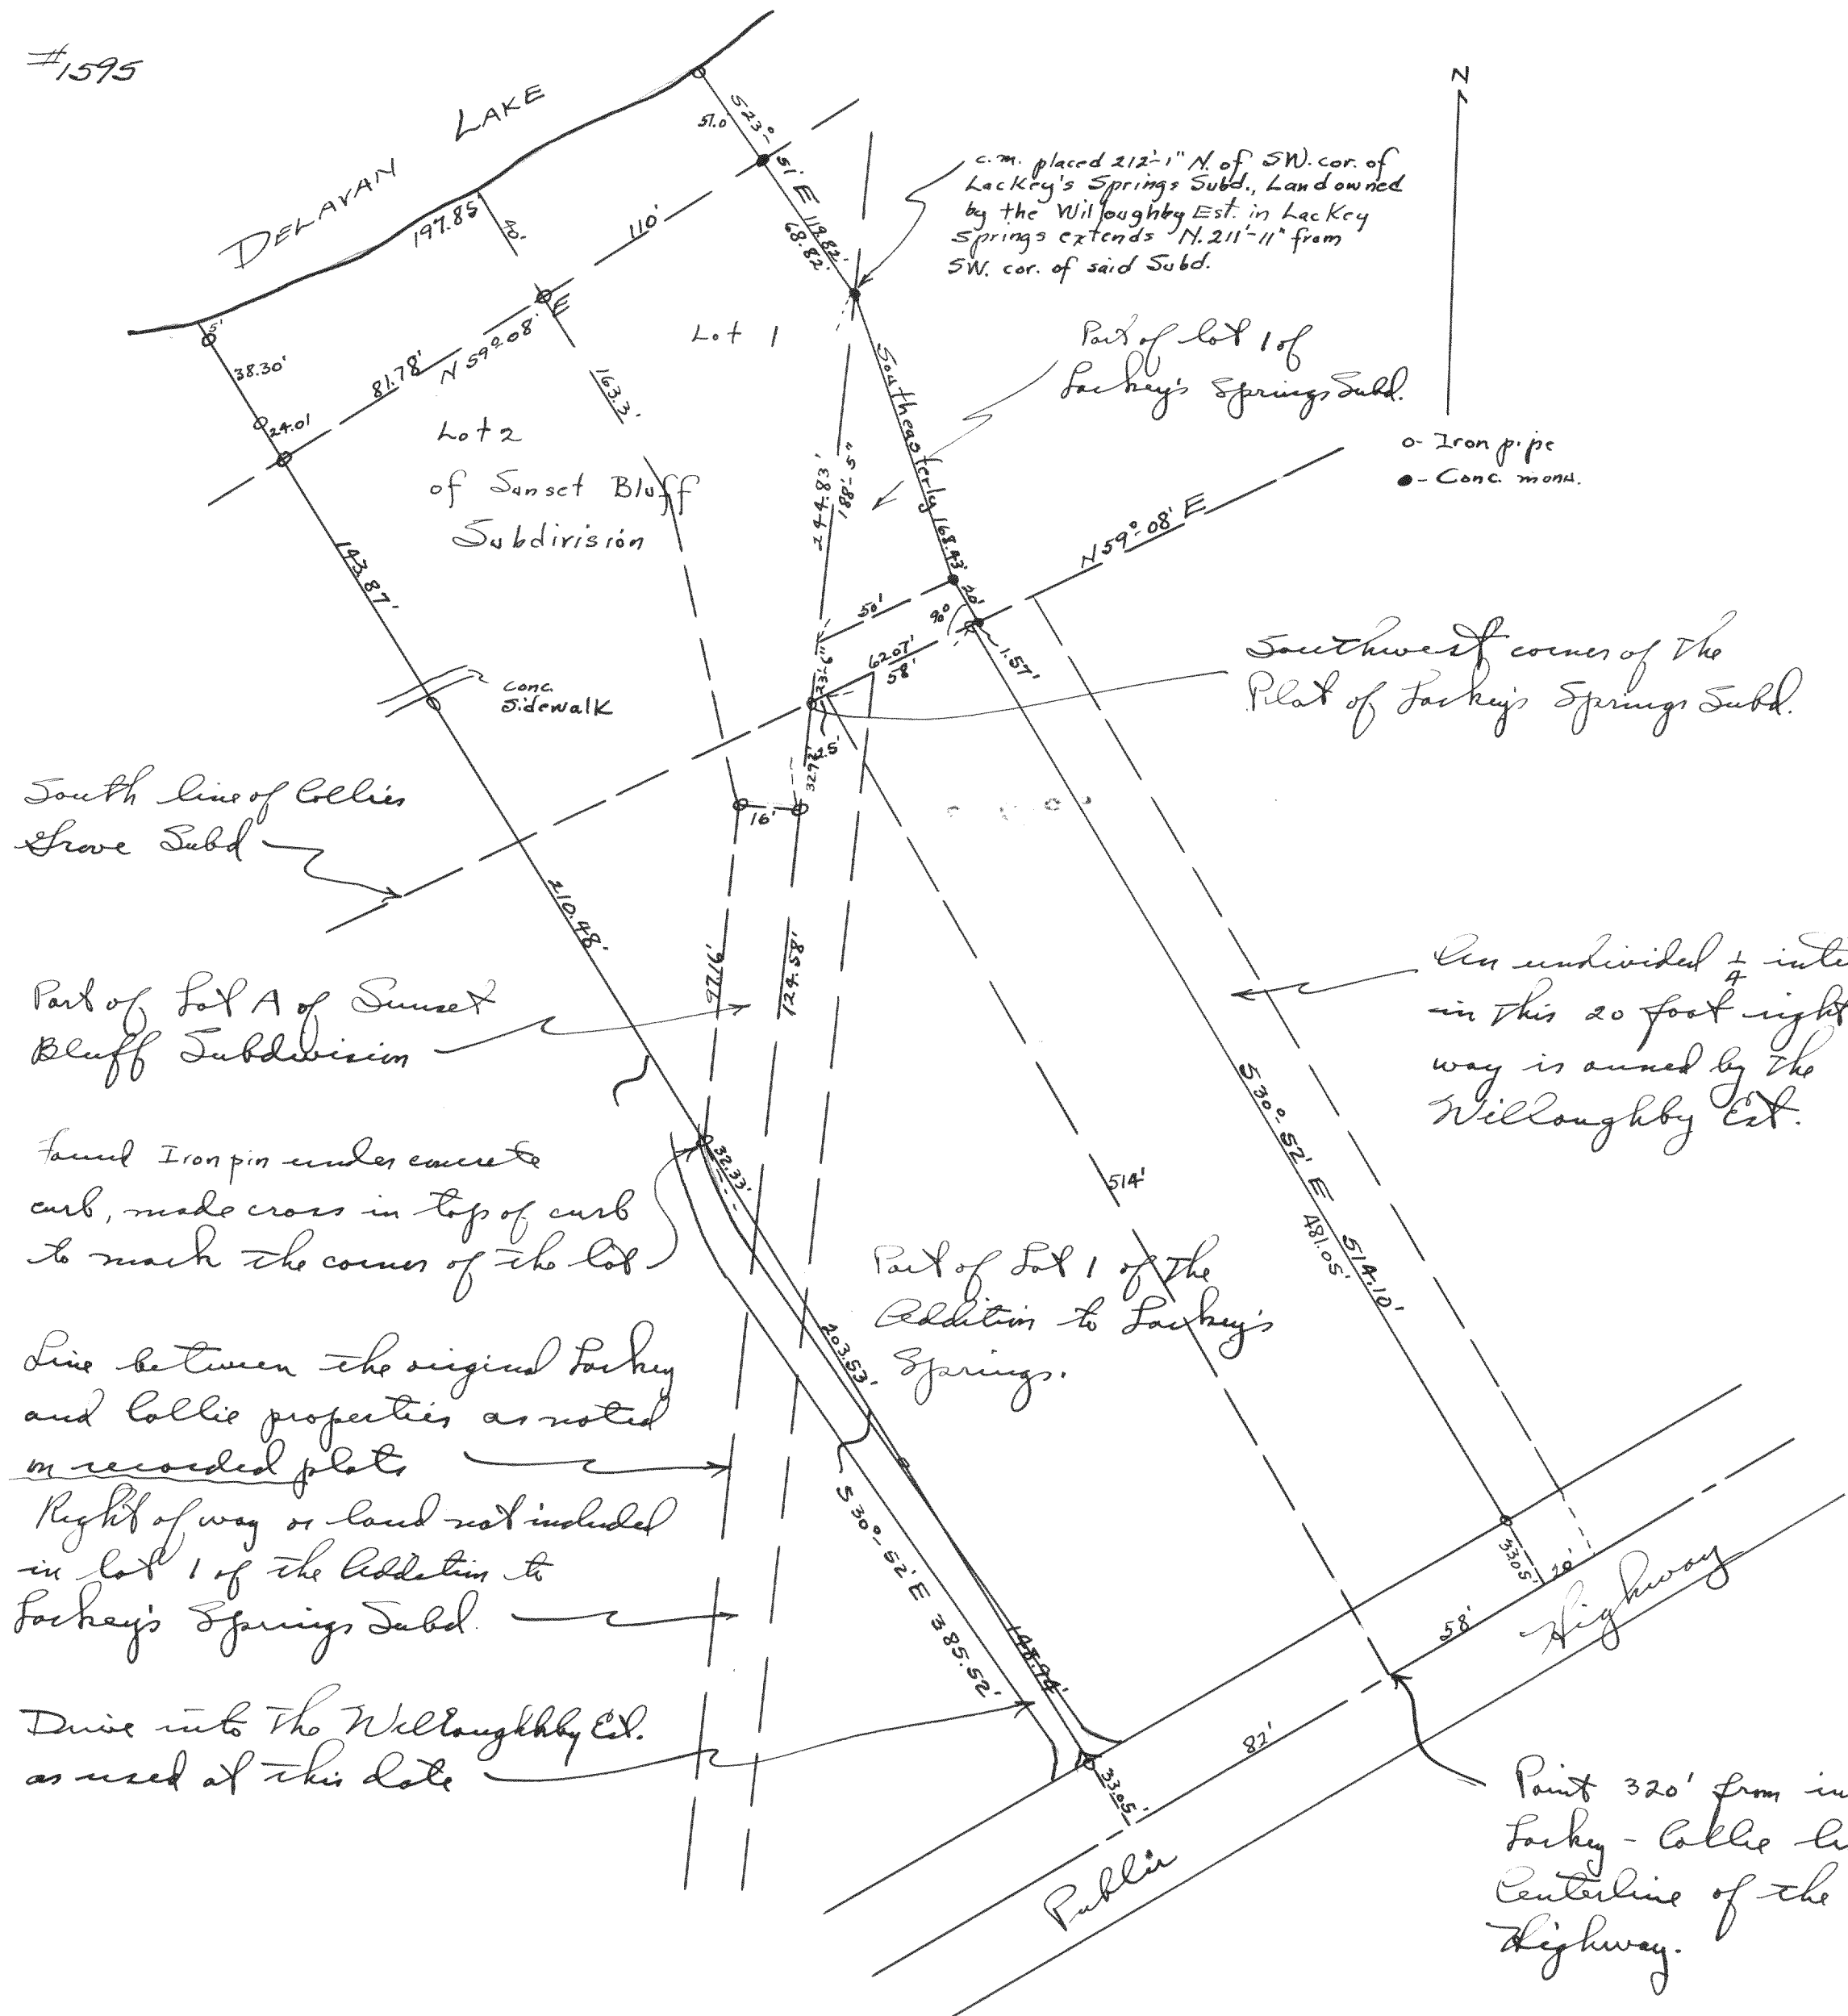

South line of Collier Grove Subd

Part of Lot A of Sunset Bluff Subdivision

Found Iron pin under concrete curb, made cross in top of curb to mark the corner of the lot

Line between the original Lachey and Collier properties as noted on recorded plat

Right of way or land not included in lot 1 of the addition to Lachey's Springs Subd.

Drive into the Wiloughby Est. as used at this date

Part of Lot 1 of the Addition to Lachey's Springs.

Public Highway

Point 320' from intersection of the Lachey - Collier line and the Centerline of the Public Highway.

Southwest corner of the Plat of Lachey's Springs Subd.

An undivided 1/4 interest in this 20 foot right of way is owned by the Wiloughby Est.

corn. placed 212'-1" N. of SW. cor. of Lachey's Springs Subd., Land owned by the Wiloughby Est. in Lachey Springs extends N. 211'-11" from SW. cor. of said Subd.

Part of lot 1 of Lachey's Springs Subd.

o - Iron pipe  
• - Conc. monu.



Plat of survey of the Wiloughby Estate, located in the northwest 1/4 of fractional Section 33, T27N R16E of Walworth County Wisconsin.  
8-3-45

Lloyd S. Jensen  
County Surveyor