


Plot of Survey of Lots 5020 to 5024 in Section 3
of Bell Lake Subdivisions, Walworth County, Wisconsin
Lloyd L. Jensen
County Surveyor
Aug. 1946
G.T.D

#1616

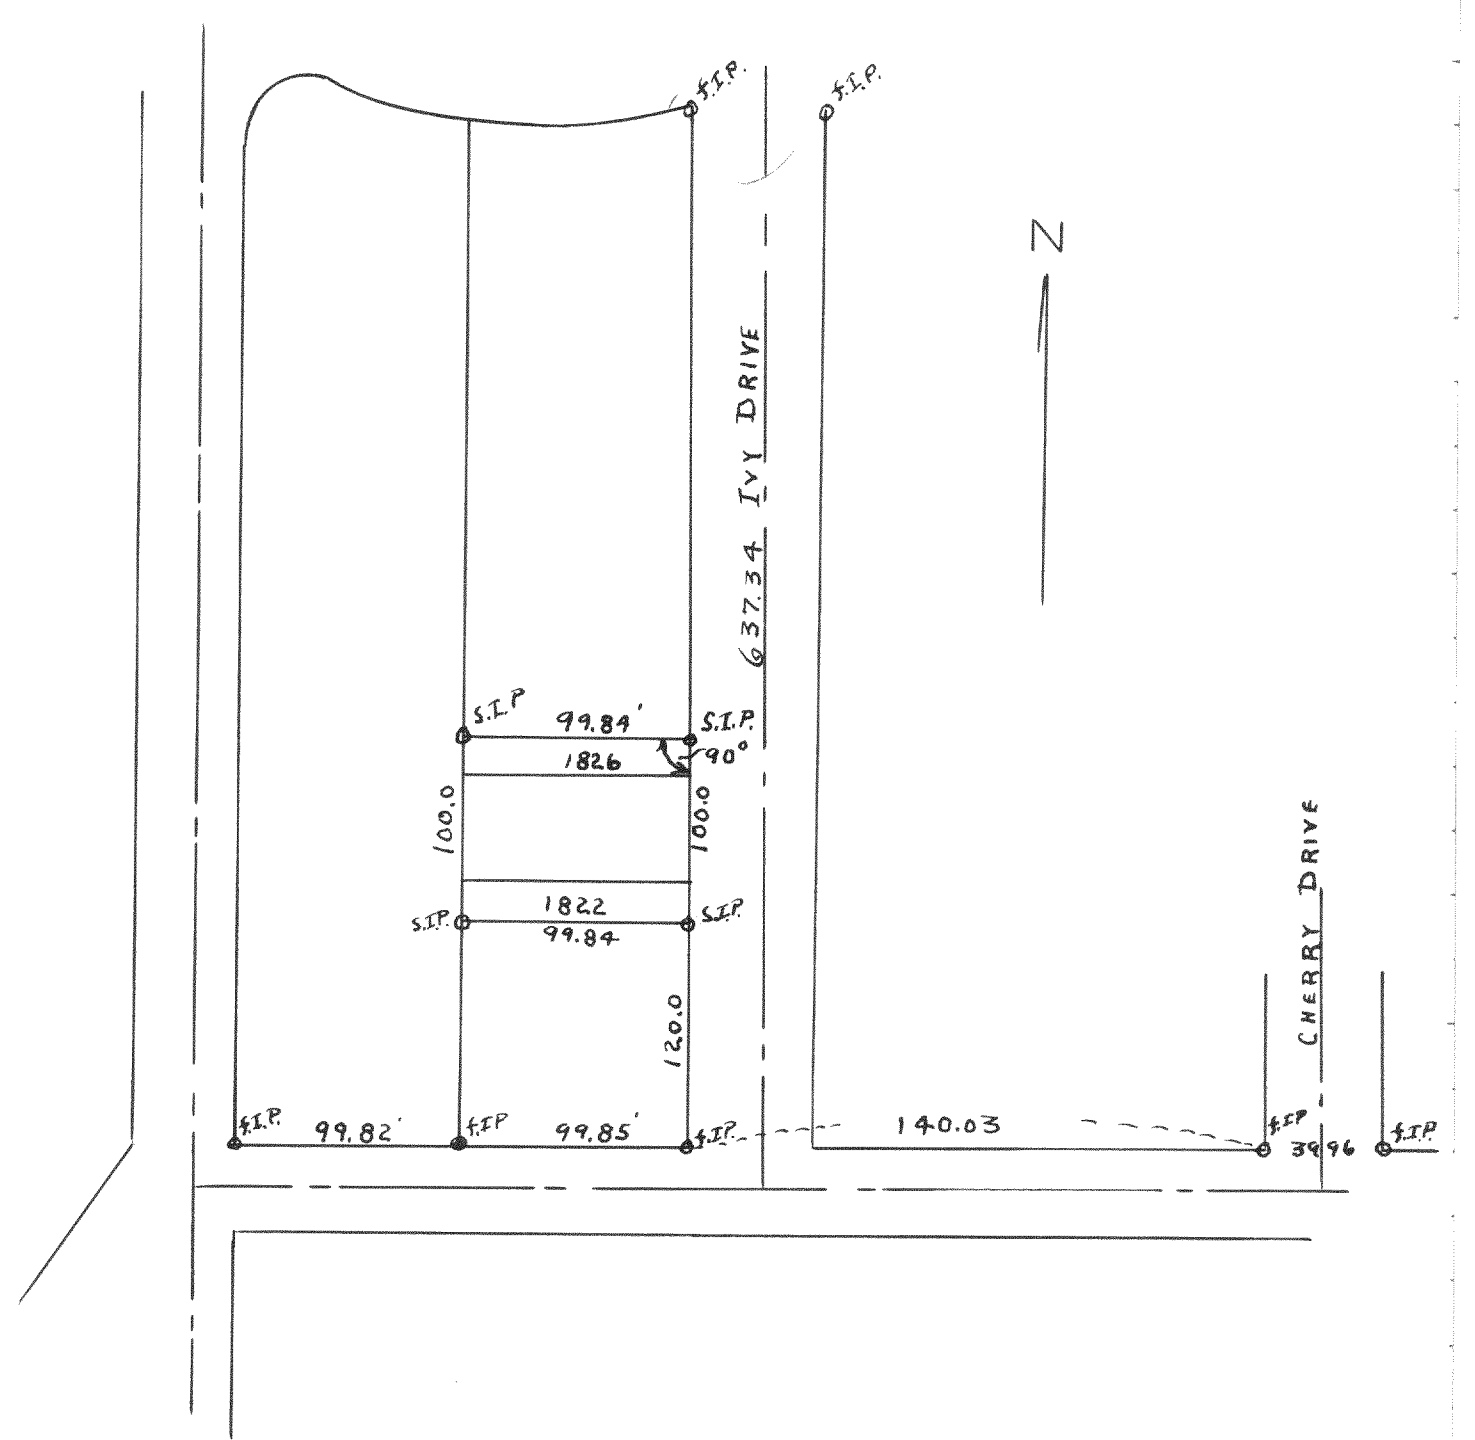

Plot of Survey of Lots 1822 to 1826 in Section I
of Bell Lake Subdivisions in Walworth County, Wis.
Lloyd L. Jensen
County Surveyor
Aug. 1946