



1721

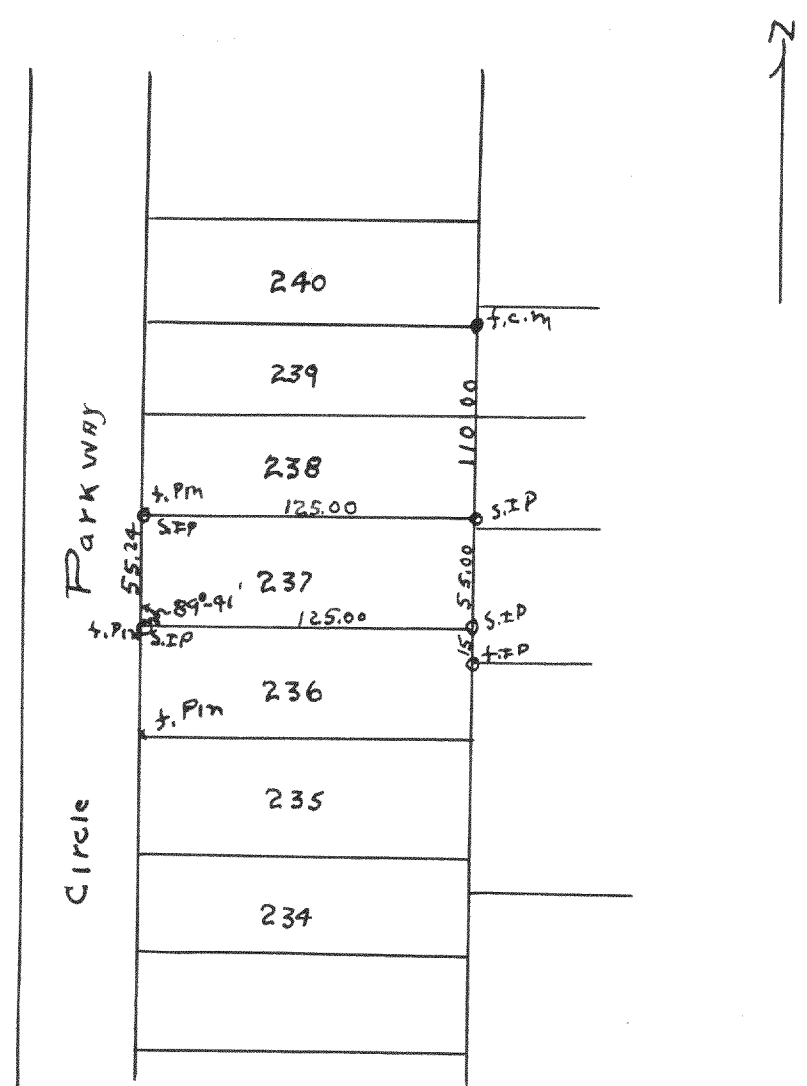

Plat of survey of lot 237 in Cedar Point Park 3rd Addition in Village of Williams Bay, Walworth County, Wisconsin
 Nov. 3, 1947

Lloyd L Jensen
 County Surveyor

1722

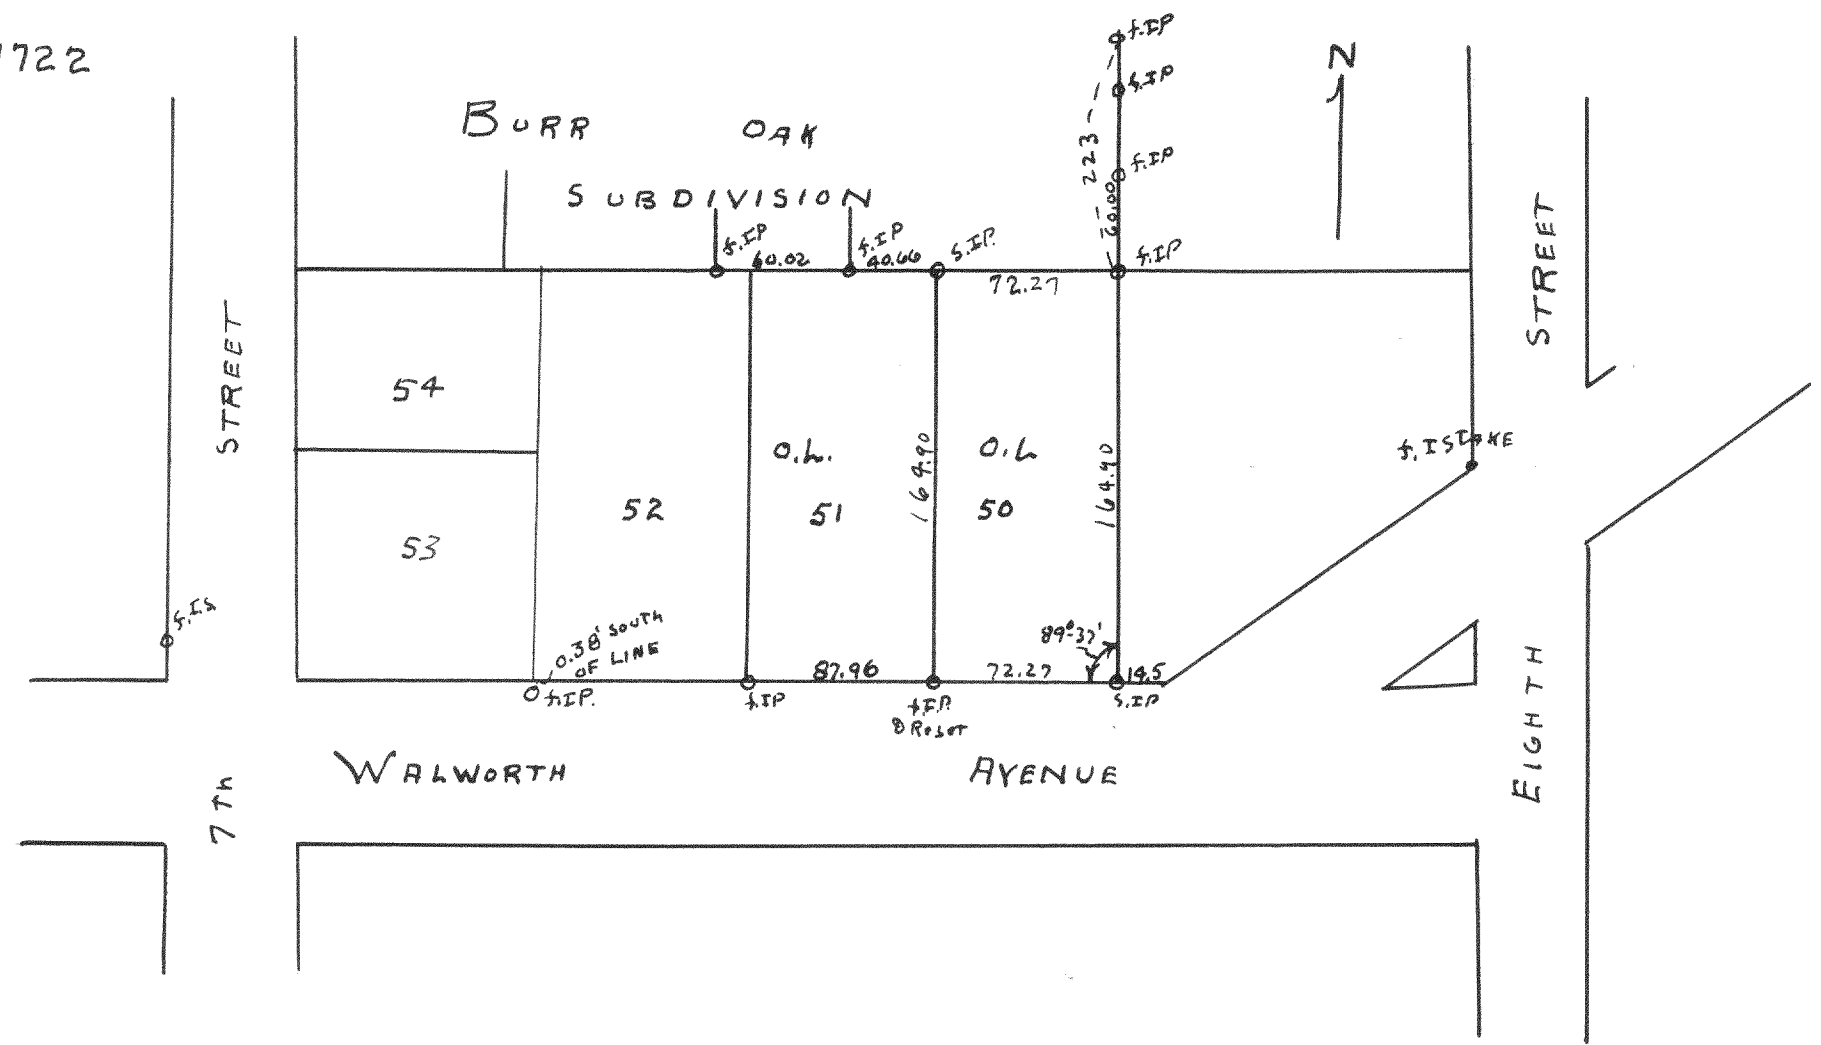

Plat of survey of O.L. 50 of assessors Plat City of Bellevue Walworth County Wisconsin

1947

Lloyd L Jensen
 County Surveyor