


SURVEY 1235

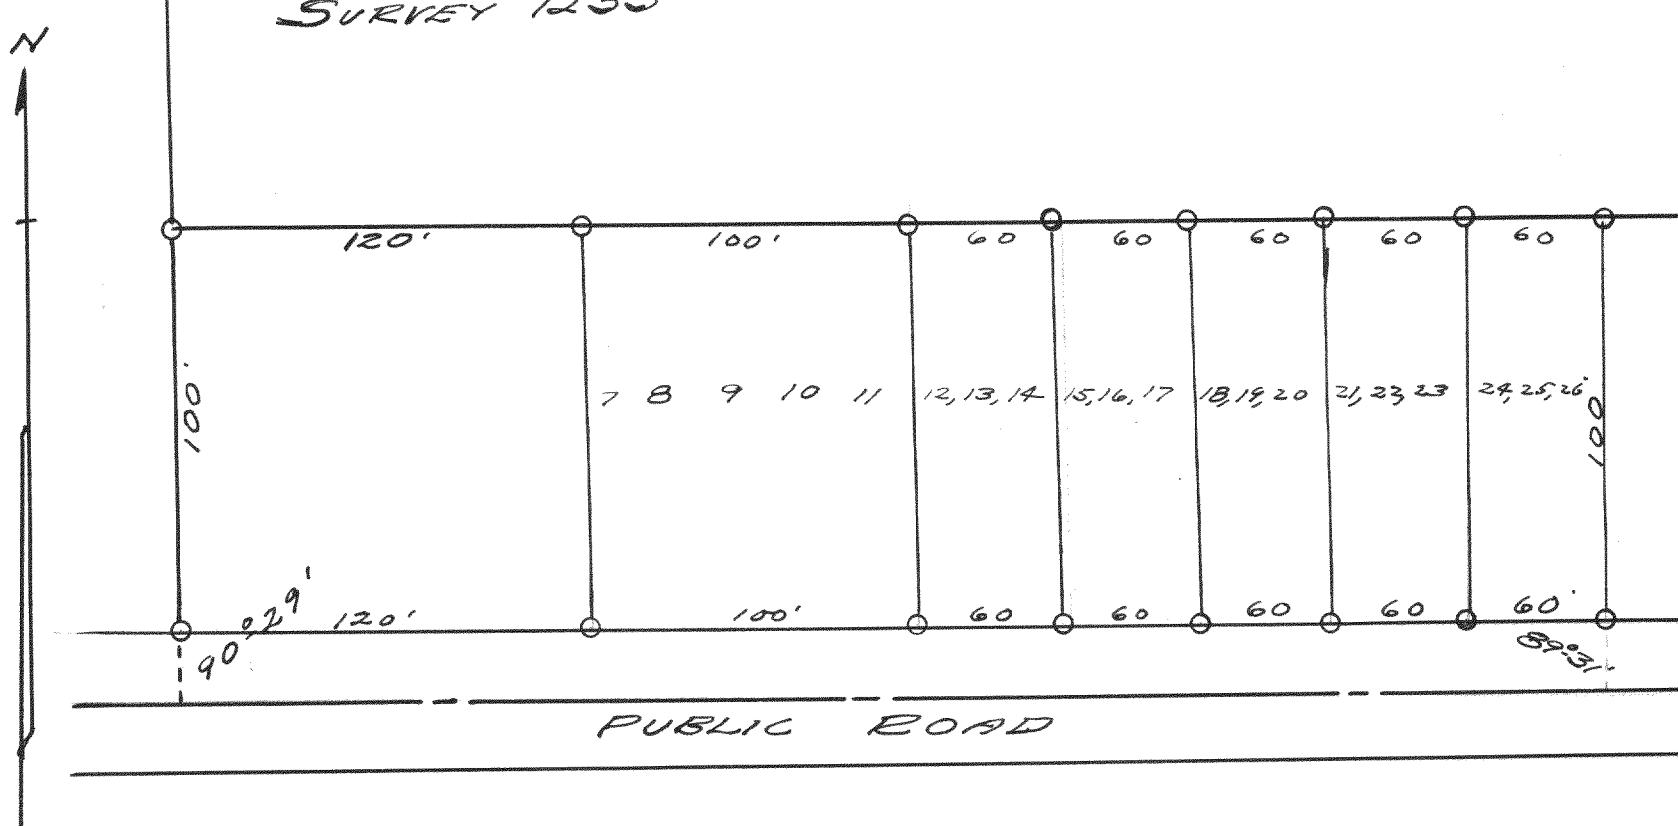


PLAT OF SURVEY OF LOTS 7 TO 26 INC. OF PELL FARM

ANNEX

AUG. 1941

Lloyd L. Jensen
K.E.J.

SURVEY NO. 1236

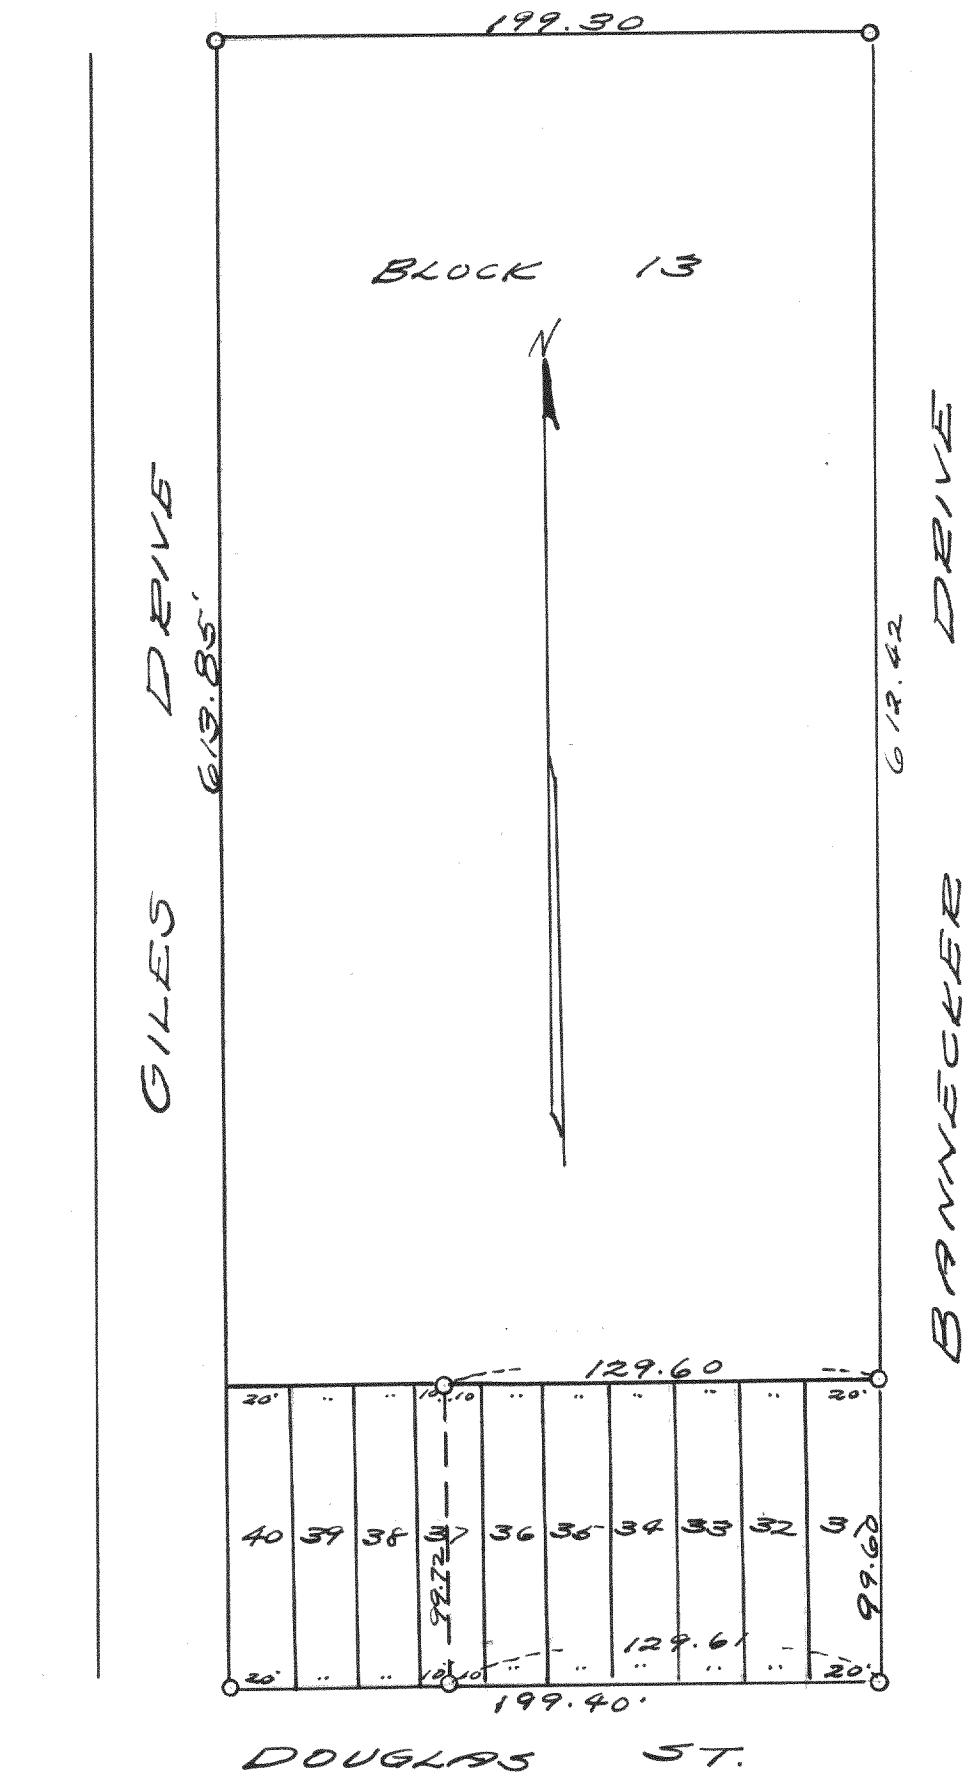PLAT OF SURVEY OF LOTS 31 TO 36 OF
BLOCK 13, OF LAKE VERNON SUBD.,
WALWORTH COUNTY, WISCONSIN.

APRIL, 1941

Lloyd L. Jensen
K.E.J.