


# 1785

W 1/4 SECTION CORNER  
OF SECTION 27-2-15

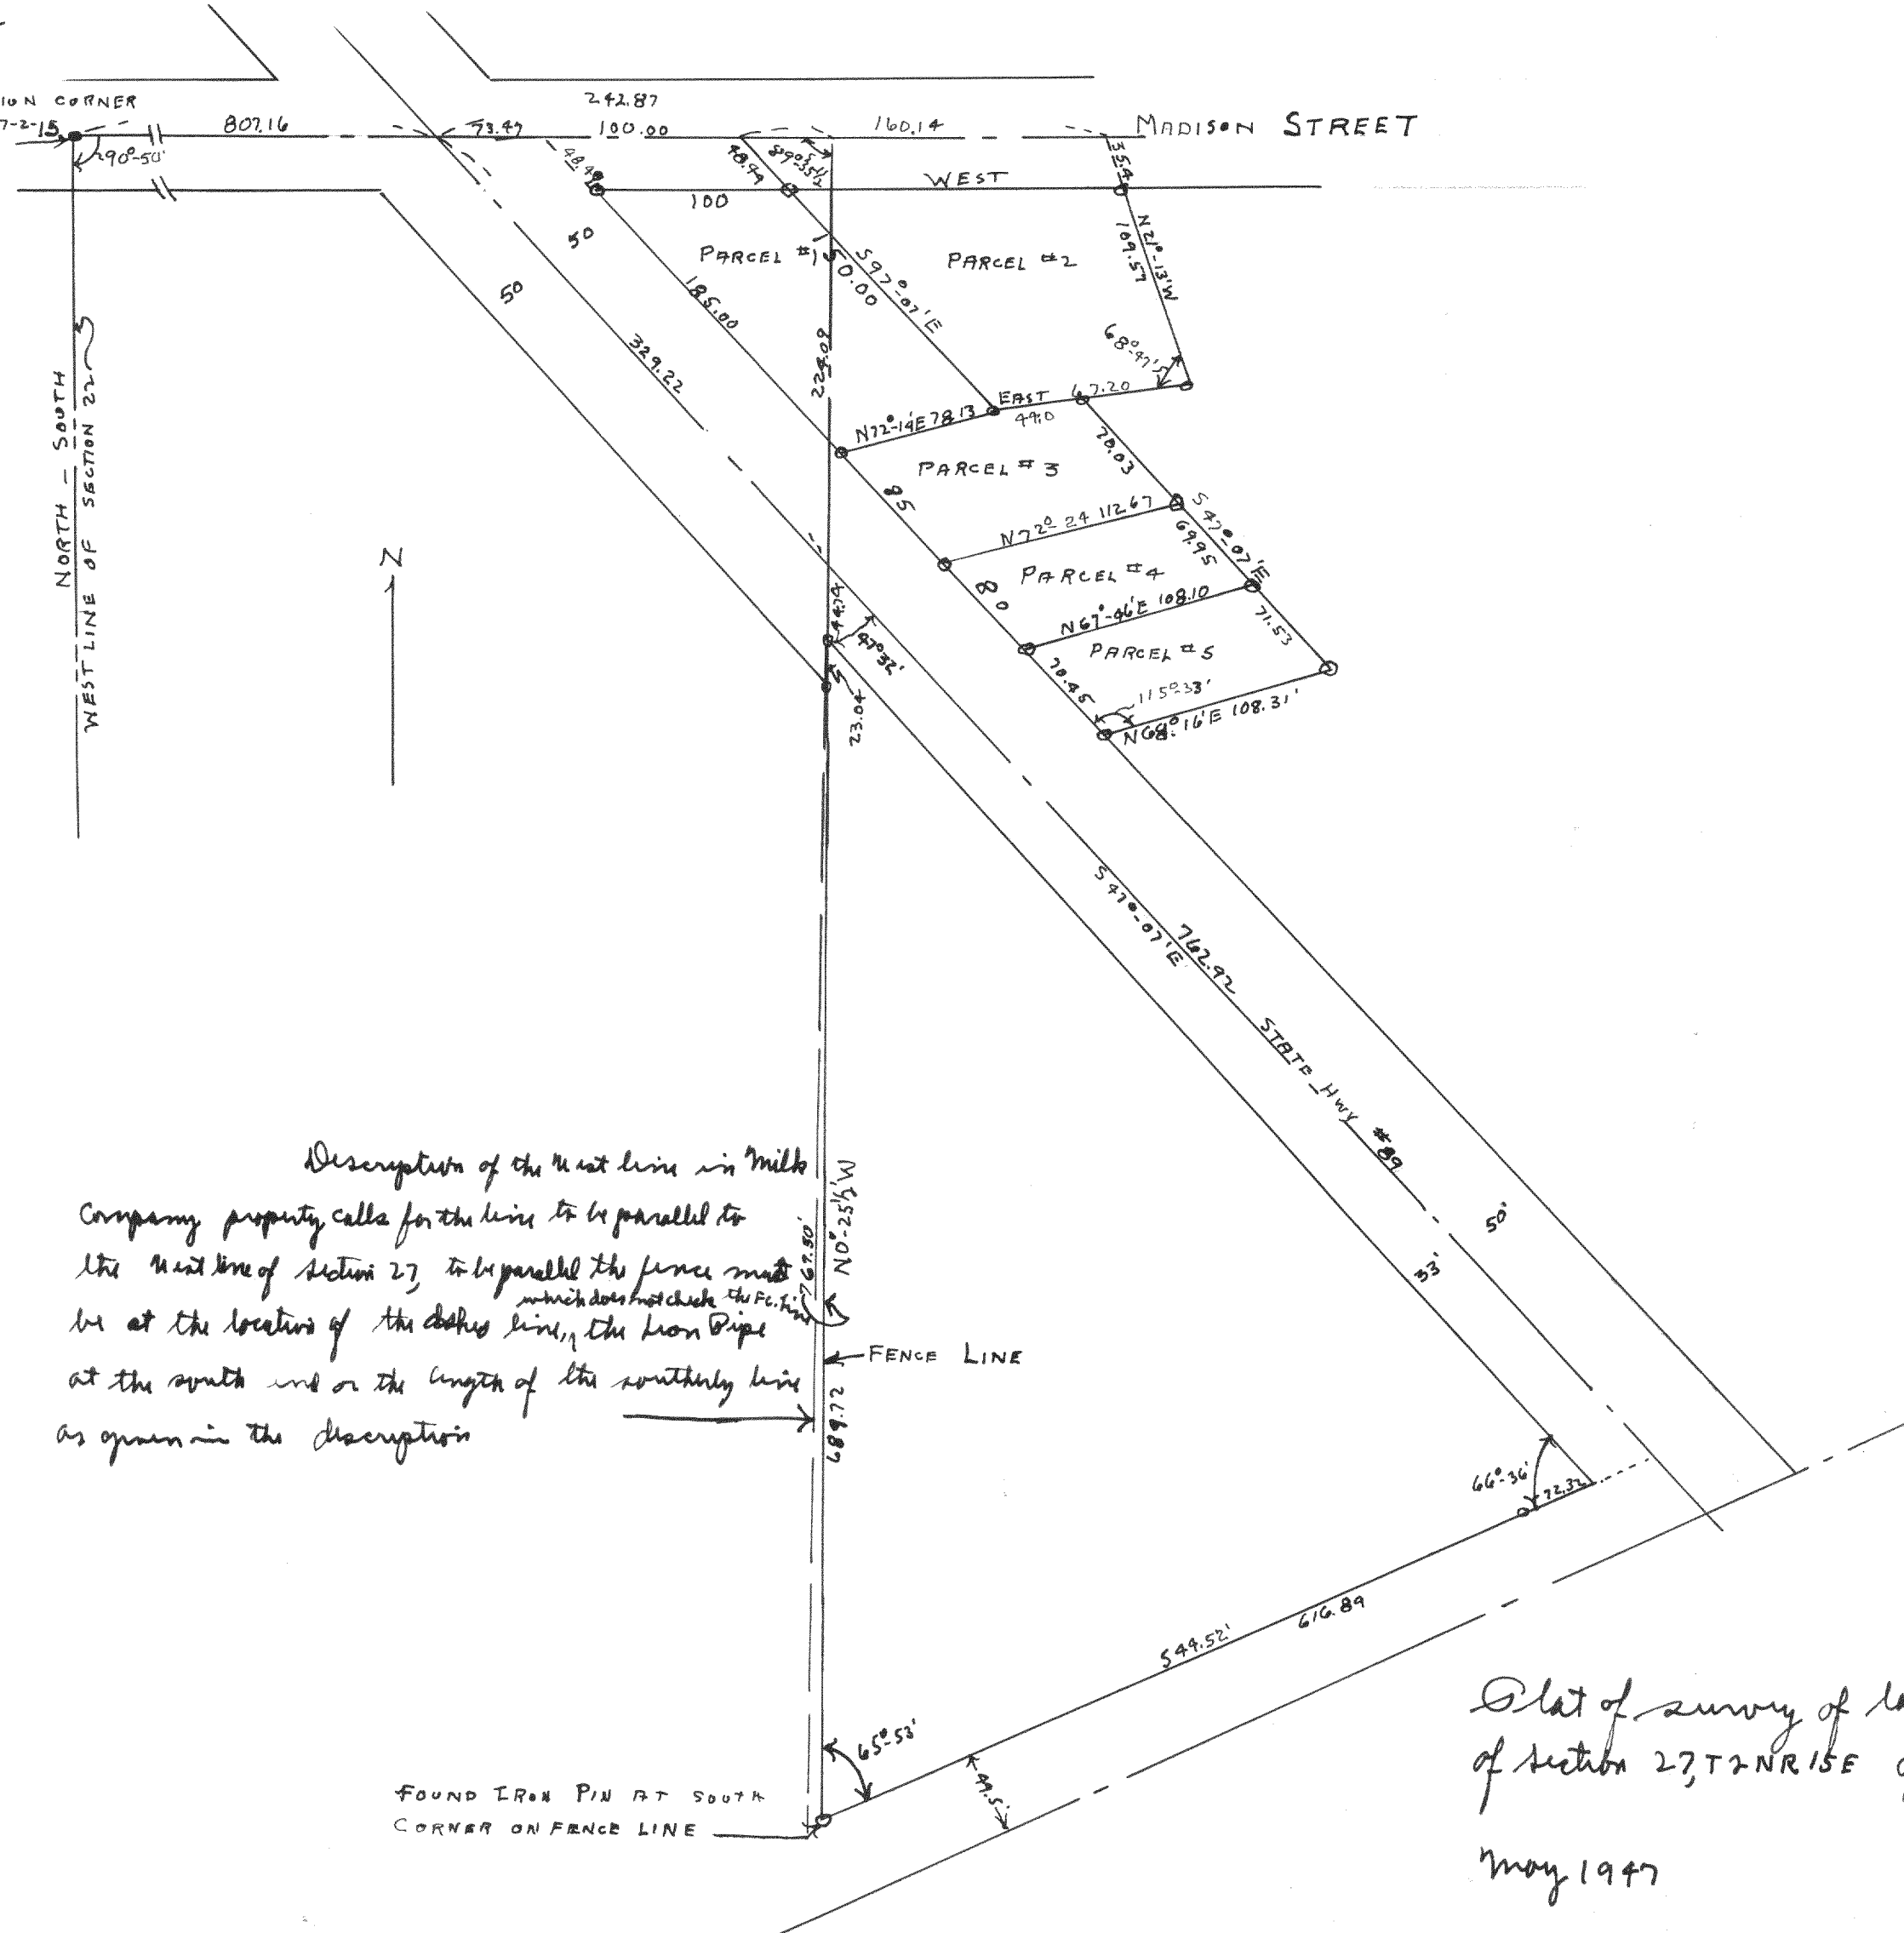

Description of the West line in Milk  
 Company property calls for the line to be parallel to  
 the West line of Section 27, to be parallel the fence line  
 which does not check the F.C.L. in  
 be at the location of the clothes line, the Iron Pipe  
 at the south end or the length of the southerly line  
 as given in the description

FOUND IRON PIN AT SOUTH  
 CORNER ON FENCE LINE

Plot of survey of land located in the southwest 1/4  
 of section 27, T2NR15E of Malworth County Wisconsin

May 1947

Floyd T Jensen  
 County Surveyor