



N 1818

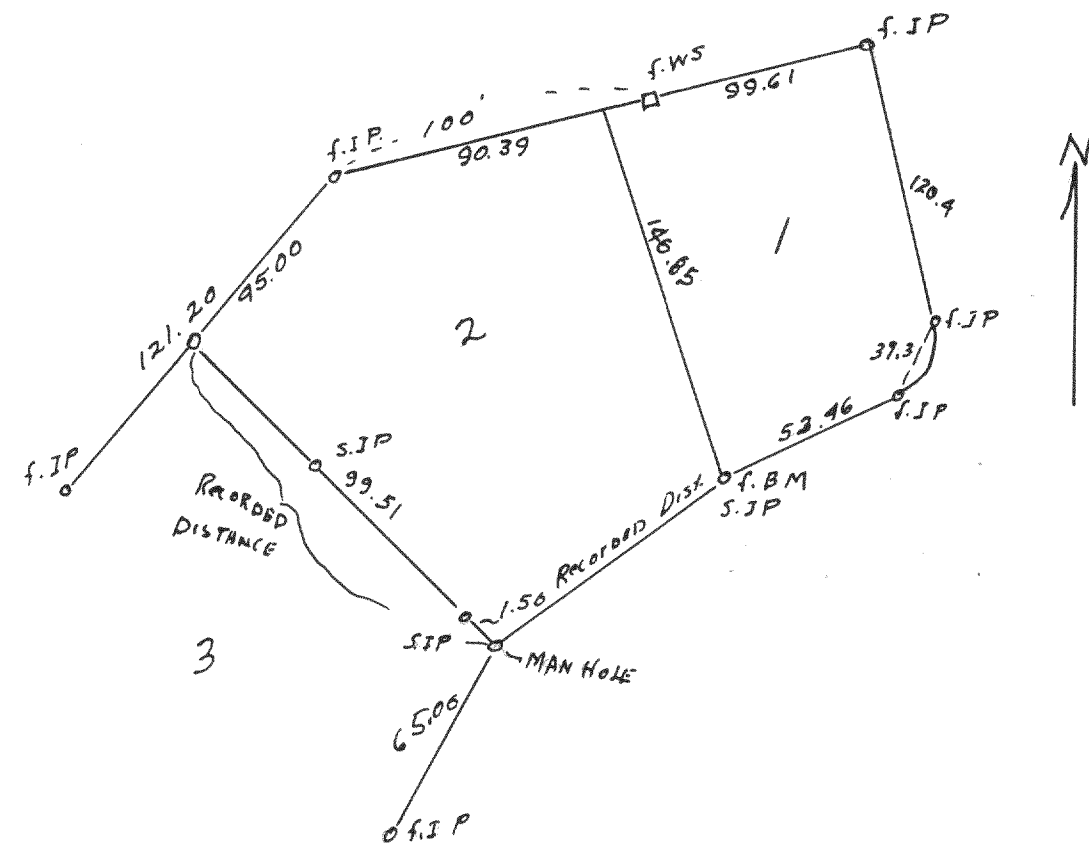

Plat of survey of Lot 2 Block C Country Club Estate in  
 the Village of Fontana, Walworth, County  
 Dec. 10, 1948  
 Lloyd L. Jensen  
 County Surveyor.  
 C.S.

N 1819

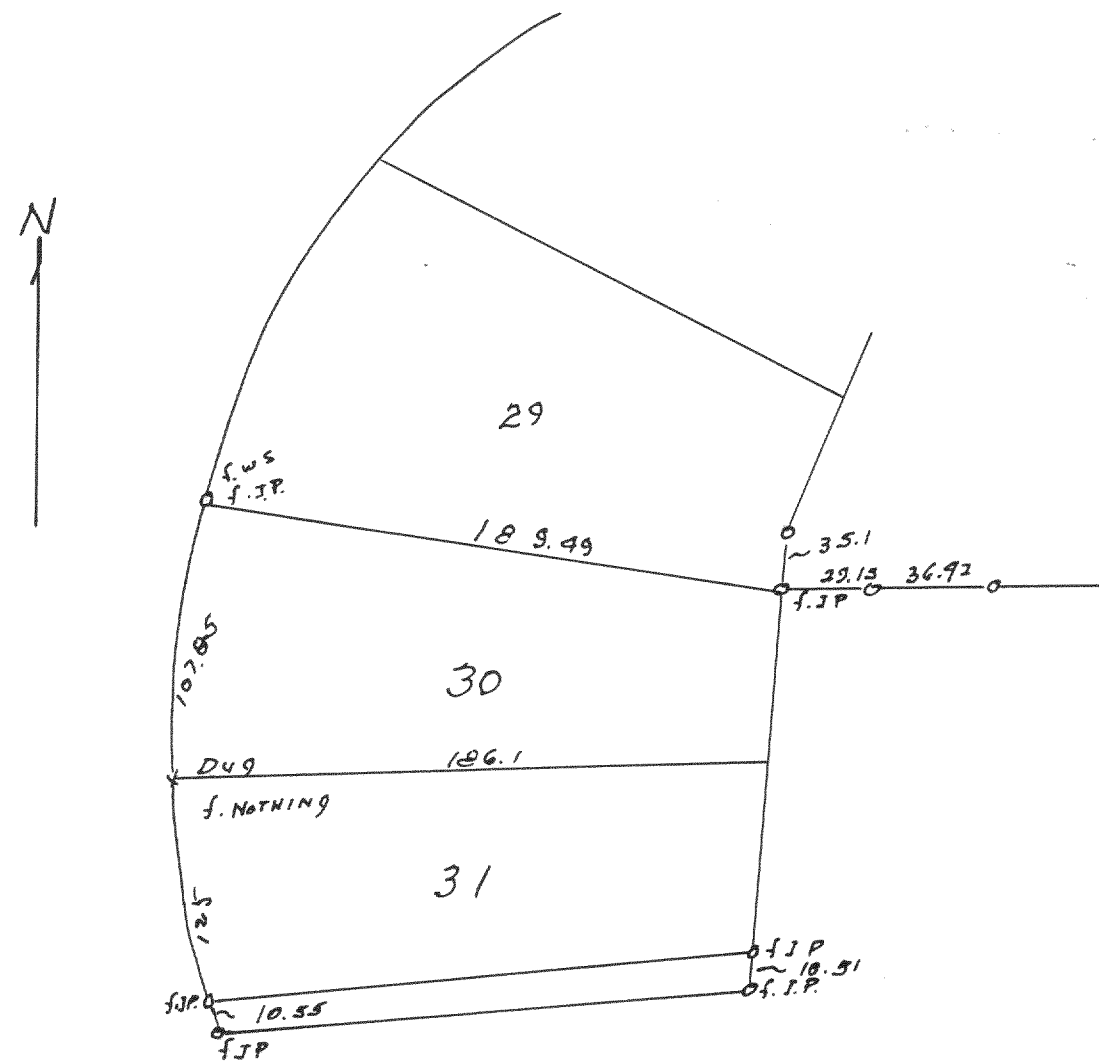

PLAT of Survey of lots 30 + 31 Unit 1 Country Club Estate  
 in the Village of Fontana Walworth, County  
 Dec 21, 1948  
 Lloyd L. Jensen  
 County Surveyor.  
 C.S.