



1846

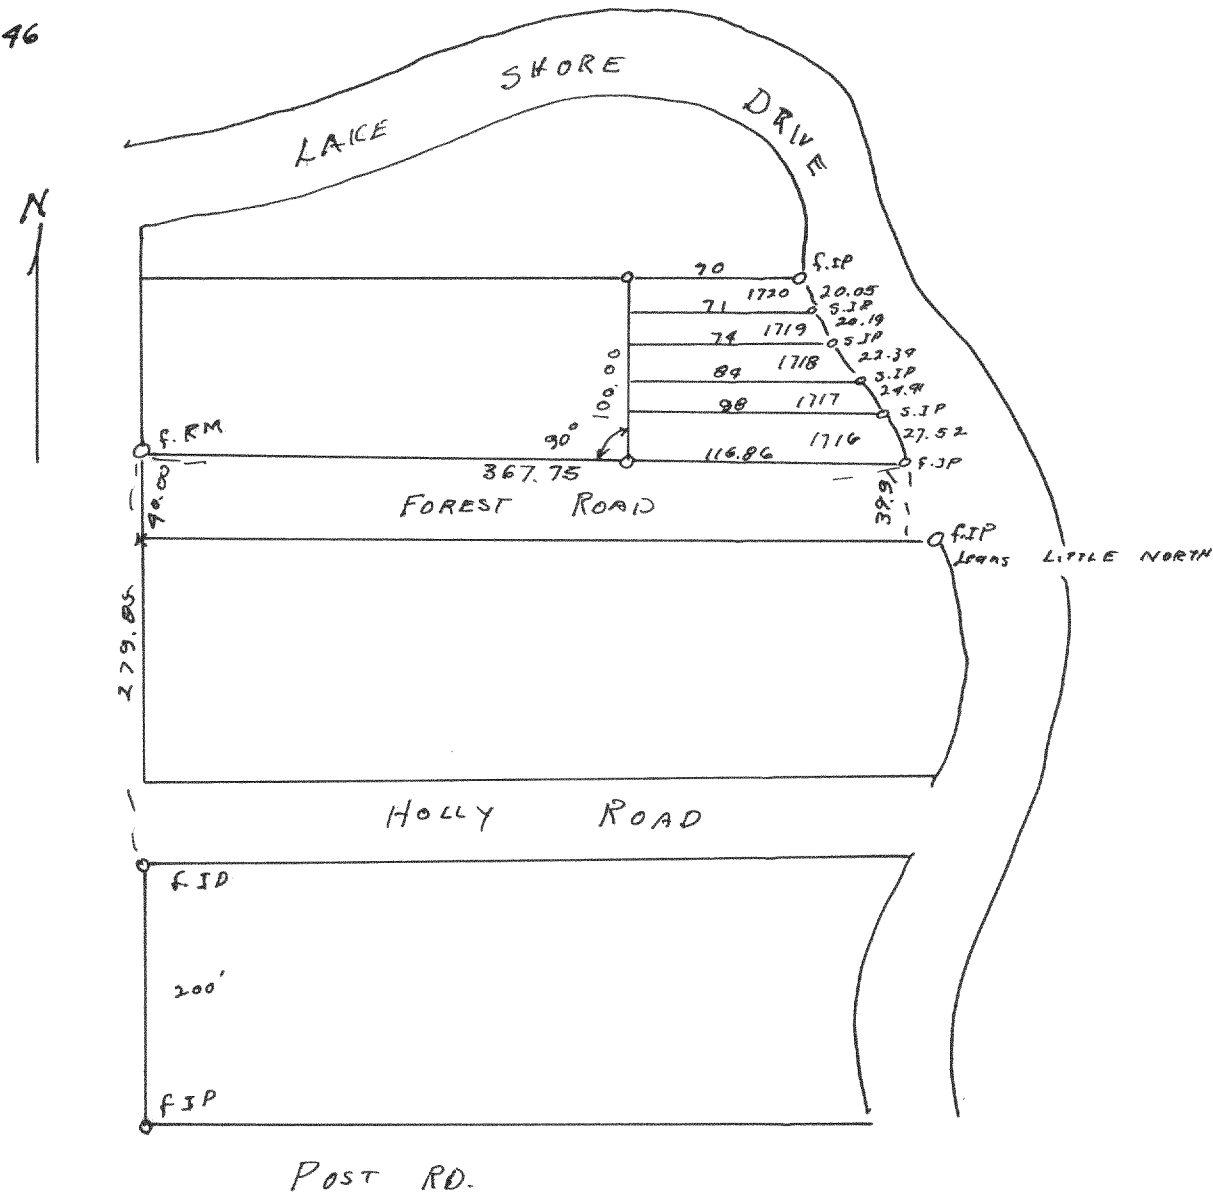


Plot of survey of lots 1716-1720 Pell Lake Subdivision
in TINRIBE Walworth County.
June 4 1948
Lloyd L Jensen
County Surveyor
c.e.

1848

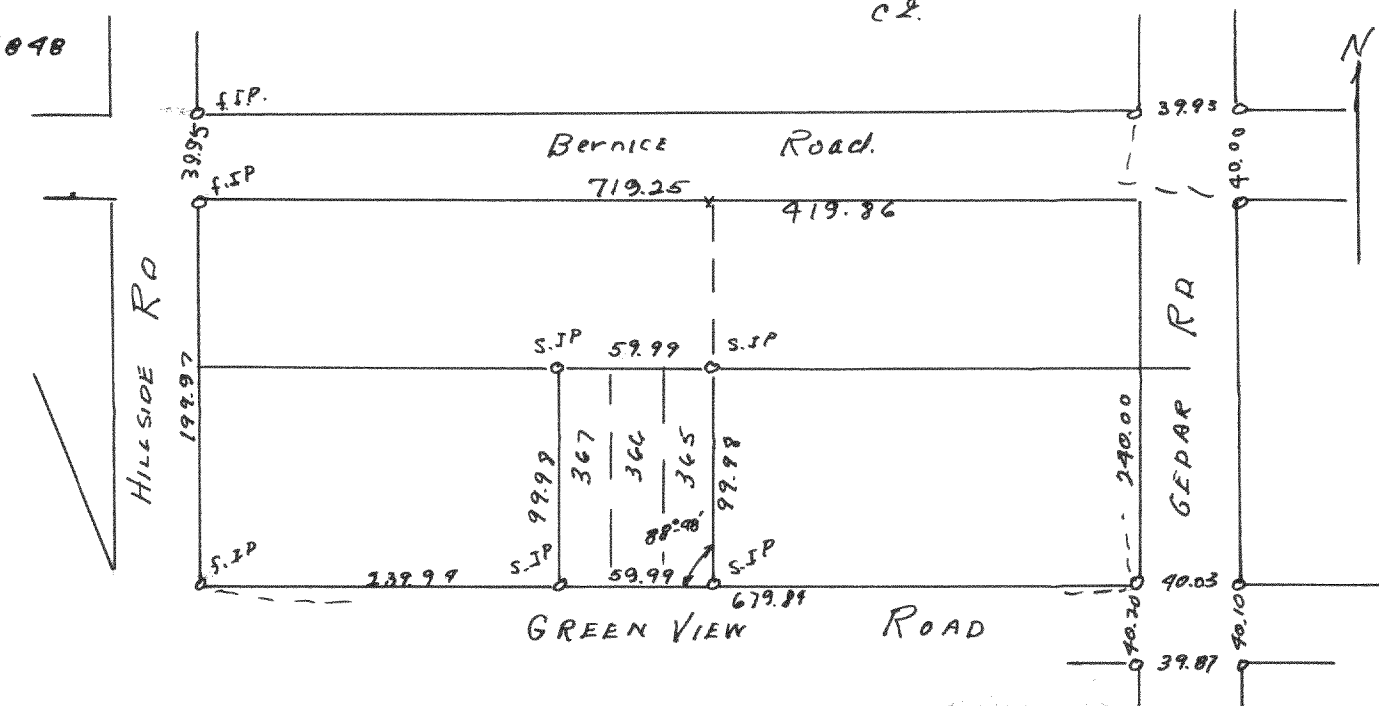


Plot of survey of lots 365-367 Pell Lake Subdivision in TINRIBE
Walworth County
July 27, 1948
Lloyd L Jensen
County Surveyor
c.e.

1847

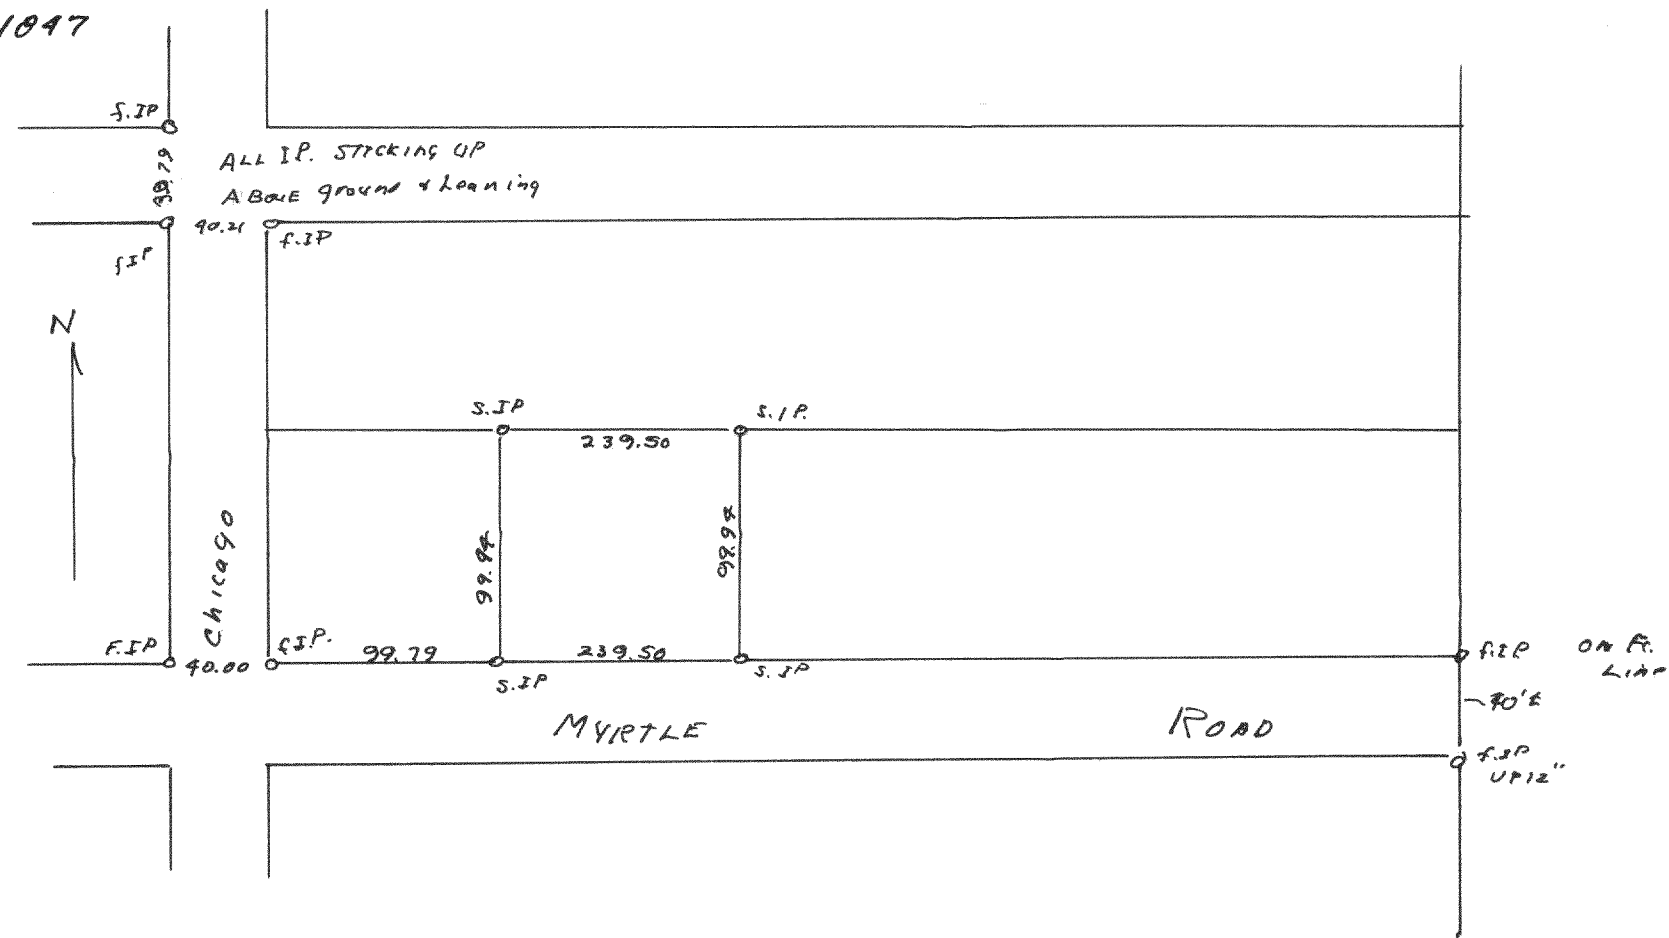

Plot of survey of lots 1025-1036 Pell Lake Addition TINRIBE
Walworth County
June 4, 1948
Lloyd L Jensen
County Surveyor
c.e.

1849

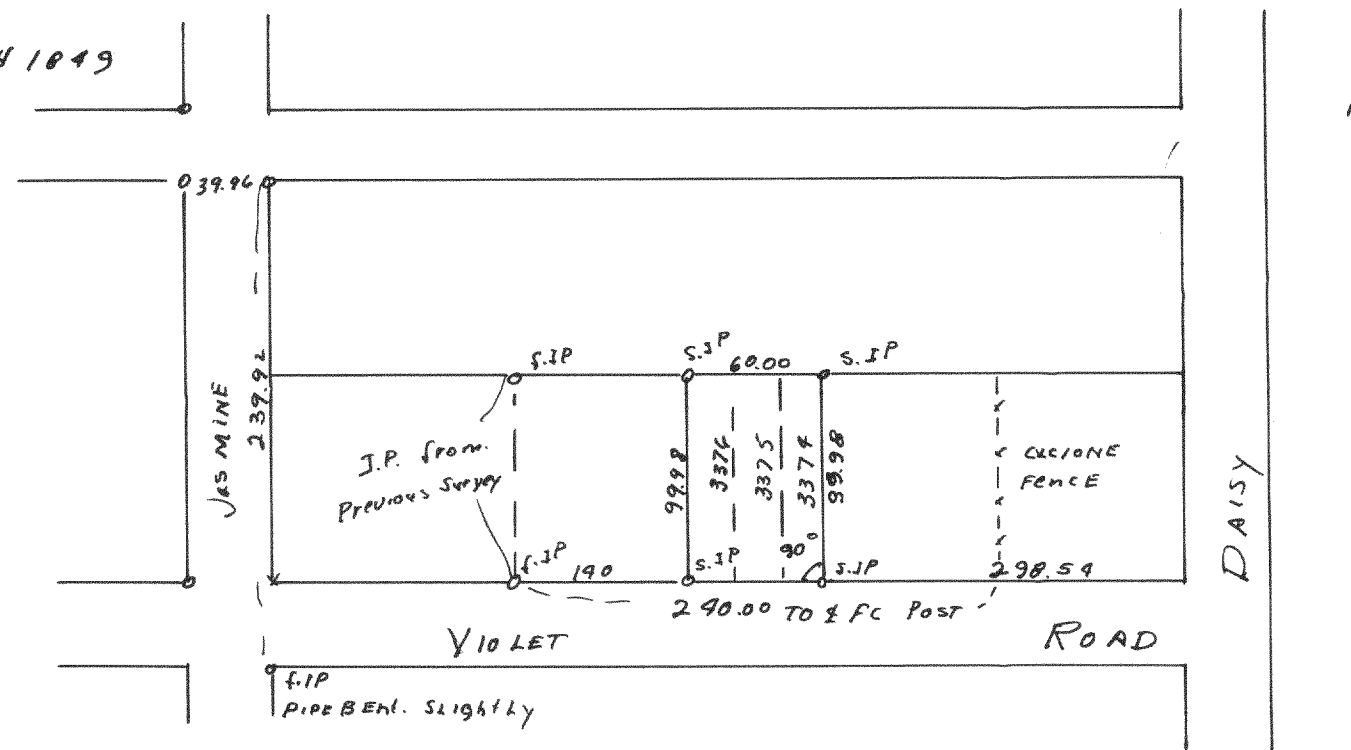

Plot of survey of lots 3374-3376 Section 3 Pell Lake Subdivision
in TINRIBE Walworth County
July 27, 1948
Lloyd L Jensen
County Surveyor
c.e.