



1968

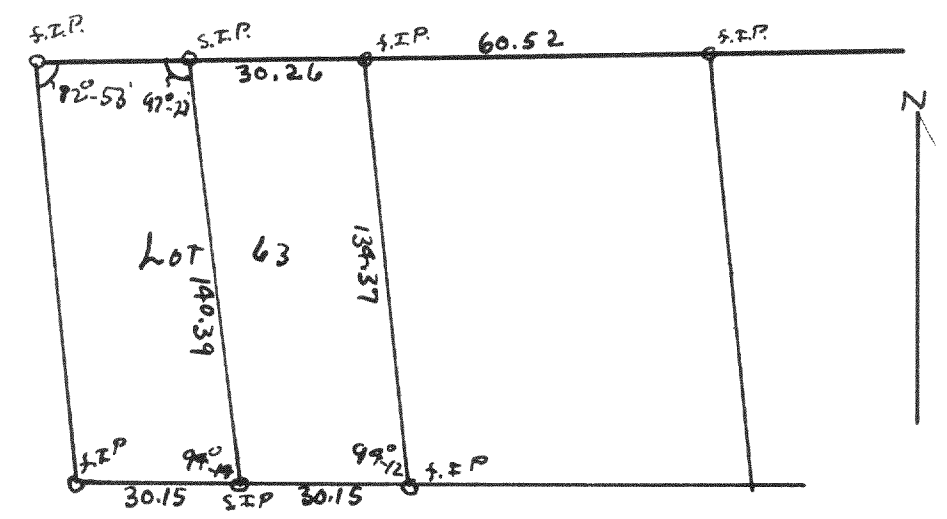


Plot of Lot 63 Lockwoods subdivision in the
 Village of Williams Bay, Walworth County, Wisconsin
 1948
 Lloyd Jensen
 County Surveyor
 LJS

1969

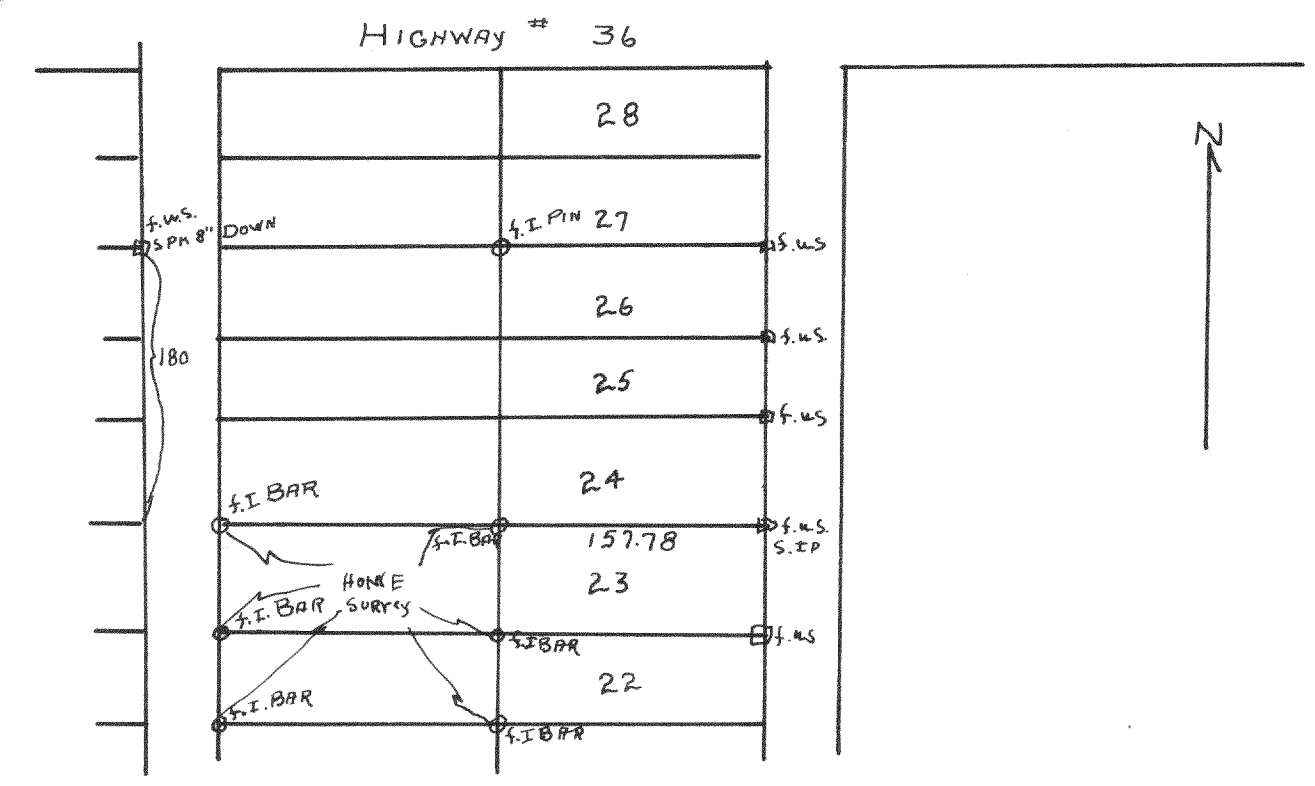


Plot of survey of the south line of Lot 24 Block 3 in Harbor View
 subdivision. Village of Williams Bay, Walworth County, Wisconsin
 Sept 22, 1948
 Lloyd Jensen (LJS)
 County Surveyor

1970

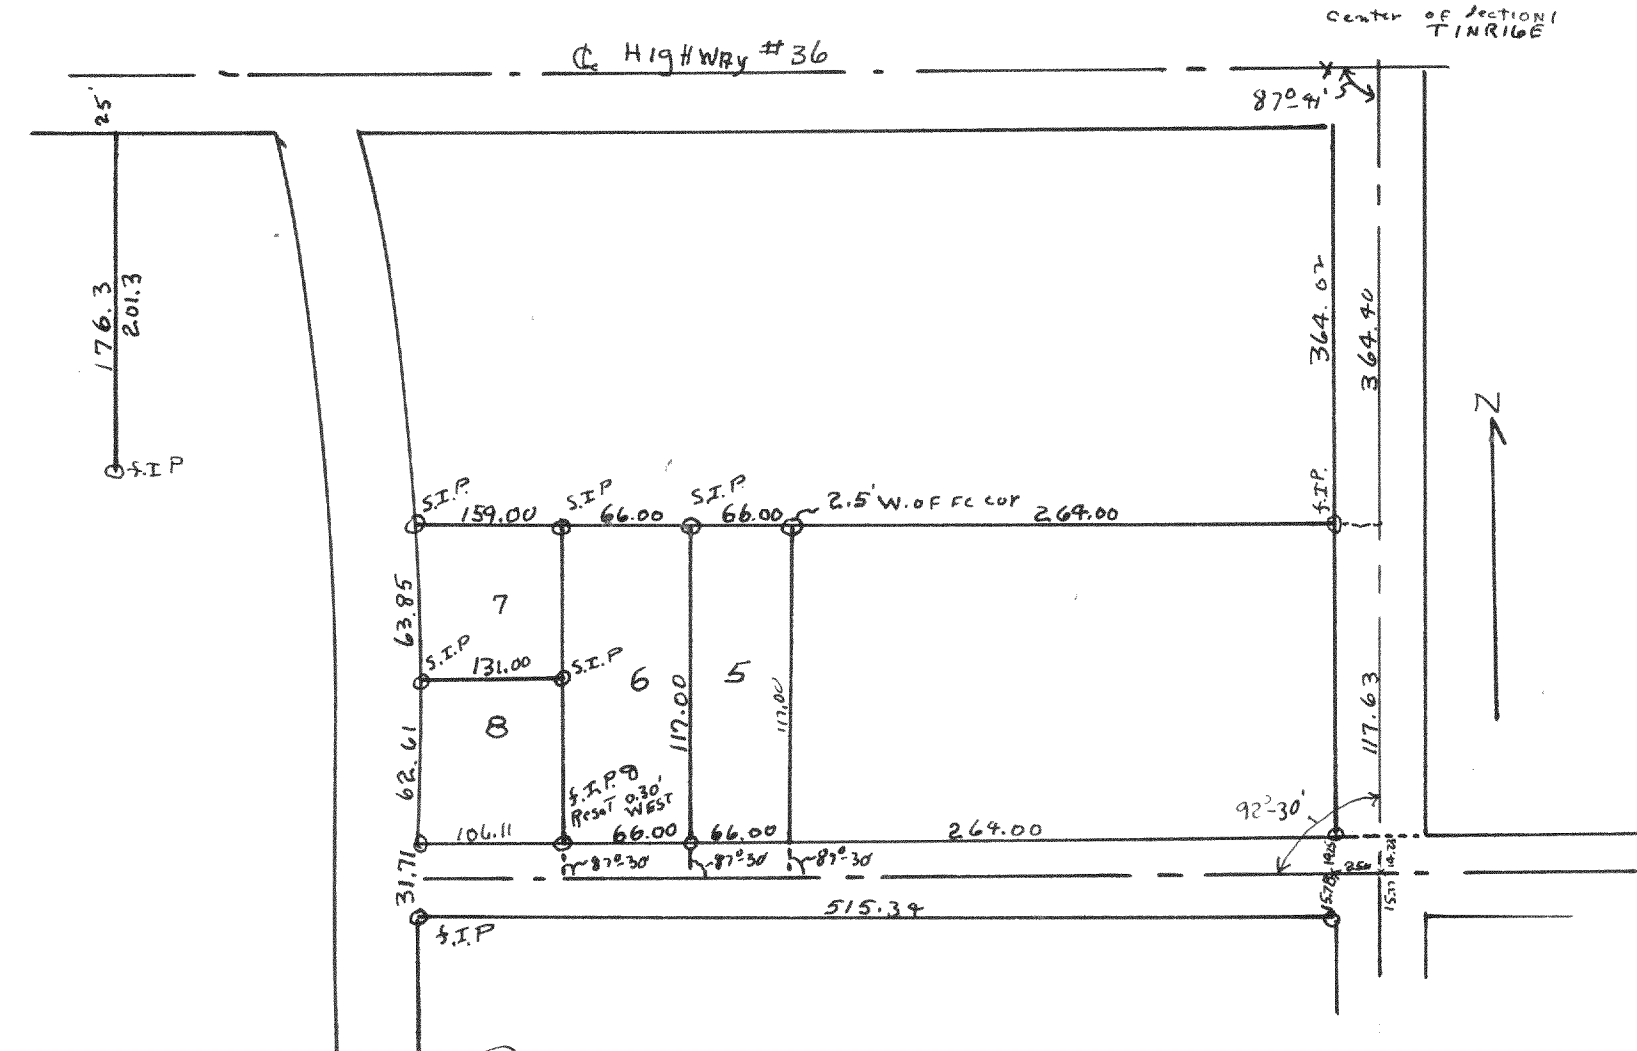

Plot of survey of lots 5, 6, 7, 8 second statutory
 subdivision Williams Bay, Walworth County, Wis
 October 1948
 Lloyd Jensen
 County Surveyor
 LJS

1971

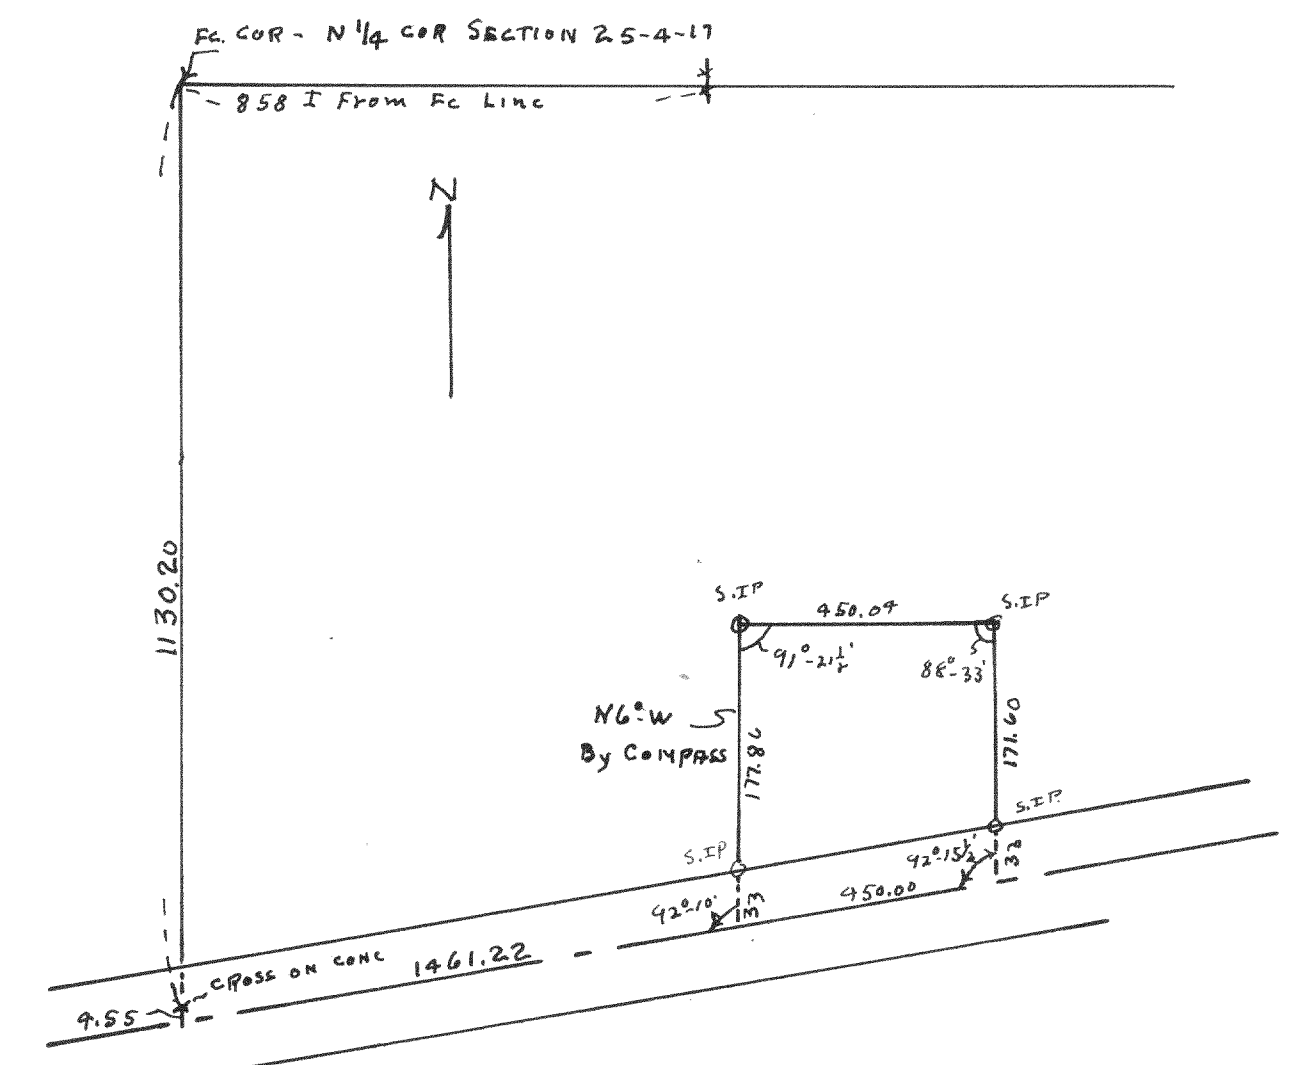

Plot of survey of a parcel of land located in the NE 1/4 of
 Section 25 T9N R1E of Walworth County Wisconsin
 February 17, 1948
 Lloyd Jensen
 County Surveyor
 LJS